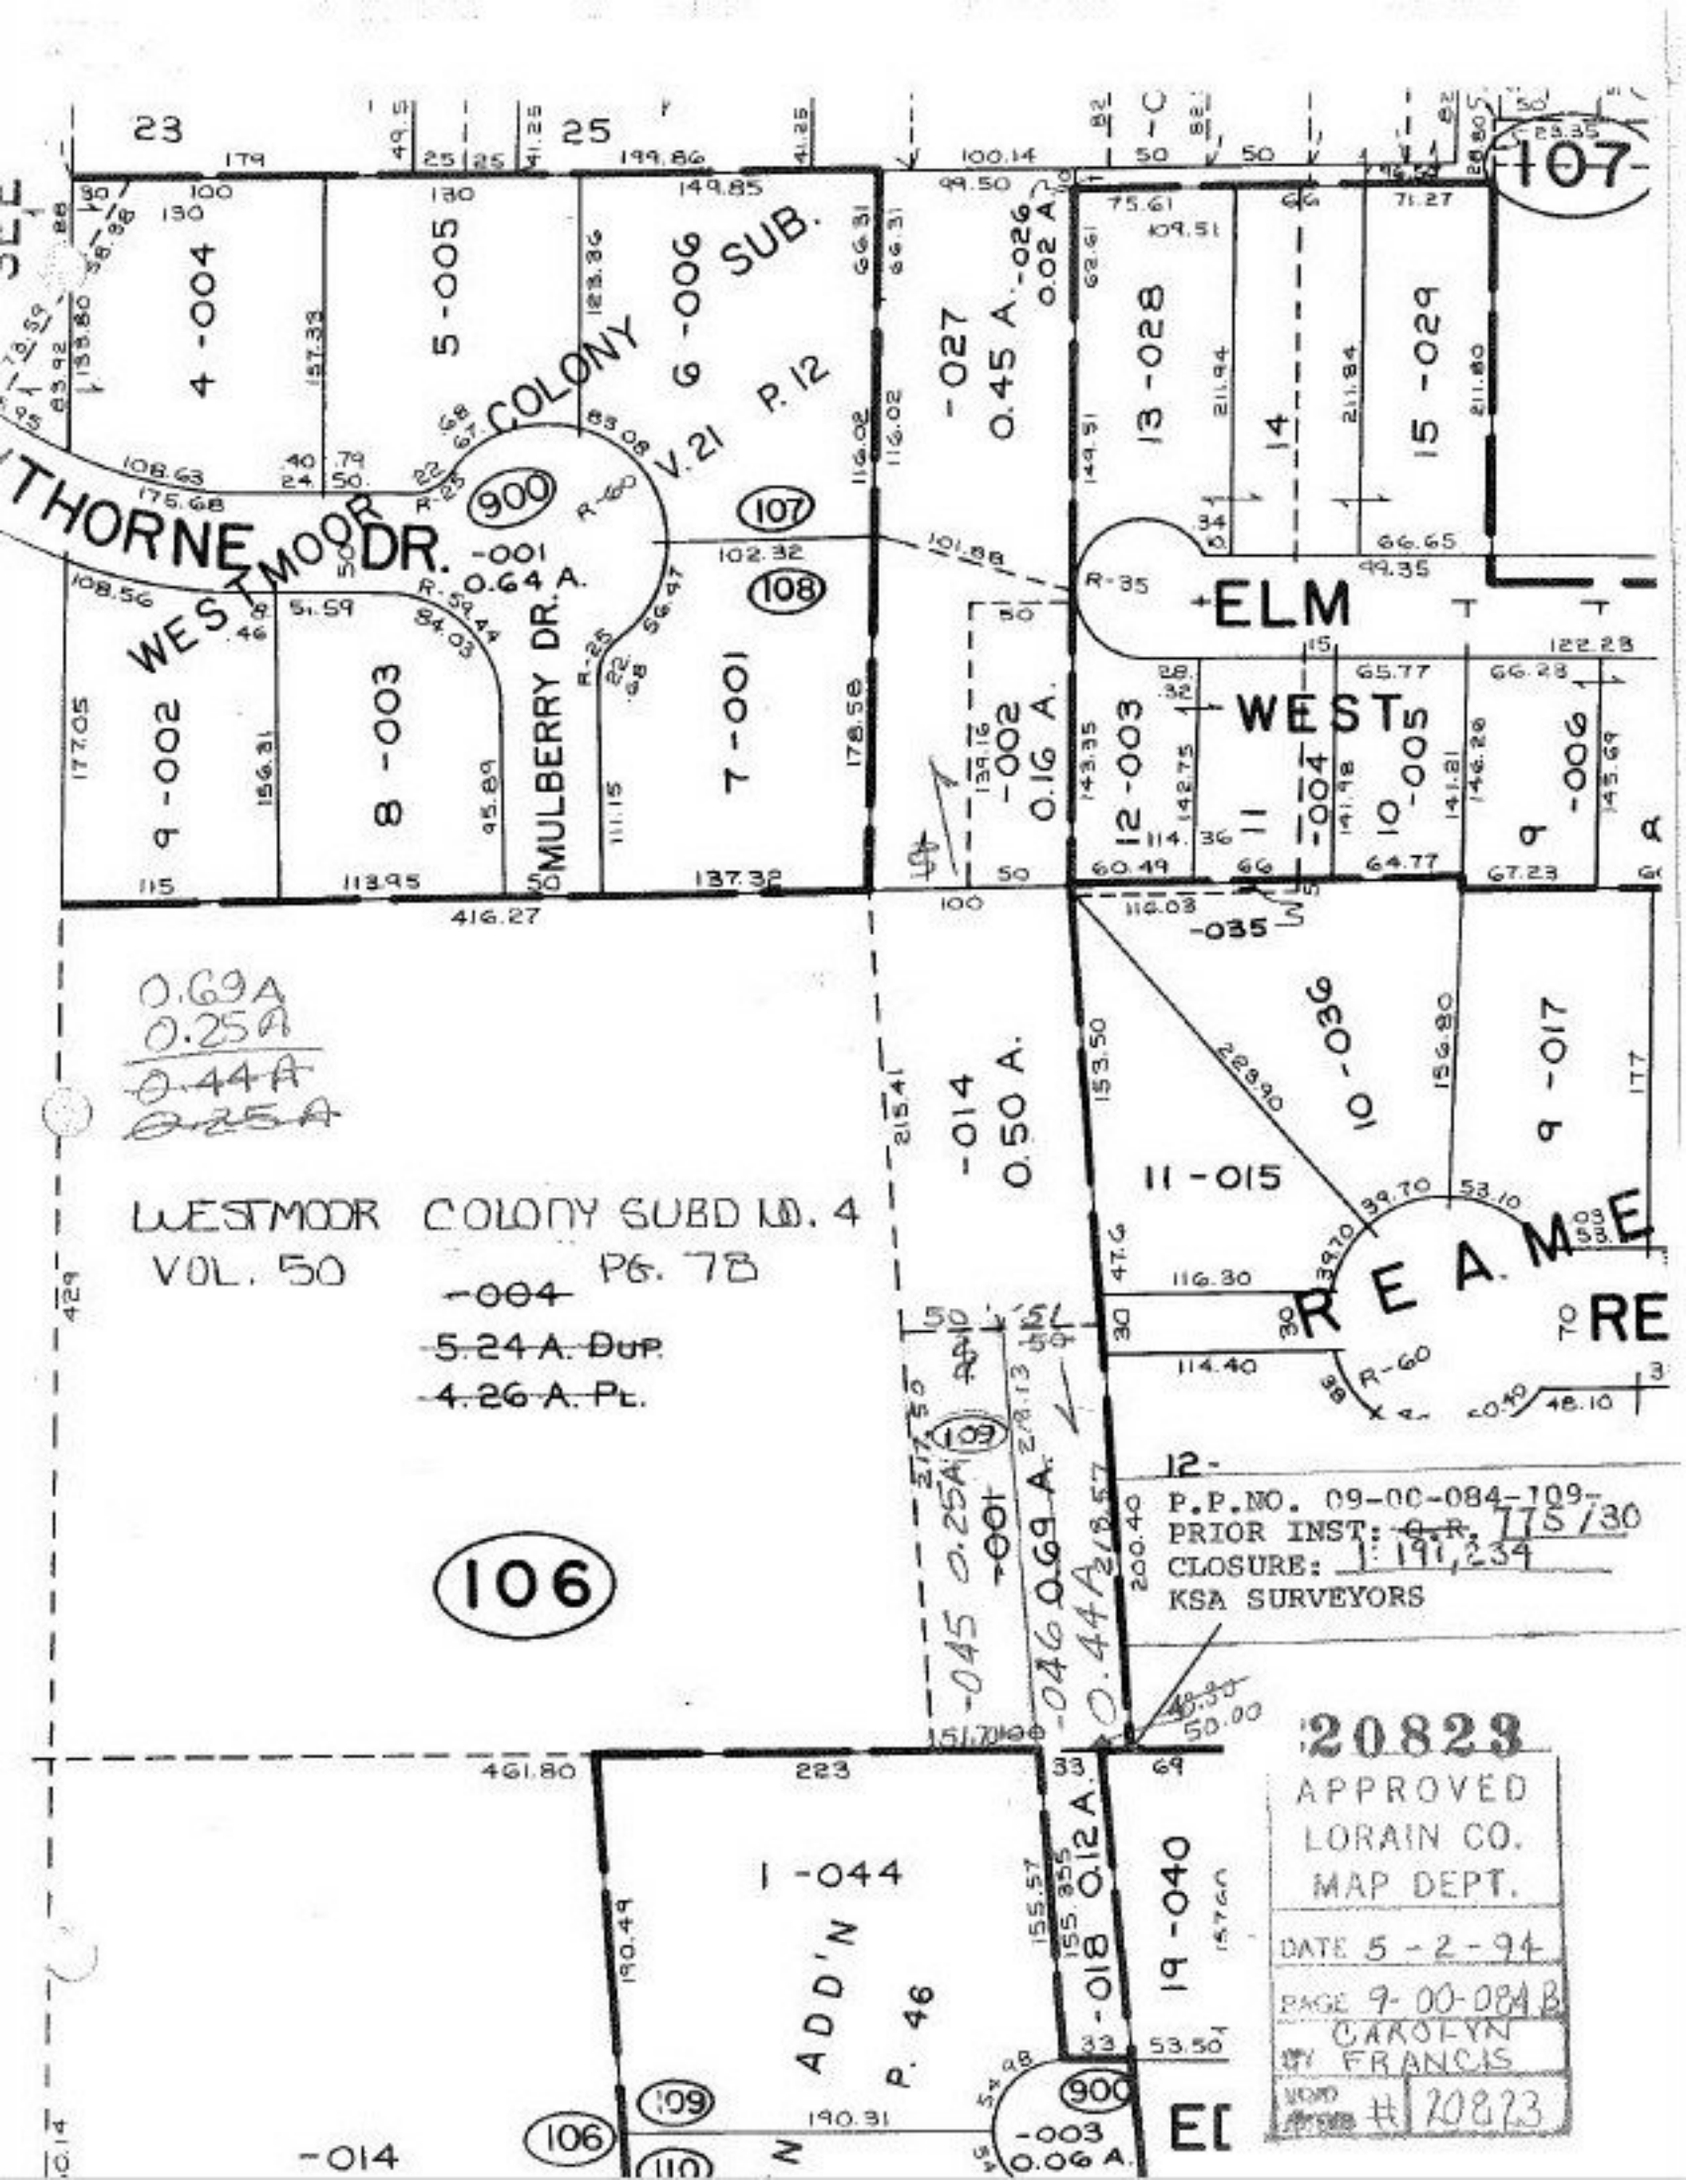
23
25
107
4-004
5-005
6-006
SUB.
COLONY
V.21 P.12
-027
0.45 A.
-026
0.02 A.
13-028
14
15-029
THORNE
WESTMOOR DR.
-001
0.64 A.
900
107
108
ELM
WEST
9-002
8-003
7-001
MULBERRY DR.
-002
0.16 A.
12-003
11
-004
10-005
9-006
-035
10-036
9-017
-014
0.50 A.
11-015
REAME
RE
0.69A
0.25A
0.44A
0.25A
WESTMOOR COLONY SUBD NO. 4
VOL. 50 PG. 78
-004
5.24 A. DUP.
4.26 A. PL.
106
109
-001
0.69 A.
-045 0.25A
-046 0.44A
12-
P.P.NO. 09-00-084-109
PRIOR INST: O.R. 175/30
CLOSURE: 191,234
KSA SURVEYORS
1-044
N ADD'N
P. 46
-018 0.12A.
19-040
-003
0.06 A.
110
-014
20823
APPROVED
LORAIN CO.
MAP DEPT.
DATE 5-2-94
PAGE 9-00-084.B
CAROLYN
BY FRANCIS
VOID # 20823