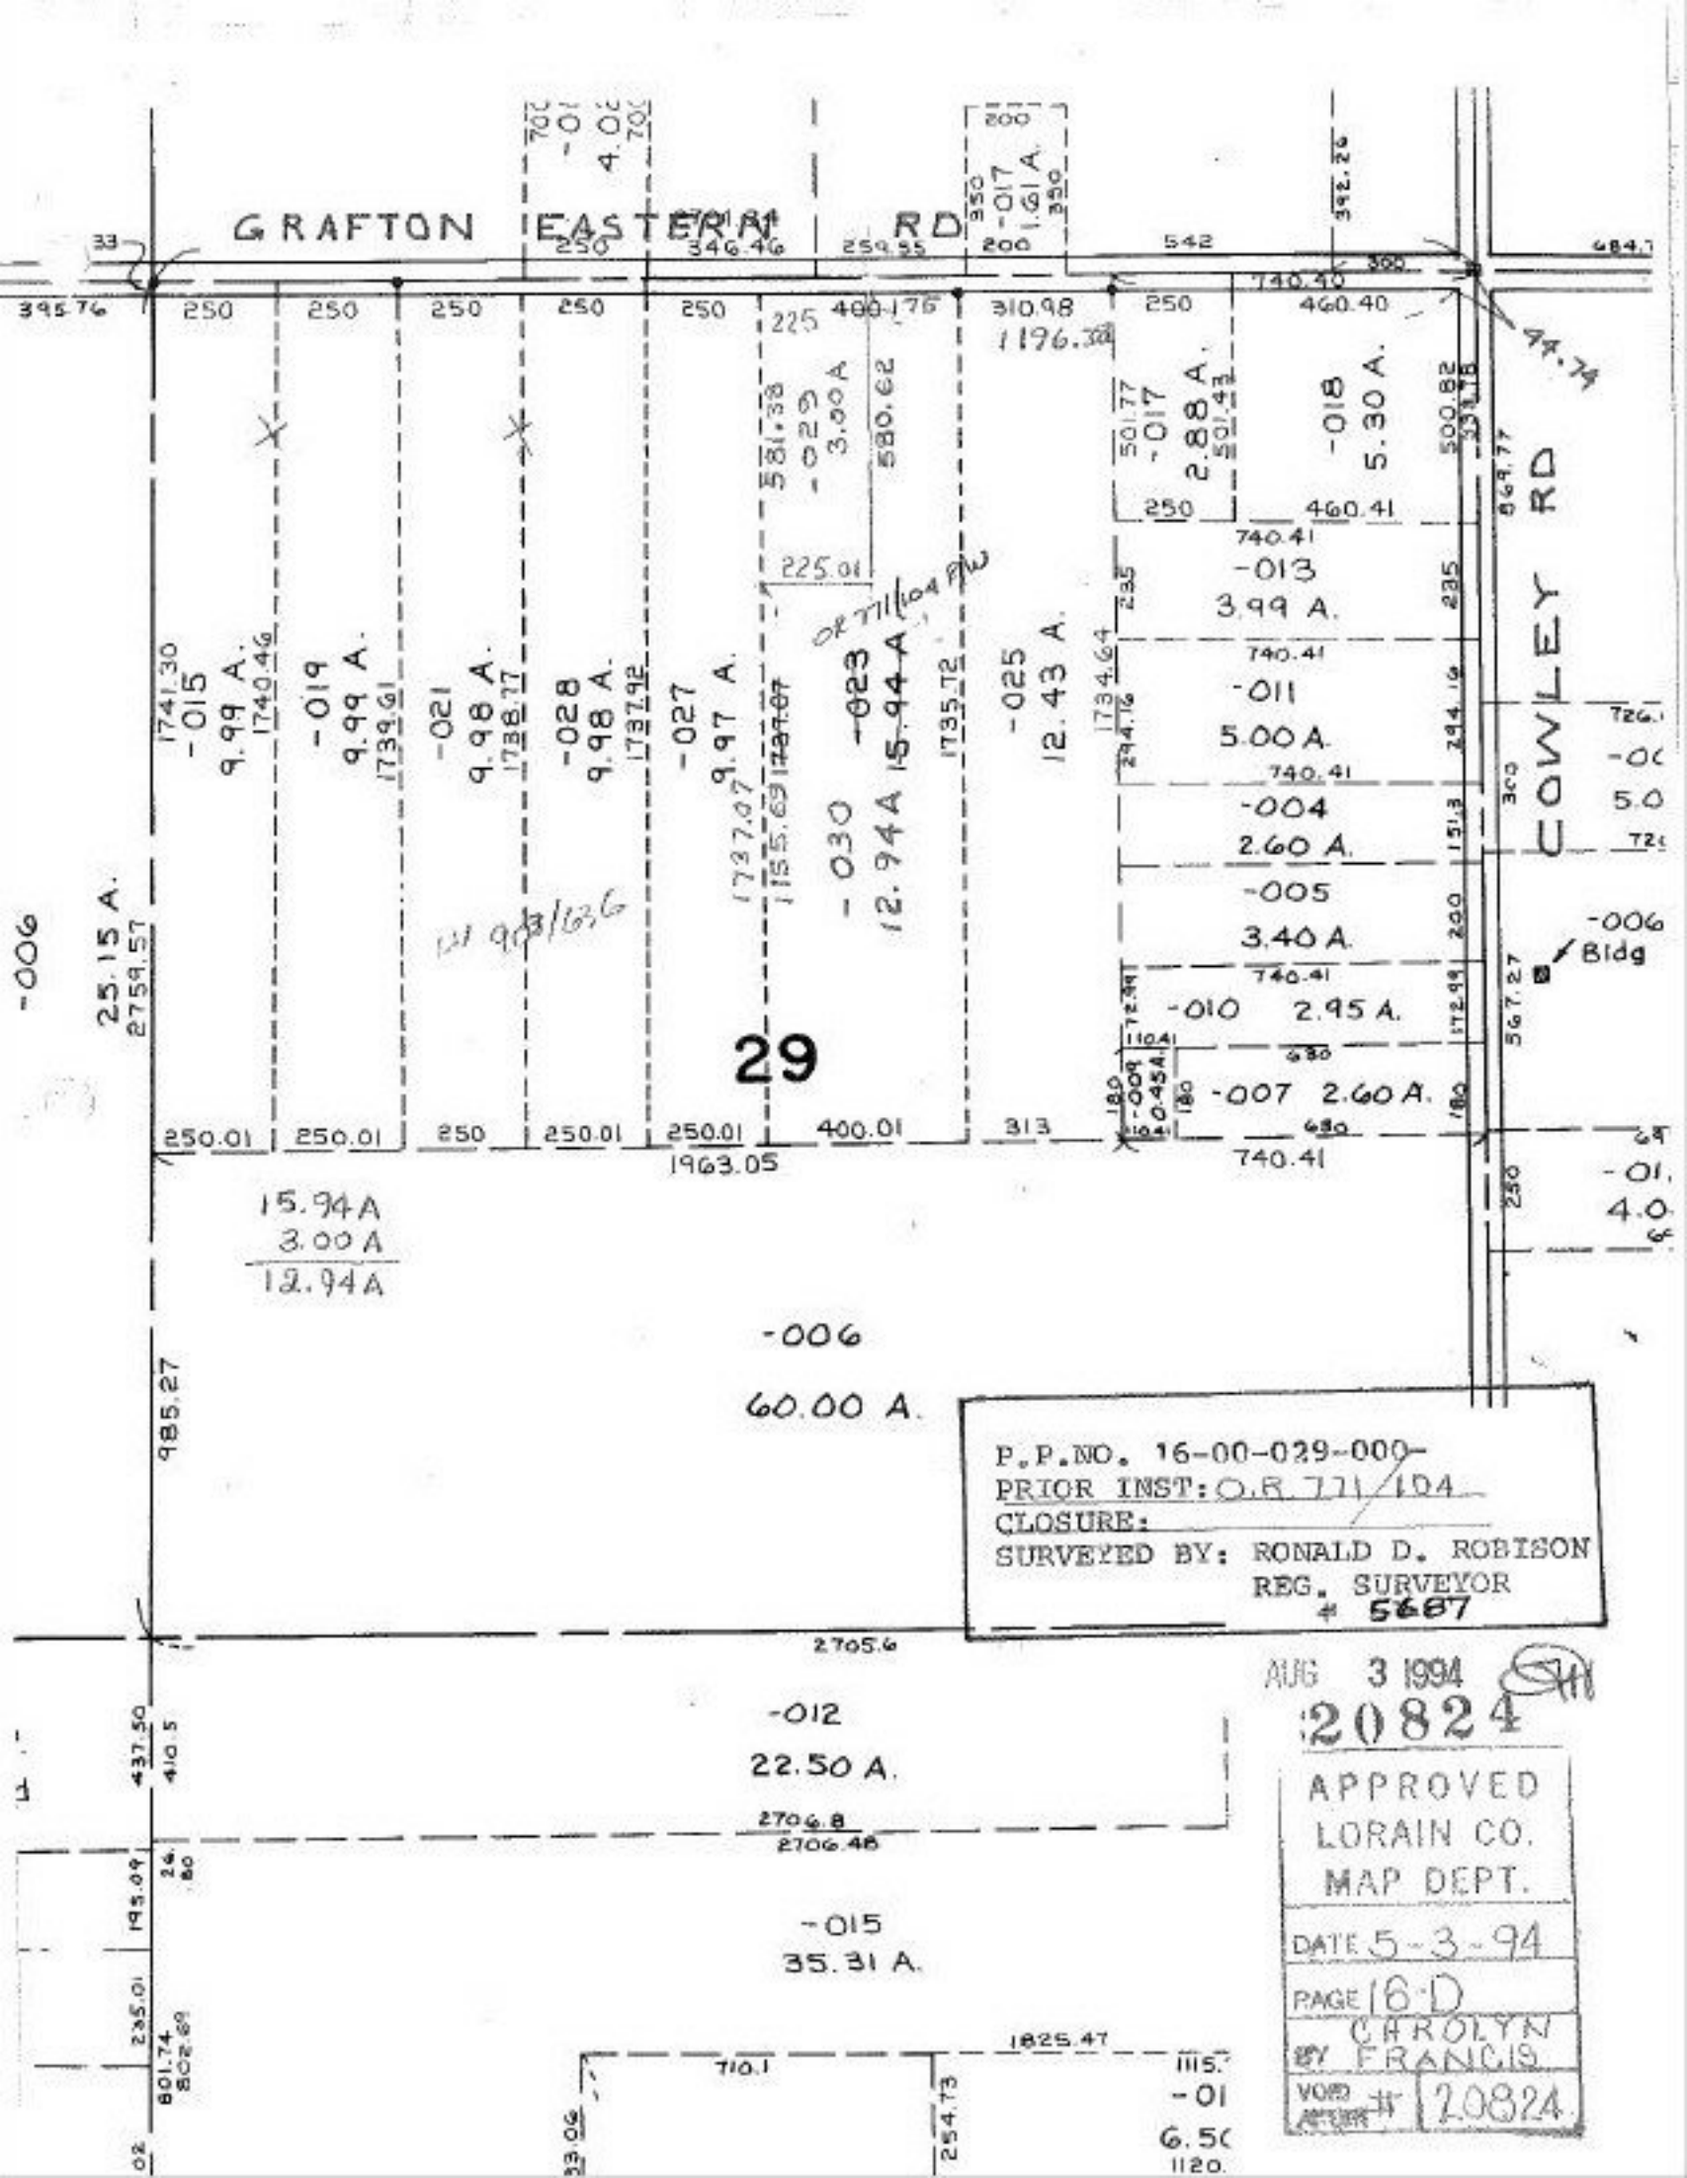
GRAFTON EASTERN RD
COWLEY RD
-015
9.99 A.
-019
9.99 A.
-021
9.98 A.
-028
9.98 A.
-027
9.97 A.
-029
3.00 A.
-030
12.94 A.
-023
15.94 A.
-025
12.43 A.
-017
2.88 A.
-018
5.30 A.
-013
3.99 A.
-011
5.00 A.
-004
2.60 A.
-005
3.40 A.
-010
2.95 A.
-007
2.60 A.
-006
Bldg
29
25.15 A.
-006
60.00 A.
-012
22.50 A.
-015
35.31 A.
15.94A
3.00A
12.94A
P.P.NO. 16-00-029-000
PRIOR INST: O.R. 771/104
CLOSURE:
SURVEYED BY: RONALD D. ROBISON
REG. SURVEYOR
5687
AUG 3 1994
20824
APPROVED
LORAIN CO.
MAP DEPT.
DATE 5-3-94
PAGE 16-D
BY CAROLYN FRANCIS
VOID AFFIDAVIT # 20824