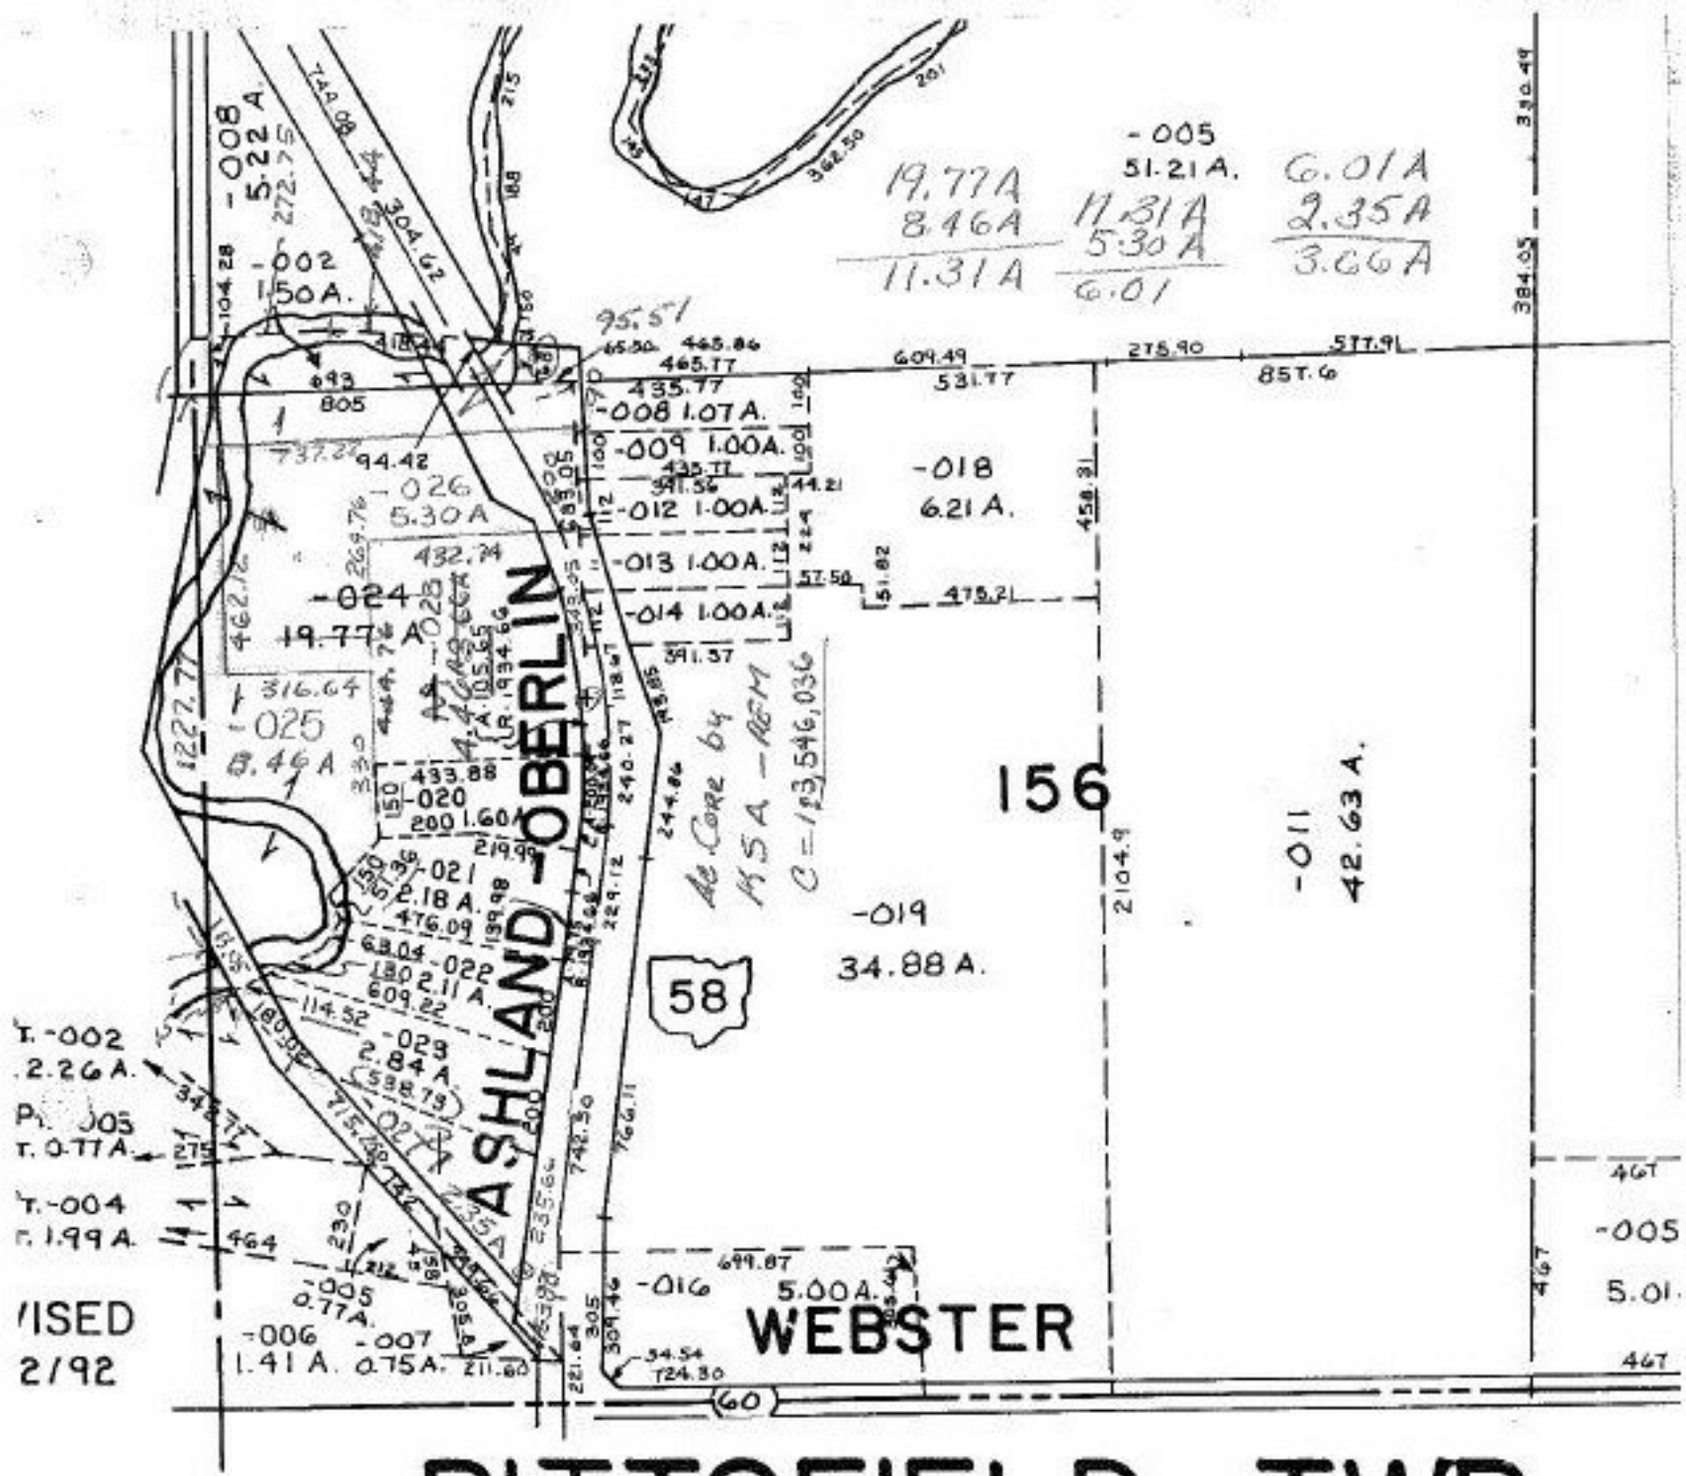

14-G

SCALE 1" = 400'

AUG 2 1994

20825

P.P.NO. 14-00-156-000-
PRIOR INST: O.R.890/121
CLOSURE:
KSA SURVEYORS

APPROVED
LORAIN CO.
MAP DEPT.
DATE 5-3-94
PAGE 14-G
BY CAROLYN FRANCIS
VOID AFTER # 20825