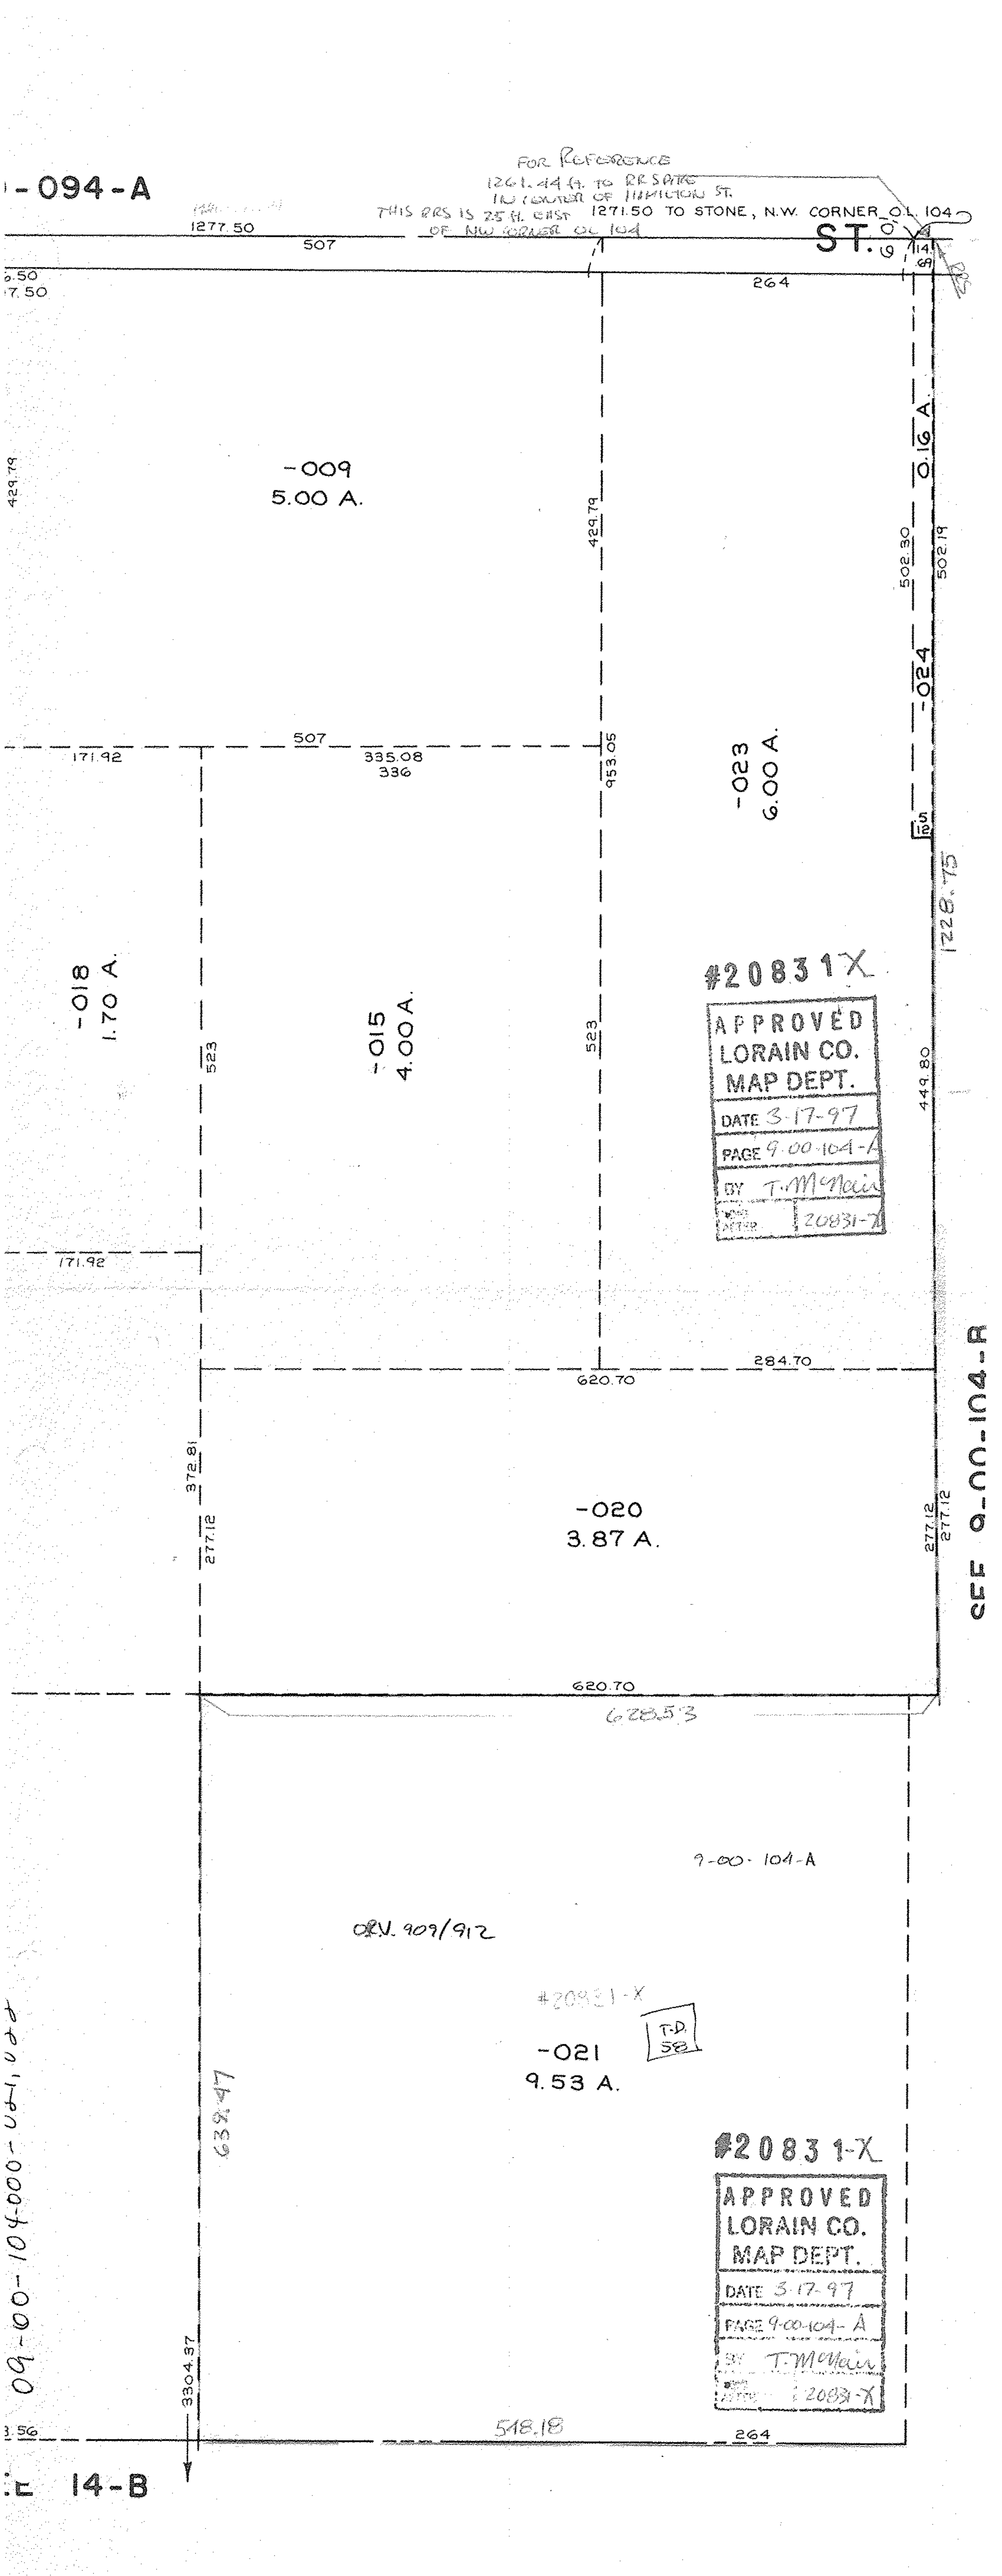

-094-A
FOR REFERENCE
1261.44 ft. TO RR SPIKE
IN CENTER OF HAMILTON ST.
THIS RRS IS 25 ft. EAST
OF NW CORNER OL 104
1271.50 TO STONE, N.W. CORNER O.L. 104
ST.
1277.50
507
264
-009
5.00 A.
429.79
0.16 A.
502.30
502.19
-024
507
171.92
335.08
336
953.05
-023
6.00 A.
1228.75
-018
1.70 A.
523
-015
4.00 A.
523
449.80
#20831X
APPROVED
LORAIN CO.
MAP DEPT.
DATE 3-17-97
PAGE 9-00-104-A
BY T. McNair
20831-X
171.92
284.70
620.70
372.81
277.12
-020
3.87 A.
277.12
277.12
SEE 9-00-104-B
620.70
628.53
9-00-104-A
O.R.V. 909/912
#20831-X
T.D. 58
-021
9.53 A.
639.47
#20831-X
APPROVED
LORAIN CO.
MAP DEPT.
DATE 3-17-97
PAGE 9-00-104-A
BY T. McNair
20831-X
09-00-104-000-021,022
3304.37
548.18
264
14-B