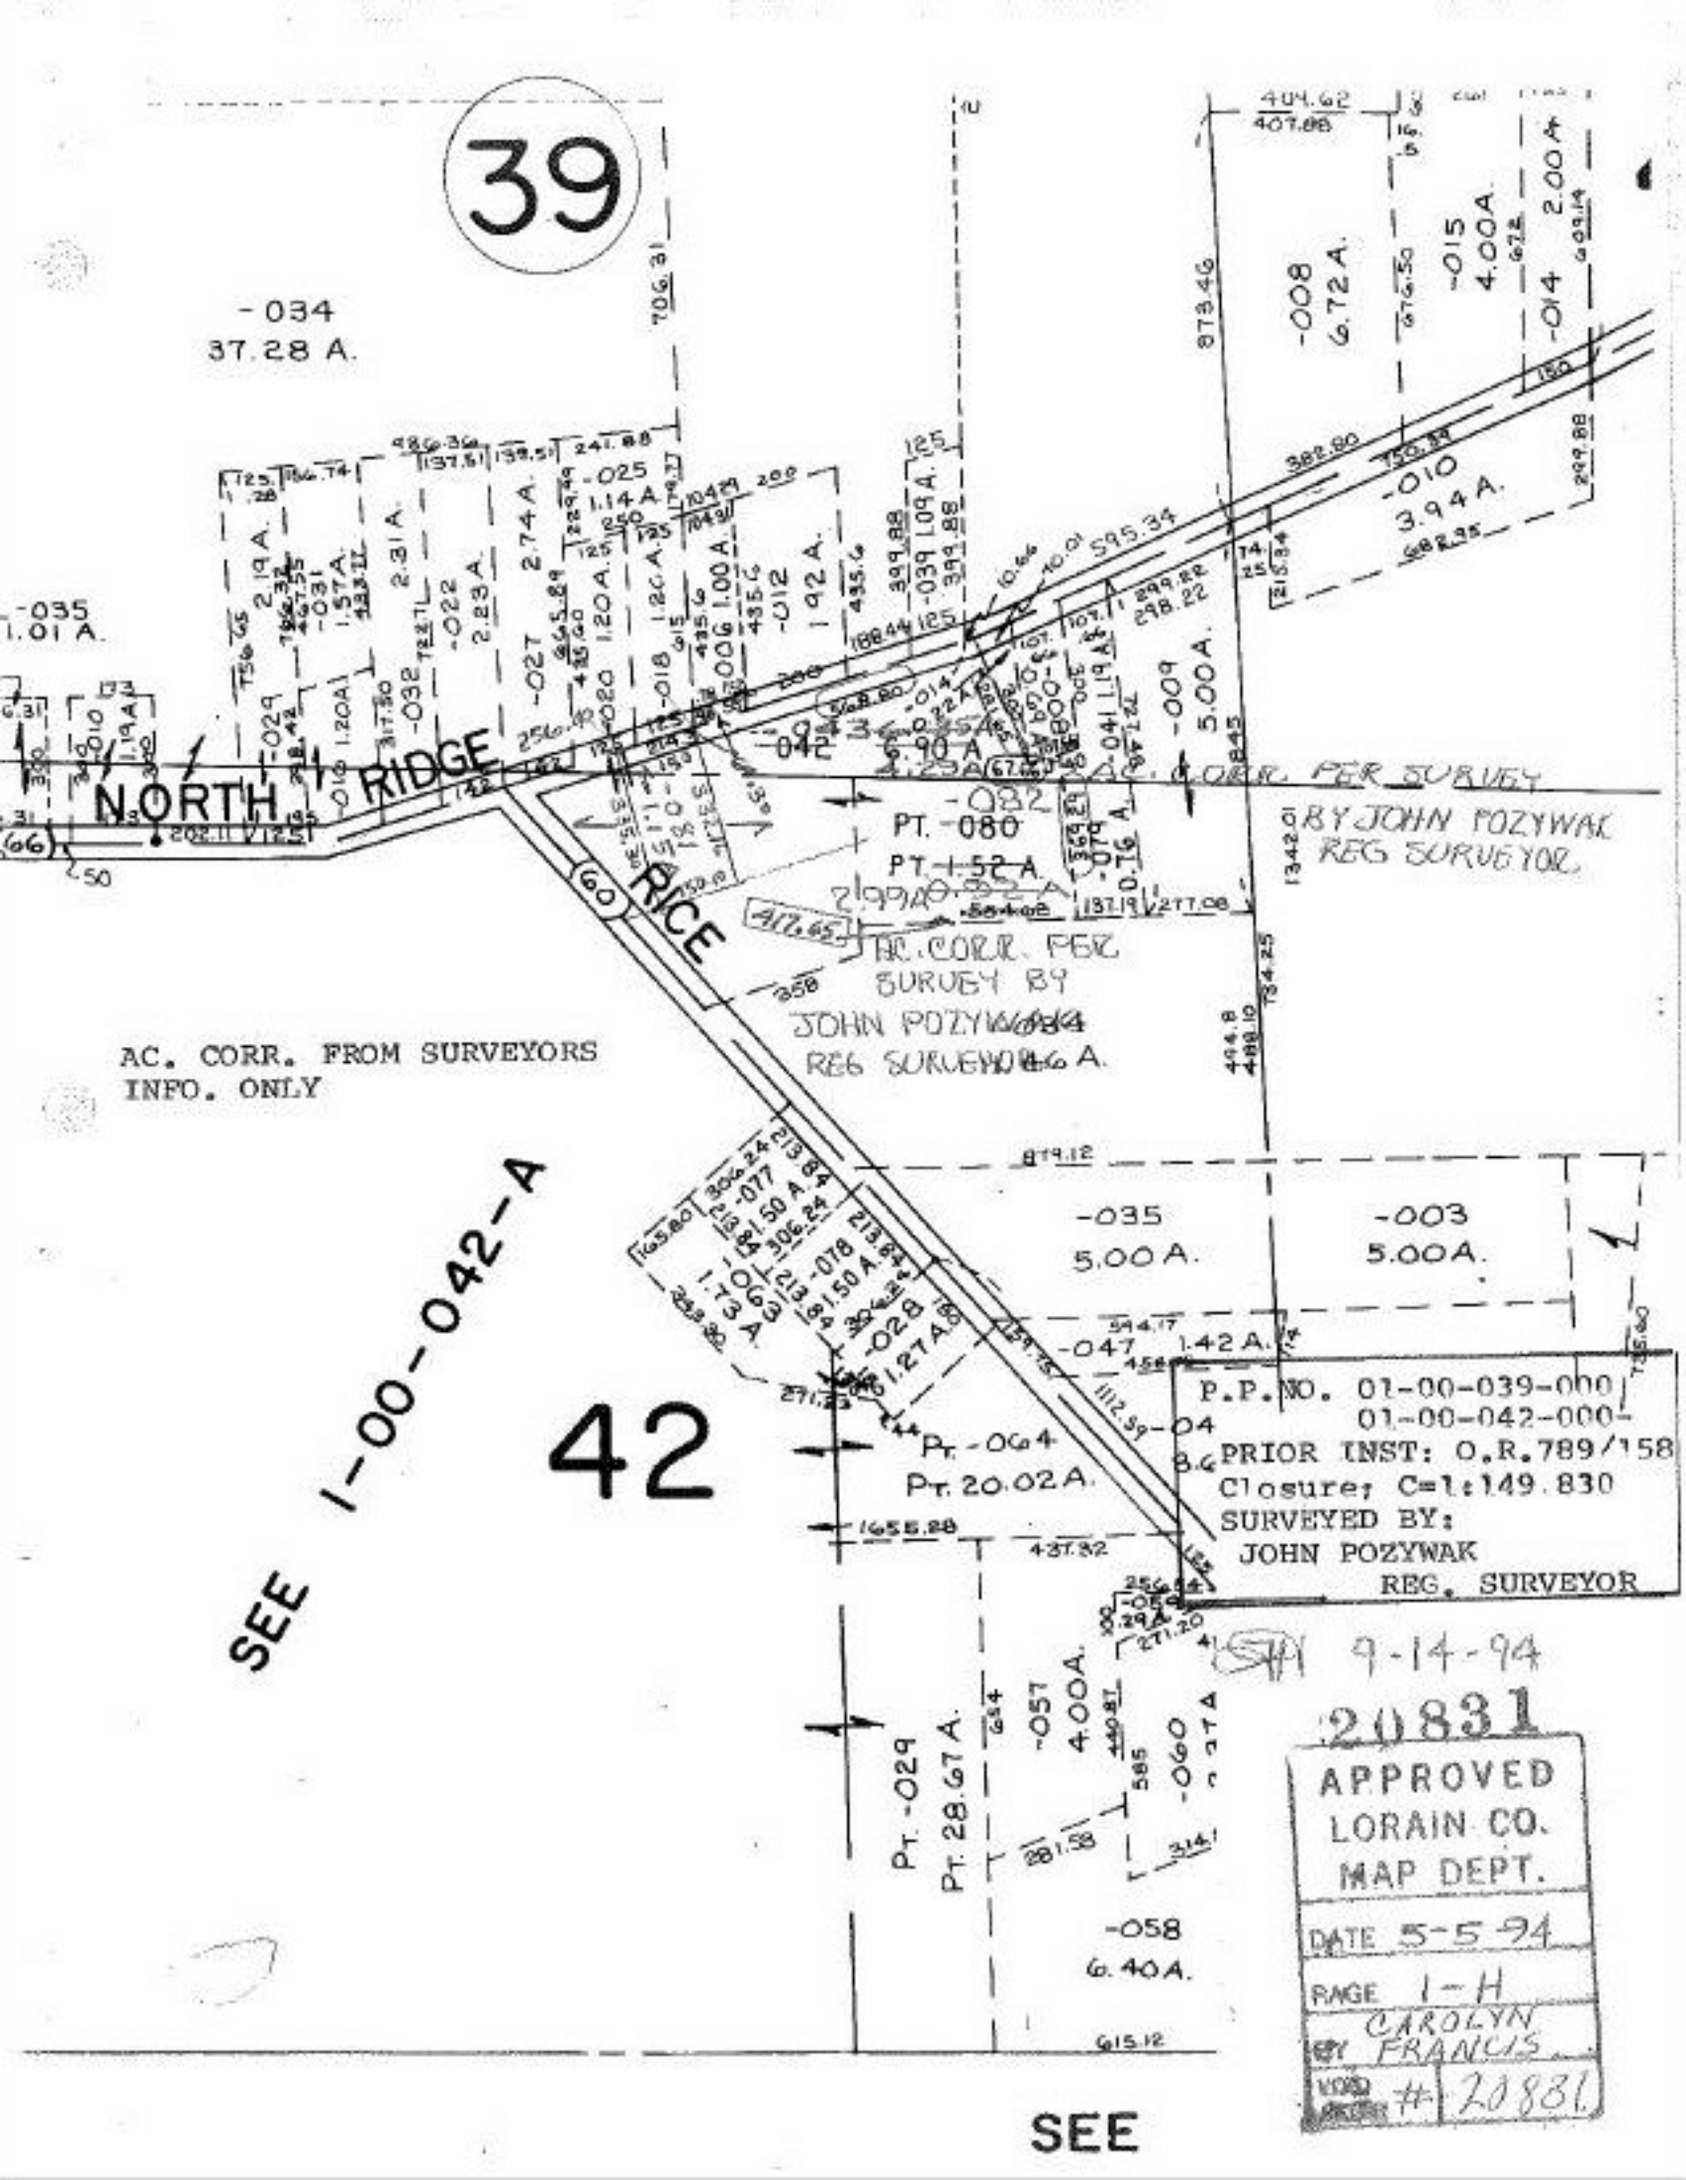
39
-034
37.28 A.
-035
1.01 A.
-029
-031
-032
-022
-027
-025
-018
-020
-012
-042
-041
-009
-008
6.72 A.
-015
4.00A.
-014
2.00 A.
-010
3.94 A.
NORTH RIDGE
RICE
(60)
(66)
AC. CORR. PER SURVEY BY JOHN POZYWAK REG SURVEYOR
PT. -080
PT. 1.52 A.
-082
AC. CORR. PER SURVEY BY JOHN POZYWAK REG SURVEYOR
AC. CORR. FROM SURVEYORS INFO. ONLY
-035
5.00 A.
-003
5.00A.
-047
1.42 A.
-028
1.27 A.
-077
-078
-064
Pt. 20.02 A.
42
SEE 1-00-042-A
P.P.NO. 01-00-039-000
01-00-042-000
PRIOR INST: O.R.789/158
Closure; C=1:149.830
SURVEYED BY:
JOHN POZYWAK
REG. SURVEYOR
-057
4.00A.
-060
-058
6.40A.
Pt. -029
Pt. 28.67 A.
SEE
9-14-94
20831
APPROVED
LORAIN CO.
MAP DEPT.
DATE 5-5-94
PAGE 1-H
BY CAROLYN FRANCIS
VOID #20831