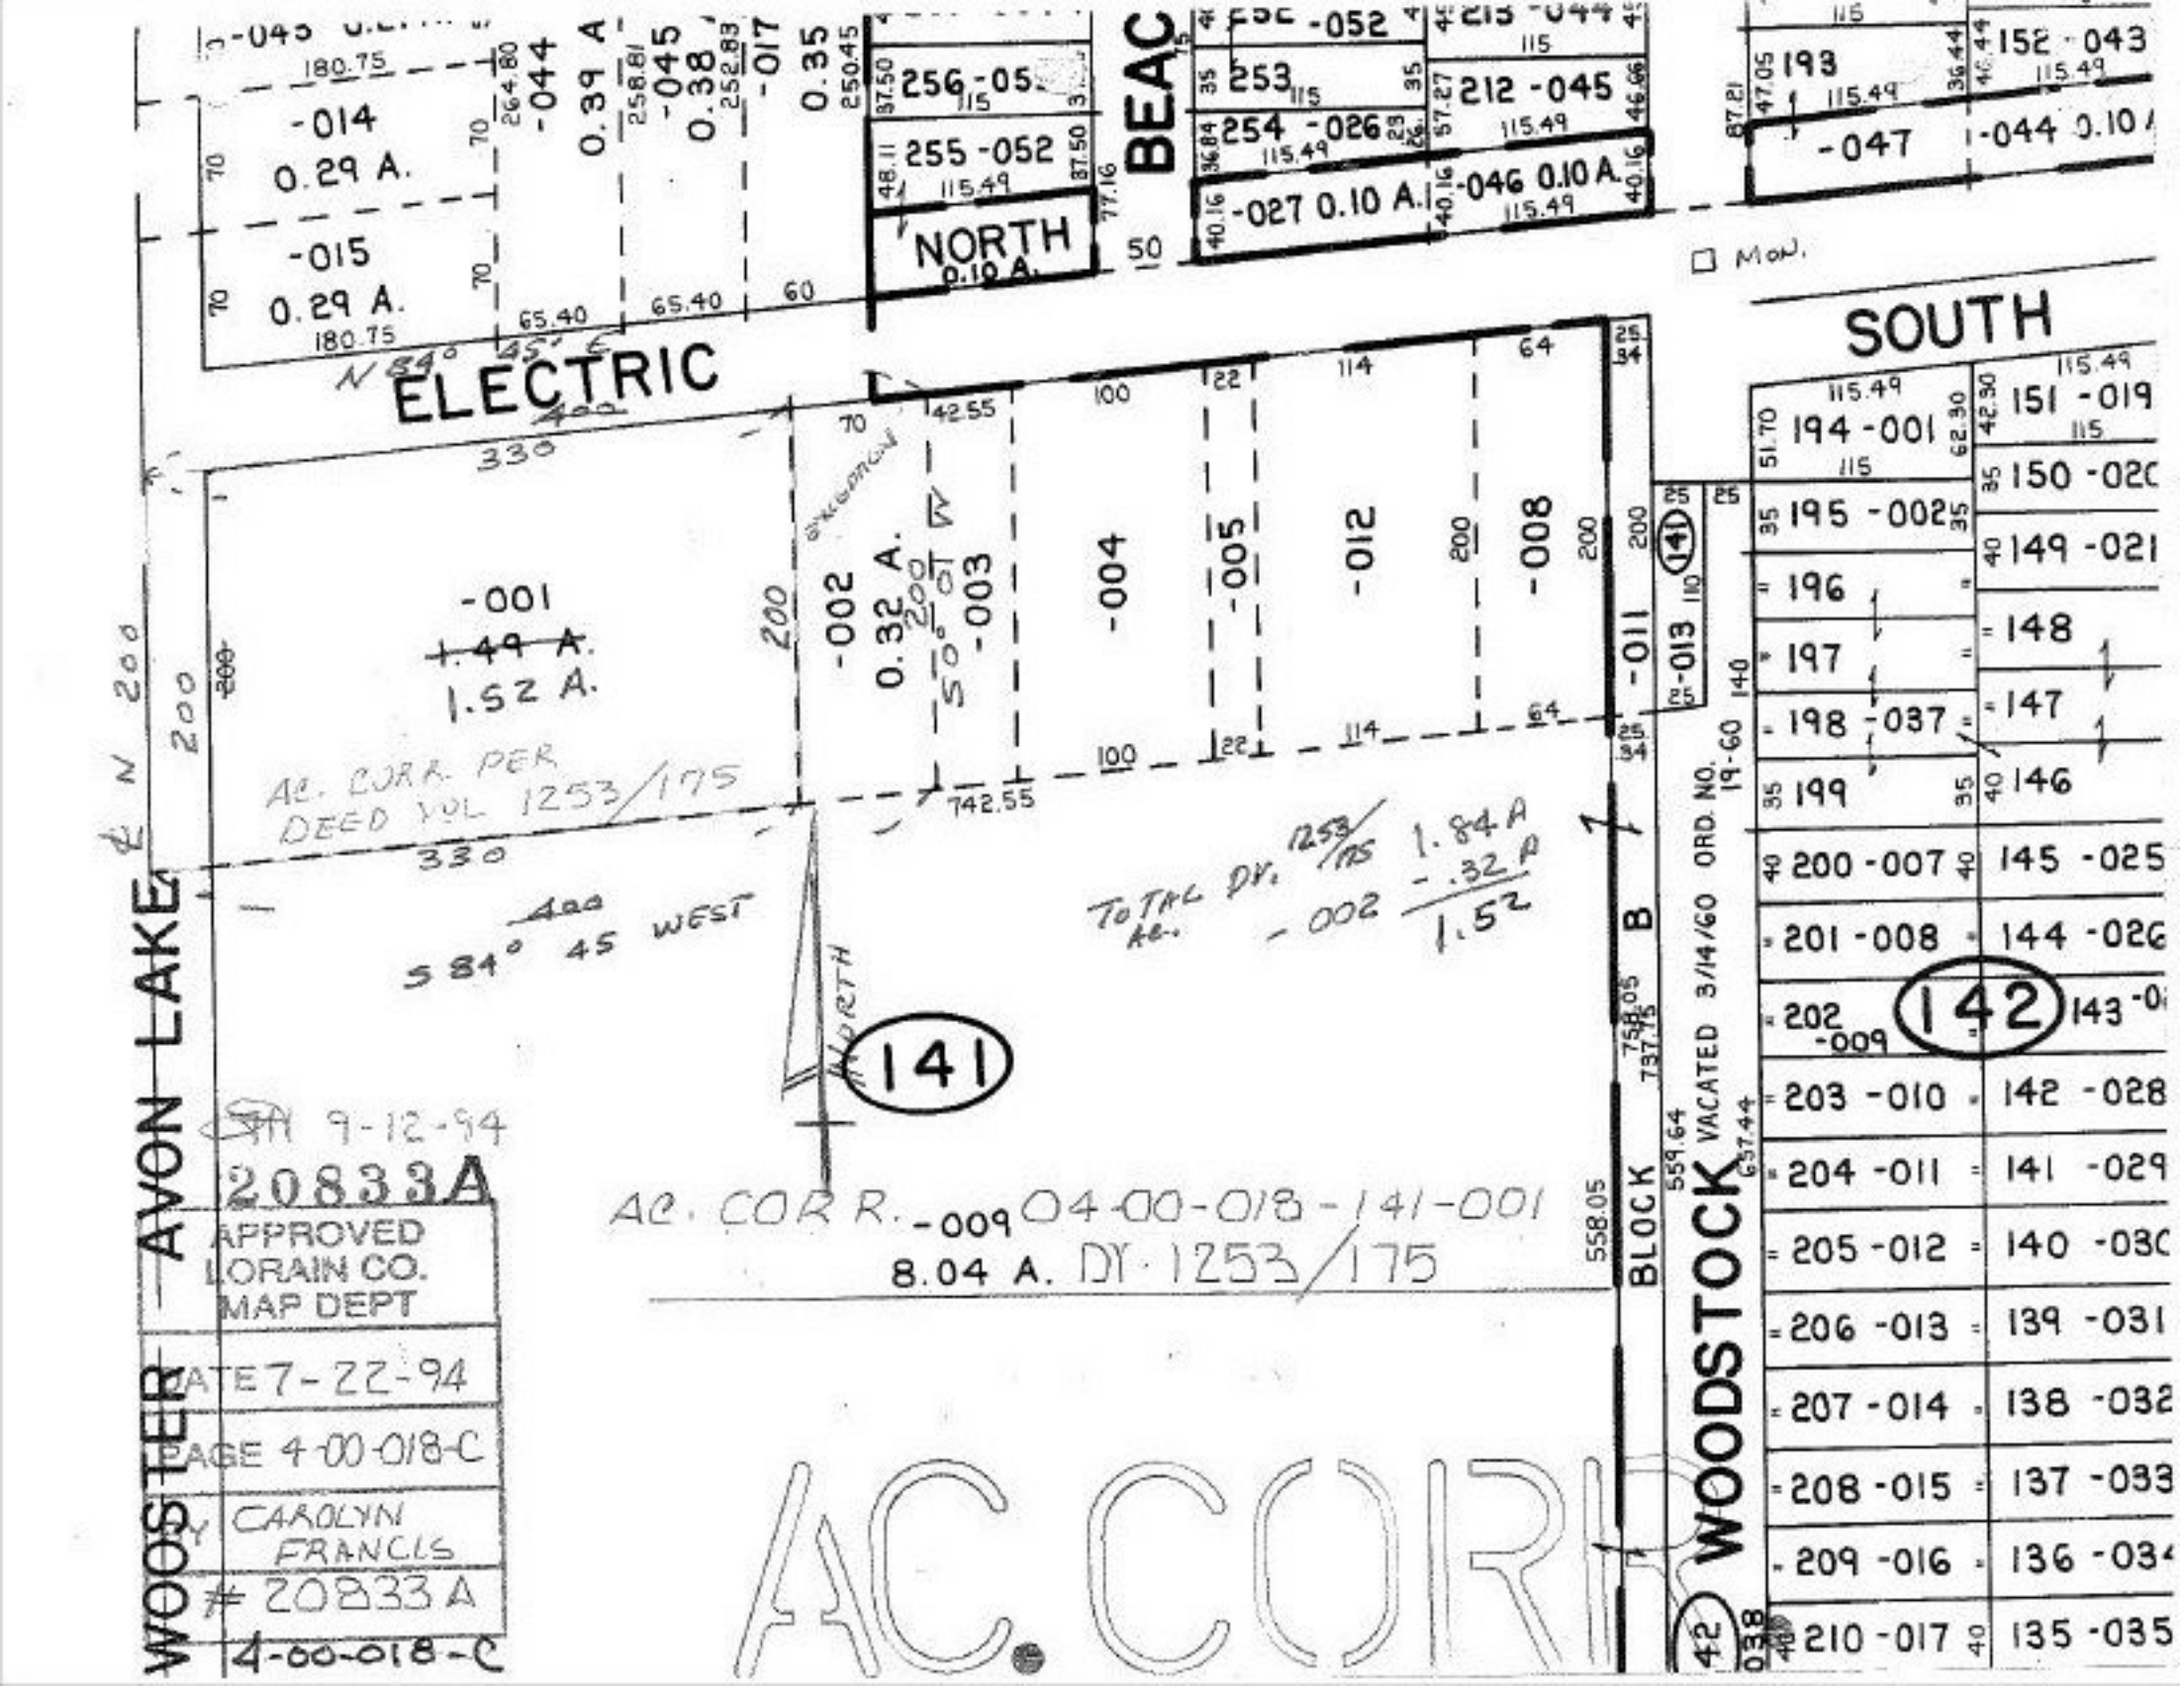

ELECTRIC
BEAC
NORTH
SOUTH
WOODSTOCK
BLOCK
AVON LAKE
WOOSTER
-014
0.29 A.
-015
0.29 A.
-044
0.39 A
-045
0.38
-017
0.35
256 -05
255 -052
253
254 -026
-027 0.10 A.
212 -045
-046 0.10 A.
193
-047
-044 0.10 A
152 -043
-001
1.49 A.
1.52 A.
-002
0.32 A.
-003
-004
-005
-012
-008
-011
-013
141
142
AC. CORR. PER DEED VOL 1253/175
S 84° 45 WEST
TOTAL DV. 1253/175 1.84 A
AC. -002 -.32 A
1.52
NORTH
AC. CORR. -009 04-00-018-141-001
8.04 A. DV. 1253/175
9-12-94
20833A
APPROVED
LORAIN CO.
MAP DEPT
DATE 7-22-94
PAGE 4-00-018-C
BY CAROLYN FRANCIS
20833 A
4-00-018-C
AC. CORR
VACATED 3/14/60 ORD. NO. 19-60
194 -001
195 -002
196
197
198 -037
199
200 -007
201 -008
202 -009
203 -010
204 -011
205 -012
206 -013
207 -014
208 -015
209 -016
210 -017
151 -019
150 -020
149 -021
148
147
146
145 -025
144 -026
143
142 -028
141 -029
140 -030
139 -031
138 -032
137 -033
136 -034
135 -035