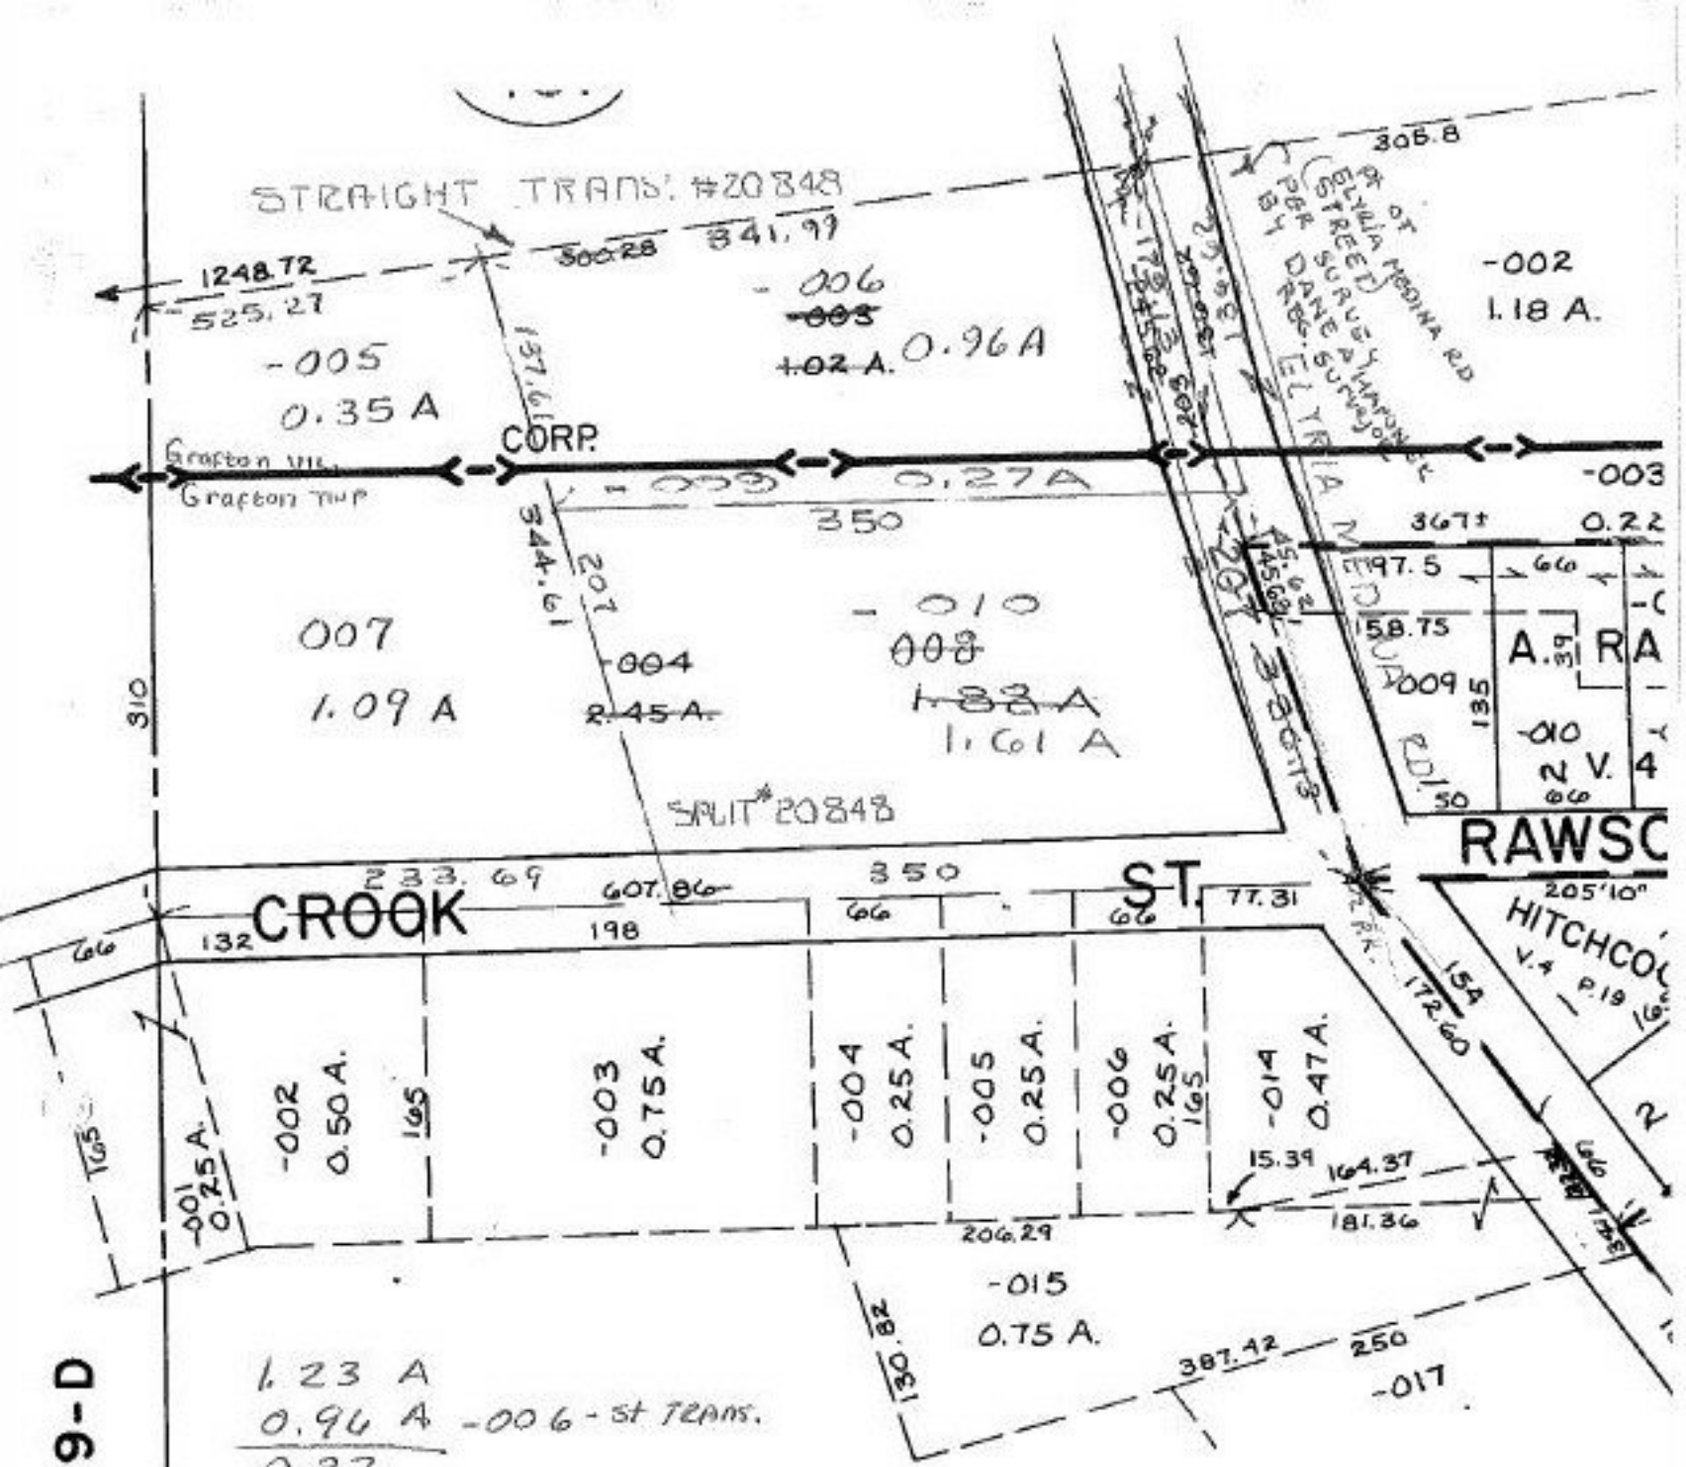

1.23 A
0.96 A -006 - ST TRANS.
0.27

-008 1.88 A.
SPLIT AS OUT 0.27 A.
1.61 A.

P.P.NO. 16-00-018-101-
PRIOR INST: O.R.618/394
CLOSURE: C=1:428,039
SURVEYED BY: DANE A HAPONEK
REG. SURVEYOR

AUG 3 1994

20848
APPROVED
LORAIN CO.
MAP DEPT.
DATE 5-16-94
PAGE 16-00-018-A
BY CAROLYN FRANCIS
VOL # 20848