2085

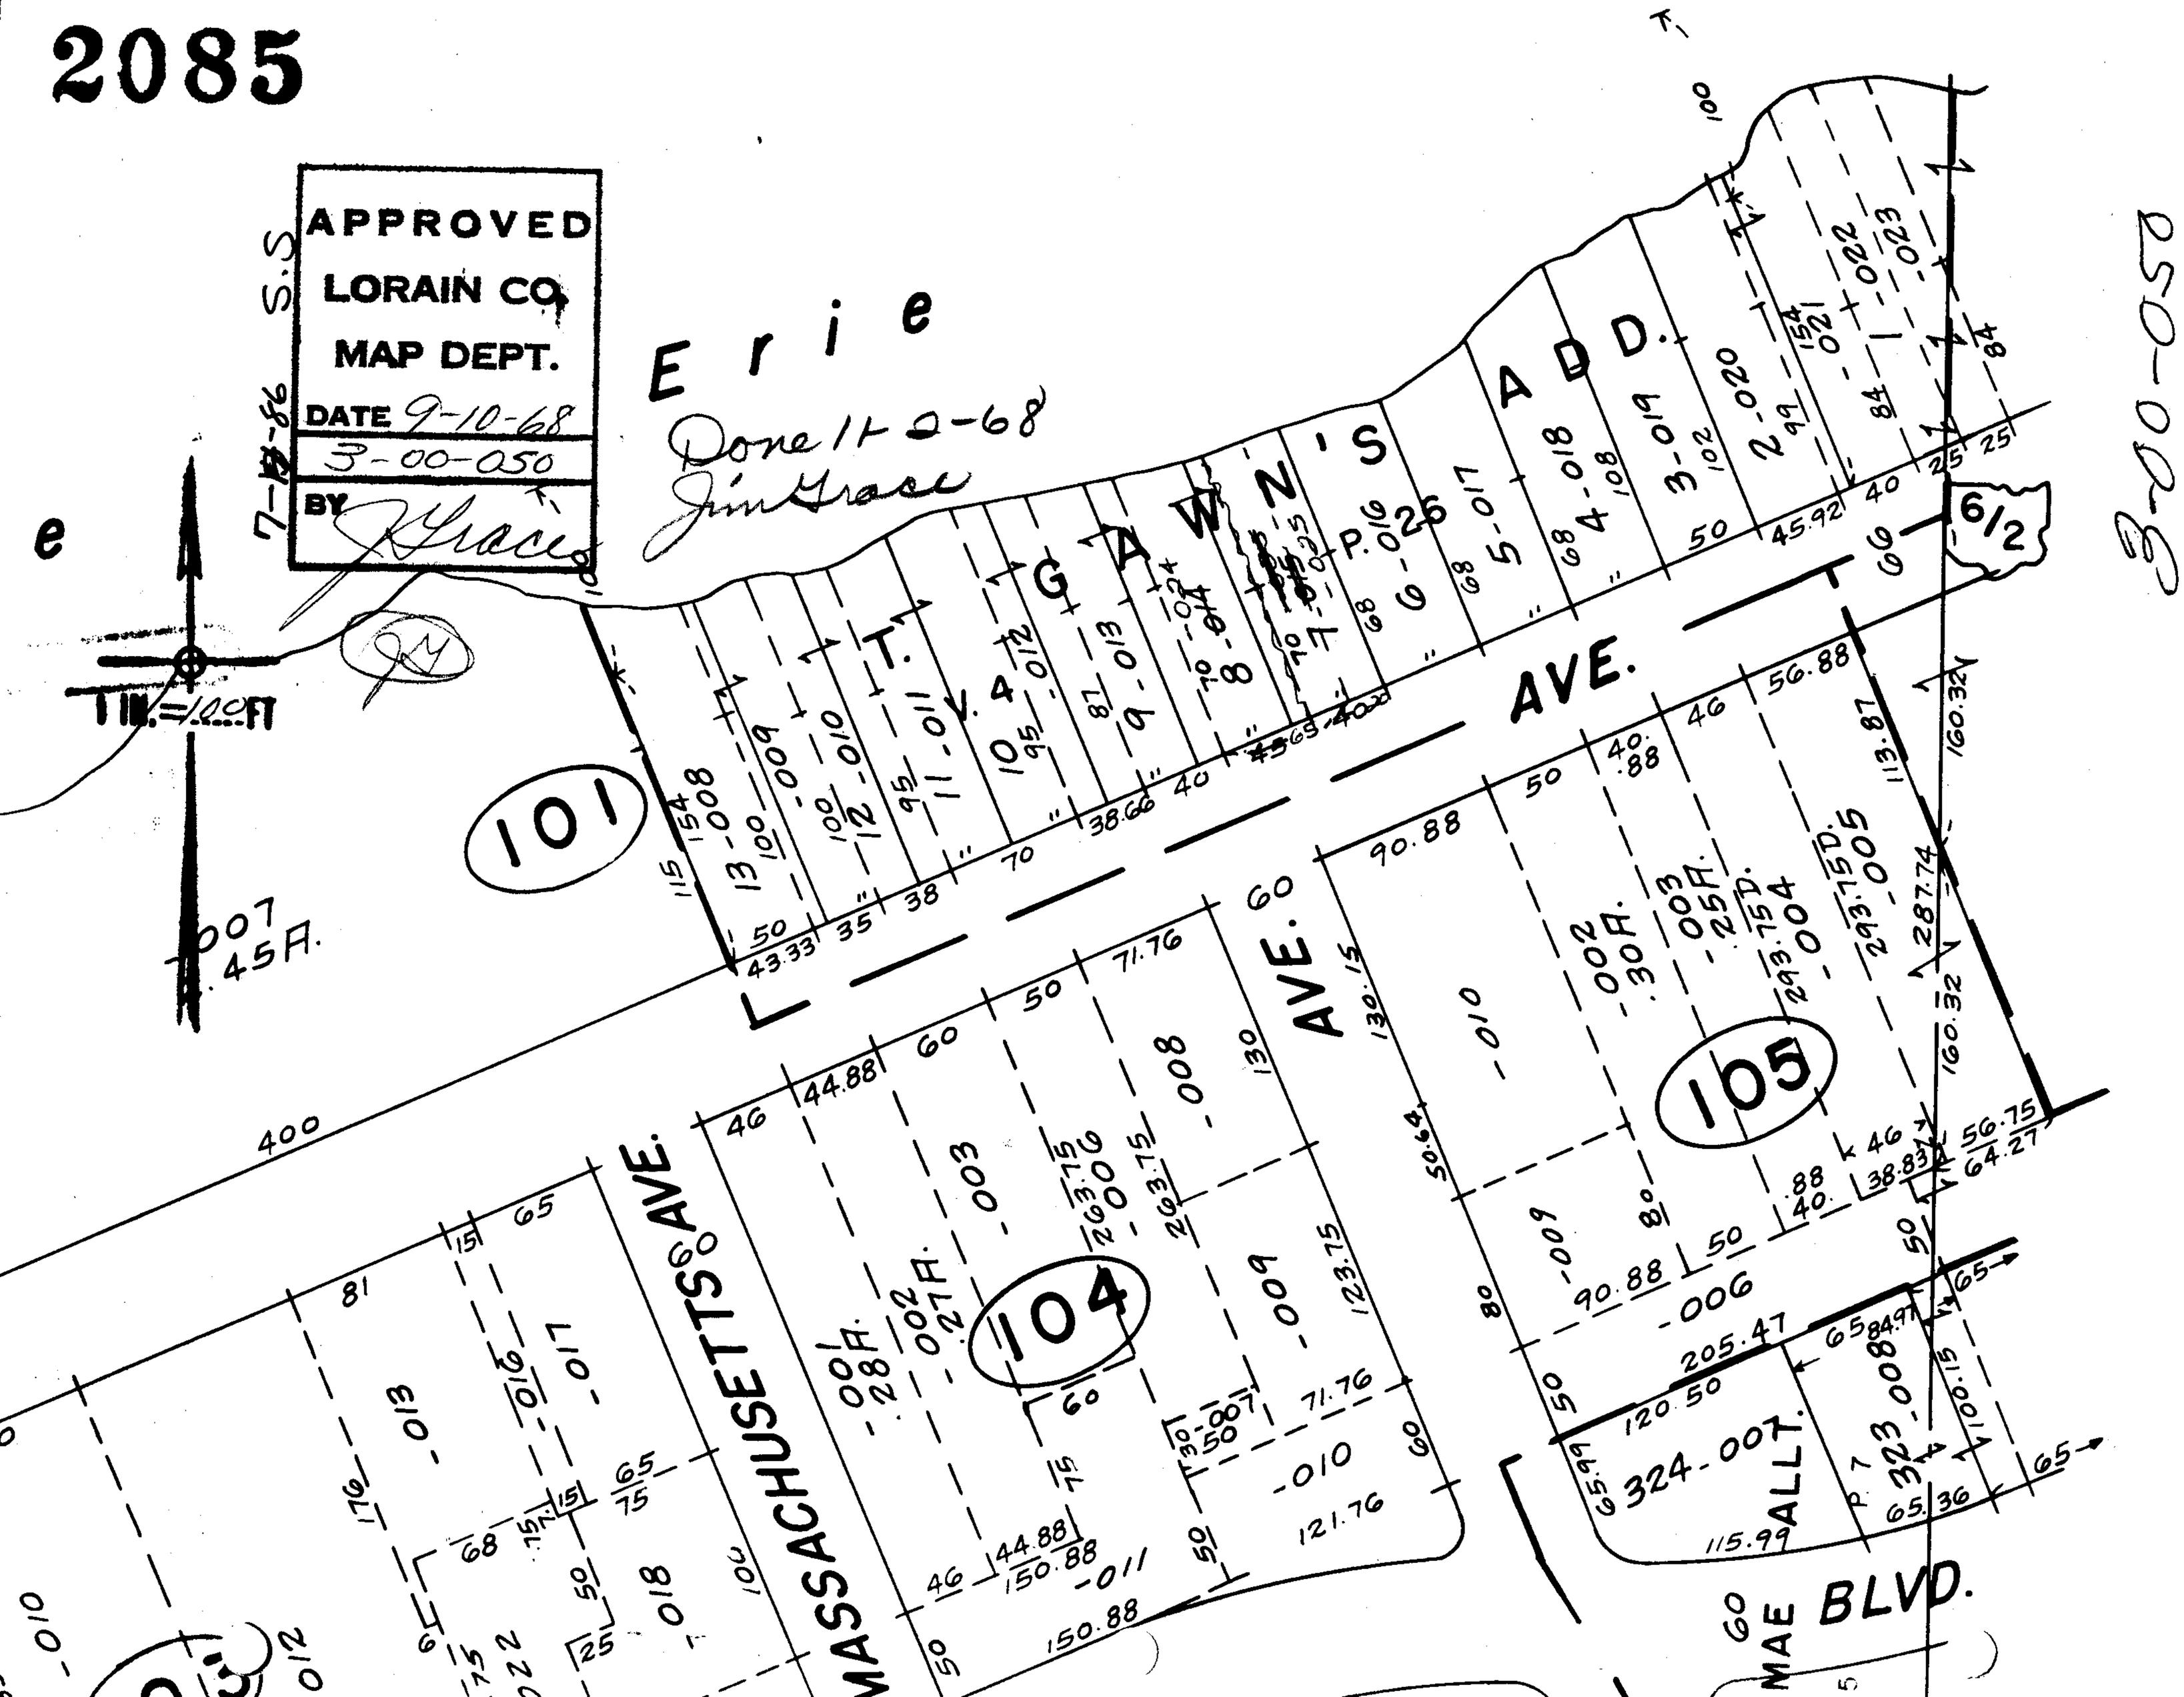
APPROVED
LORAIN CO.
MAP DEPT.
DATE 9-10-68
3-00-050
BY J Grace
Done 11-2-68
Jim Grace
Erie
T. GAWN'S ADD.
V. 4
P. 26
AVE.
MASSACHUSETTS AVE.
MAE BLVD.
ALLT.
101
104
105
6/2
1 IN. = 100 FT
3-00-050