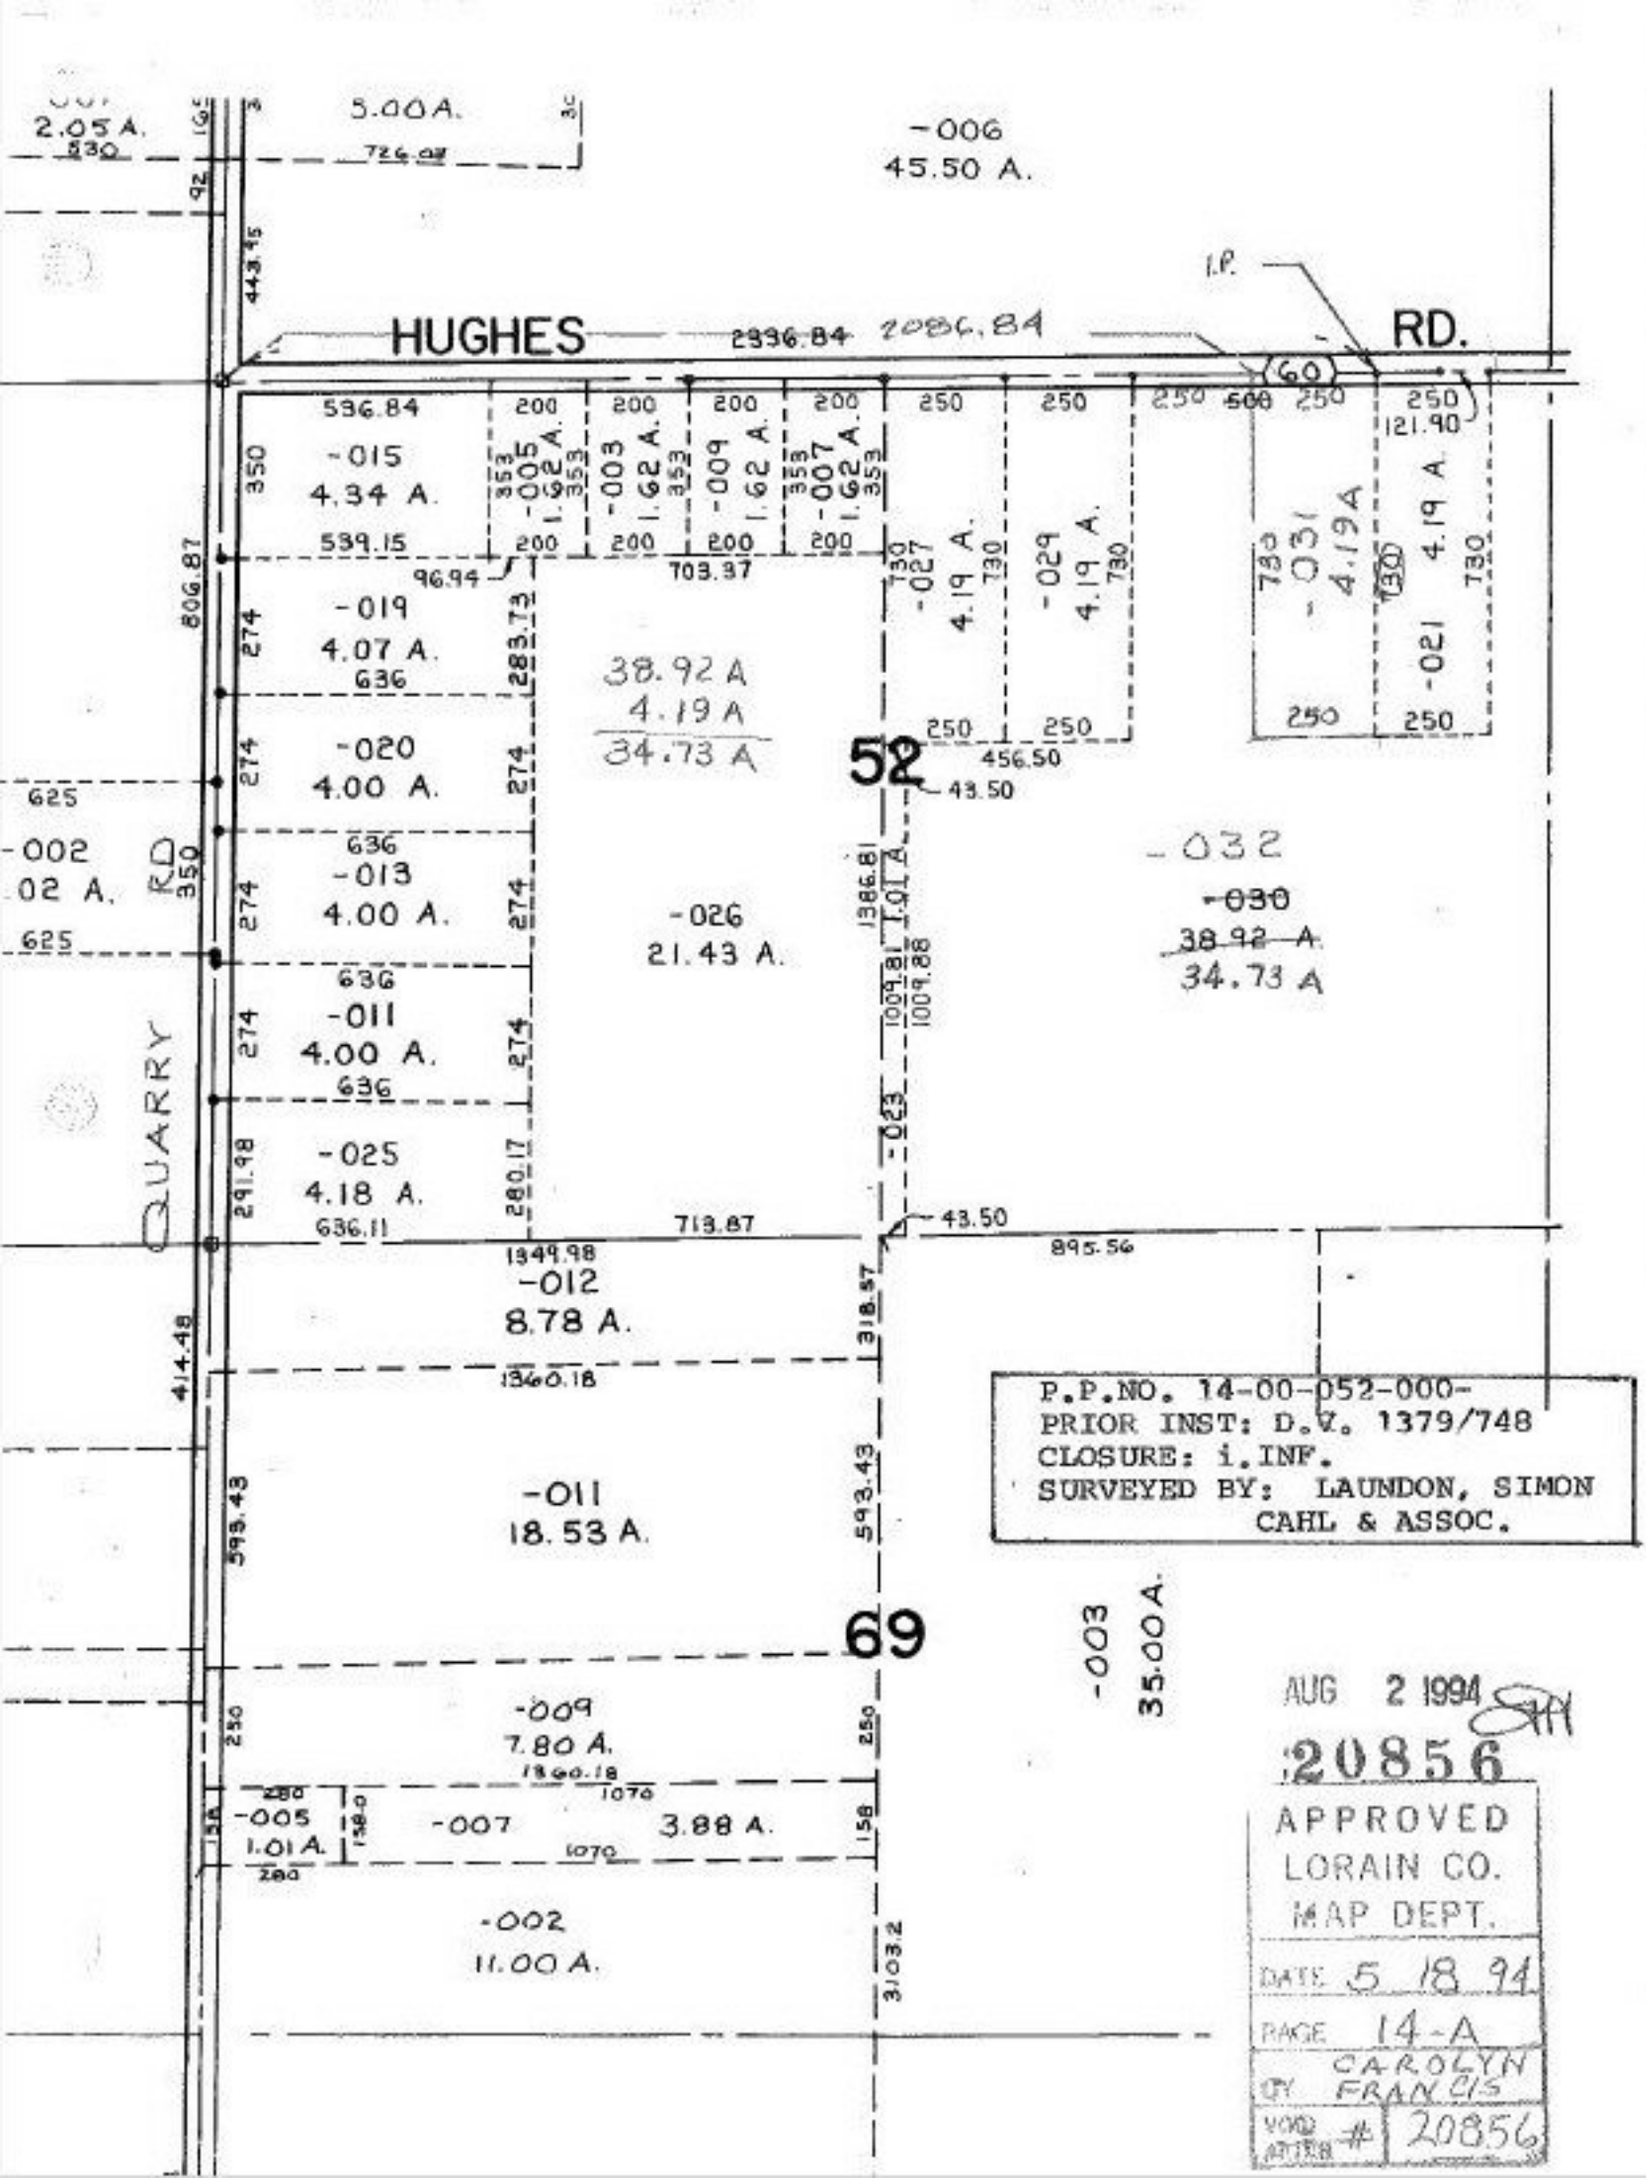
2.05 A.
5.00 A.
-006
45.50 A.
I.P.
HUGHES
2336.84
2086.84
RD.
60
536.84
-015
4.34 A.
539.15
-005
1.62 A.
-003
1.62 A.
-009
1.62 A.
-007
1.62 A.
-027
4.19 A.
-029
4.19 A.
-031
4.19A
-021
4.19 A.
121.90
806.87
-019
4.07 A.
636
-020
4.00 A.
625
-002
02 A.
RD
350
-013
4.00 A.
-011
4.00 A.
QUARRY
-025
4.18 A.
636.11
38.92 A
4.19 A
34.73 A
52
456.50
43.50
-026
21.43 A.
1386.81
1.01 A.
1009.81
1009.88
-023
-032
-030
38.92 A.
34.73 A
713.87
1349.98
-012
8.78 A.
895.56
318.57
414.48
1360.18
-011
18.53 A.
593.43
593.43
69
-003
35.00 A.
-009
7.80 A.
1360.18
1070
-005
1.01 A.
-007
3.88 A.
-002
11.00 A.
3103.2
P.P.NO. 14-00-052-000-
PRIOR INST: D.V. 1379/748
CLOSURE: i.INF.
SURVEYED BY: LAUNDON, SIMON
CAHL & ASSOC.
AUG 2 1994
20856
APPROVED
LORAIN CO.
MAP DEPT.
DATE 5 18 94
PAGE 14-A
BY CAROLYN FRANCIS
VOID AFFIDAVIT # 20856