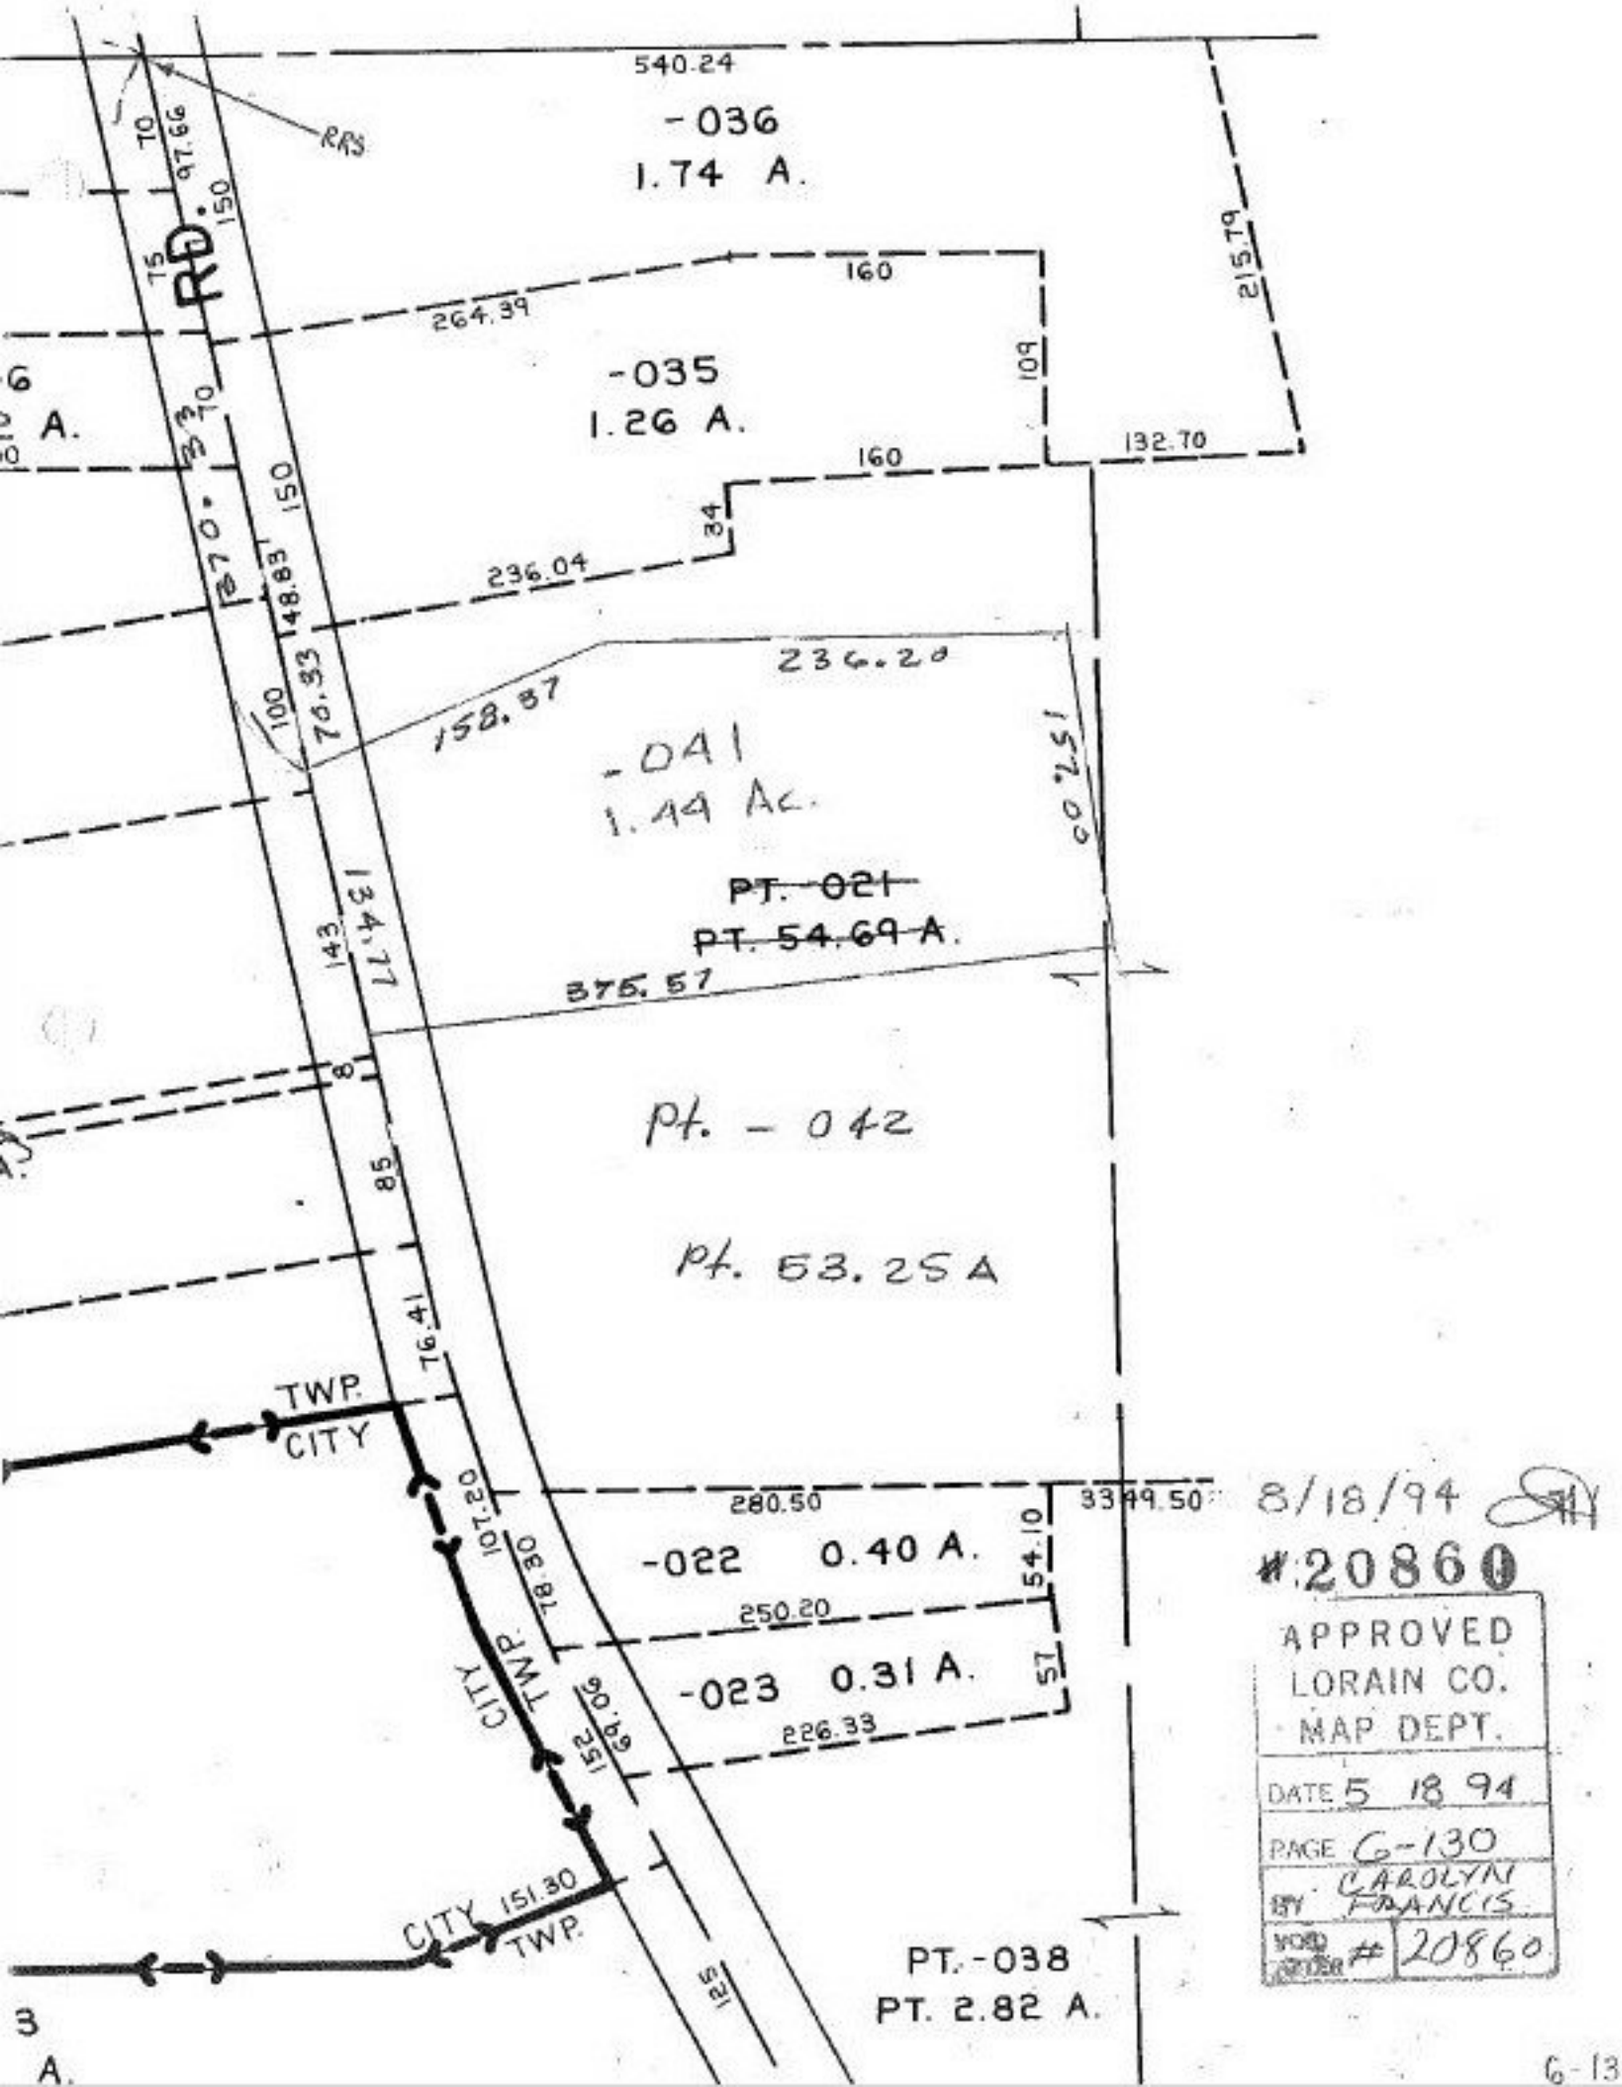

8/18/94

#20860

APPROVED
LORAIN CO.
MAP DEPT.

DATE 5 18 94

PAGE G-130

BY CAROLYN FRANCIS

VOID #20860