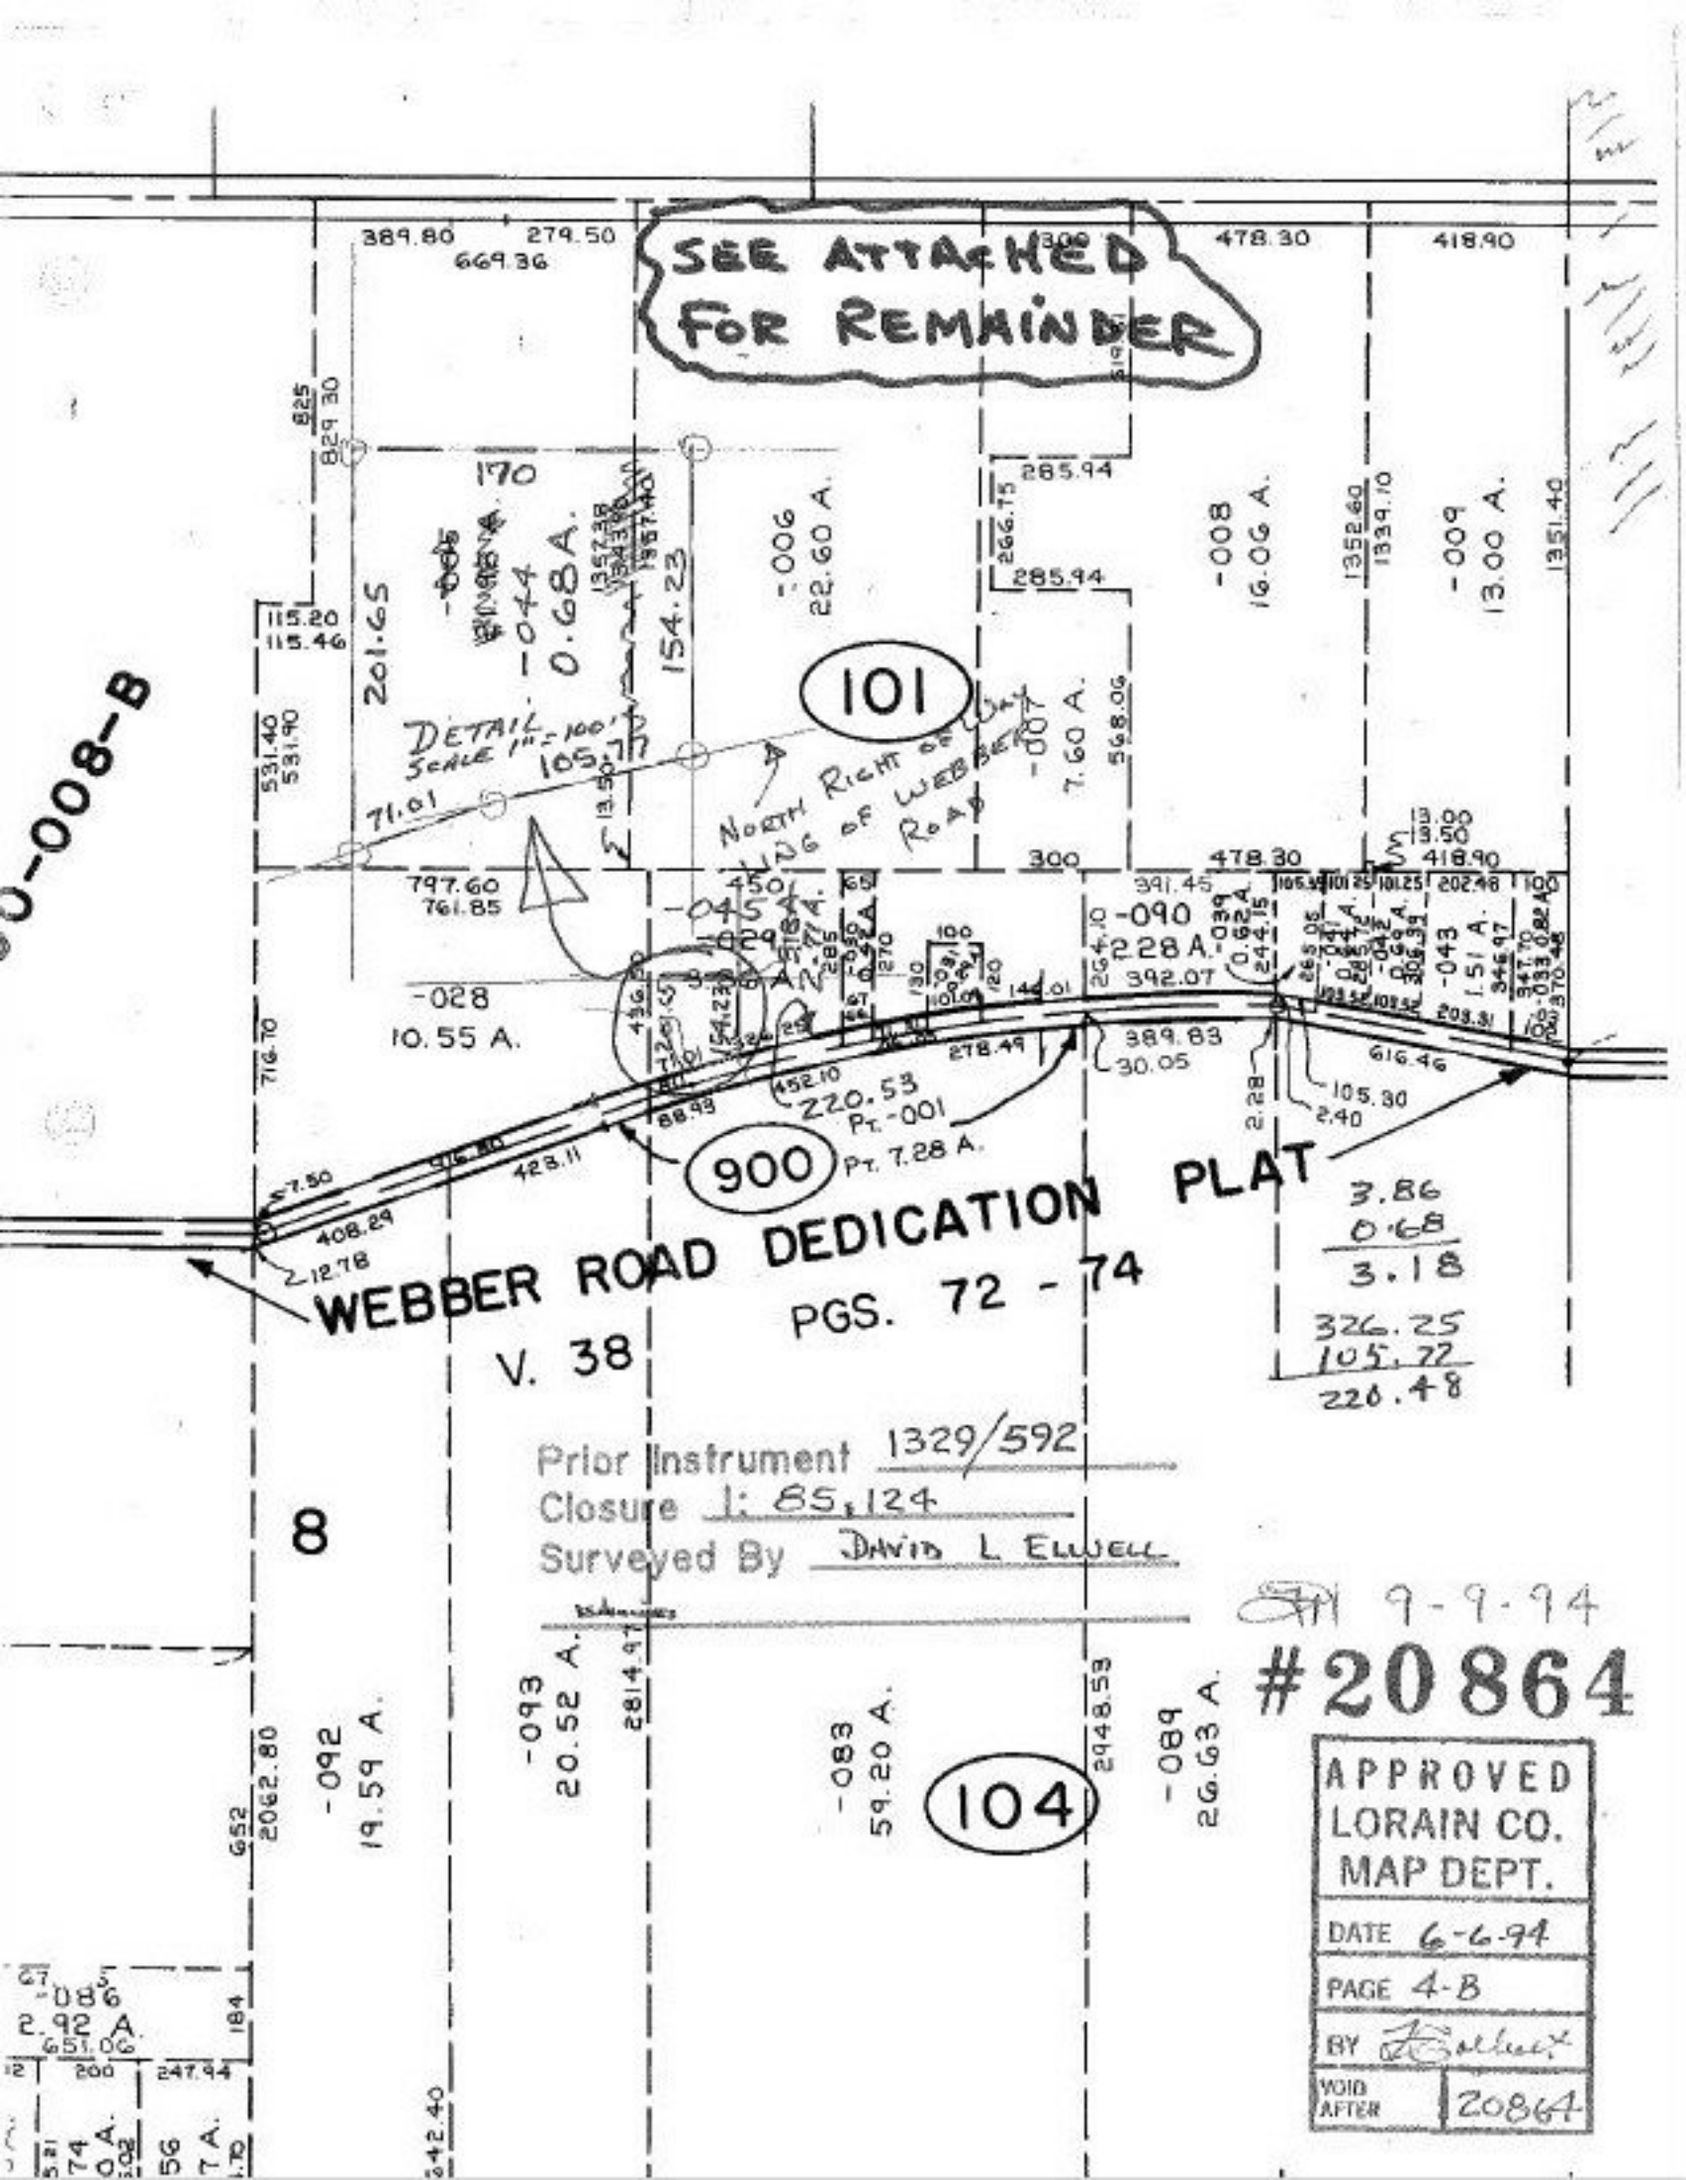
SEE ATTACHED FOR REMAINDER
101
900
104
8
WEBBER ROAD DEDICATION PLAT
PGS. 72 - 74
V. 38
DETAIL SCALE 1" = 100'
NORTH RIGHT OF WAY LINE OF WEBBER ROAD
-008-B
-028 10.55 A.
-044 0.68 A.
-006 22.60 A.
-008 16.06 A.
-009 13.00 A.
-007 7.60 A.
-090 2.28 A.
-043 1.51 A.
-092 19.59 A.
-093 20.52 A.
-083 59.20 A.
-089 26.63 A.
-086 2.92 A.
220.53 Pt. -001
Pt. 7.28 A.
3.86
0.68
3.18
326.25
105.77
220.48
Prior Instrument 1329/592
Closure 1: 85,124
Surveyed By DAVID L ELWELL
9-9-94
#20864
APPROVED
LORAIN CO.
MAP DEPT.
DATE 6-6-94
PAGE 4-B
BY
VOID AFTER 20864