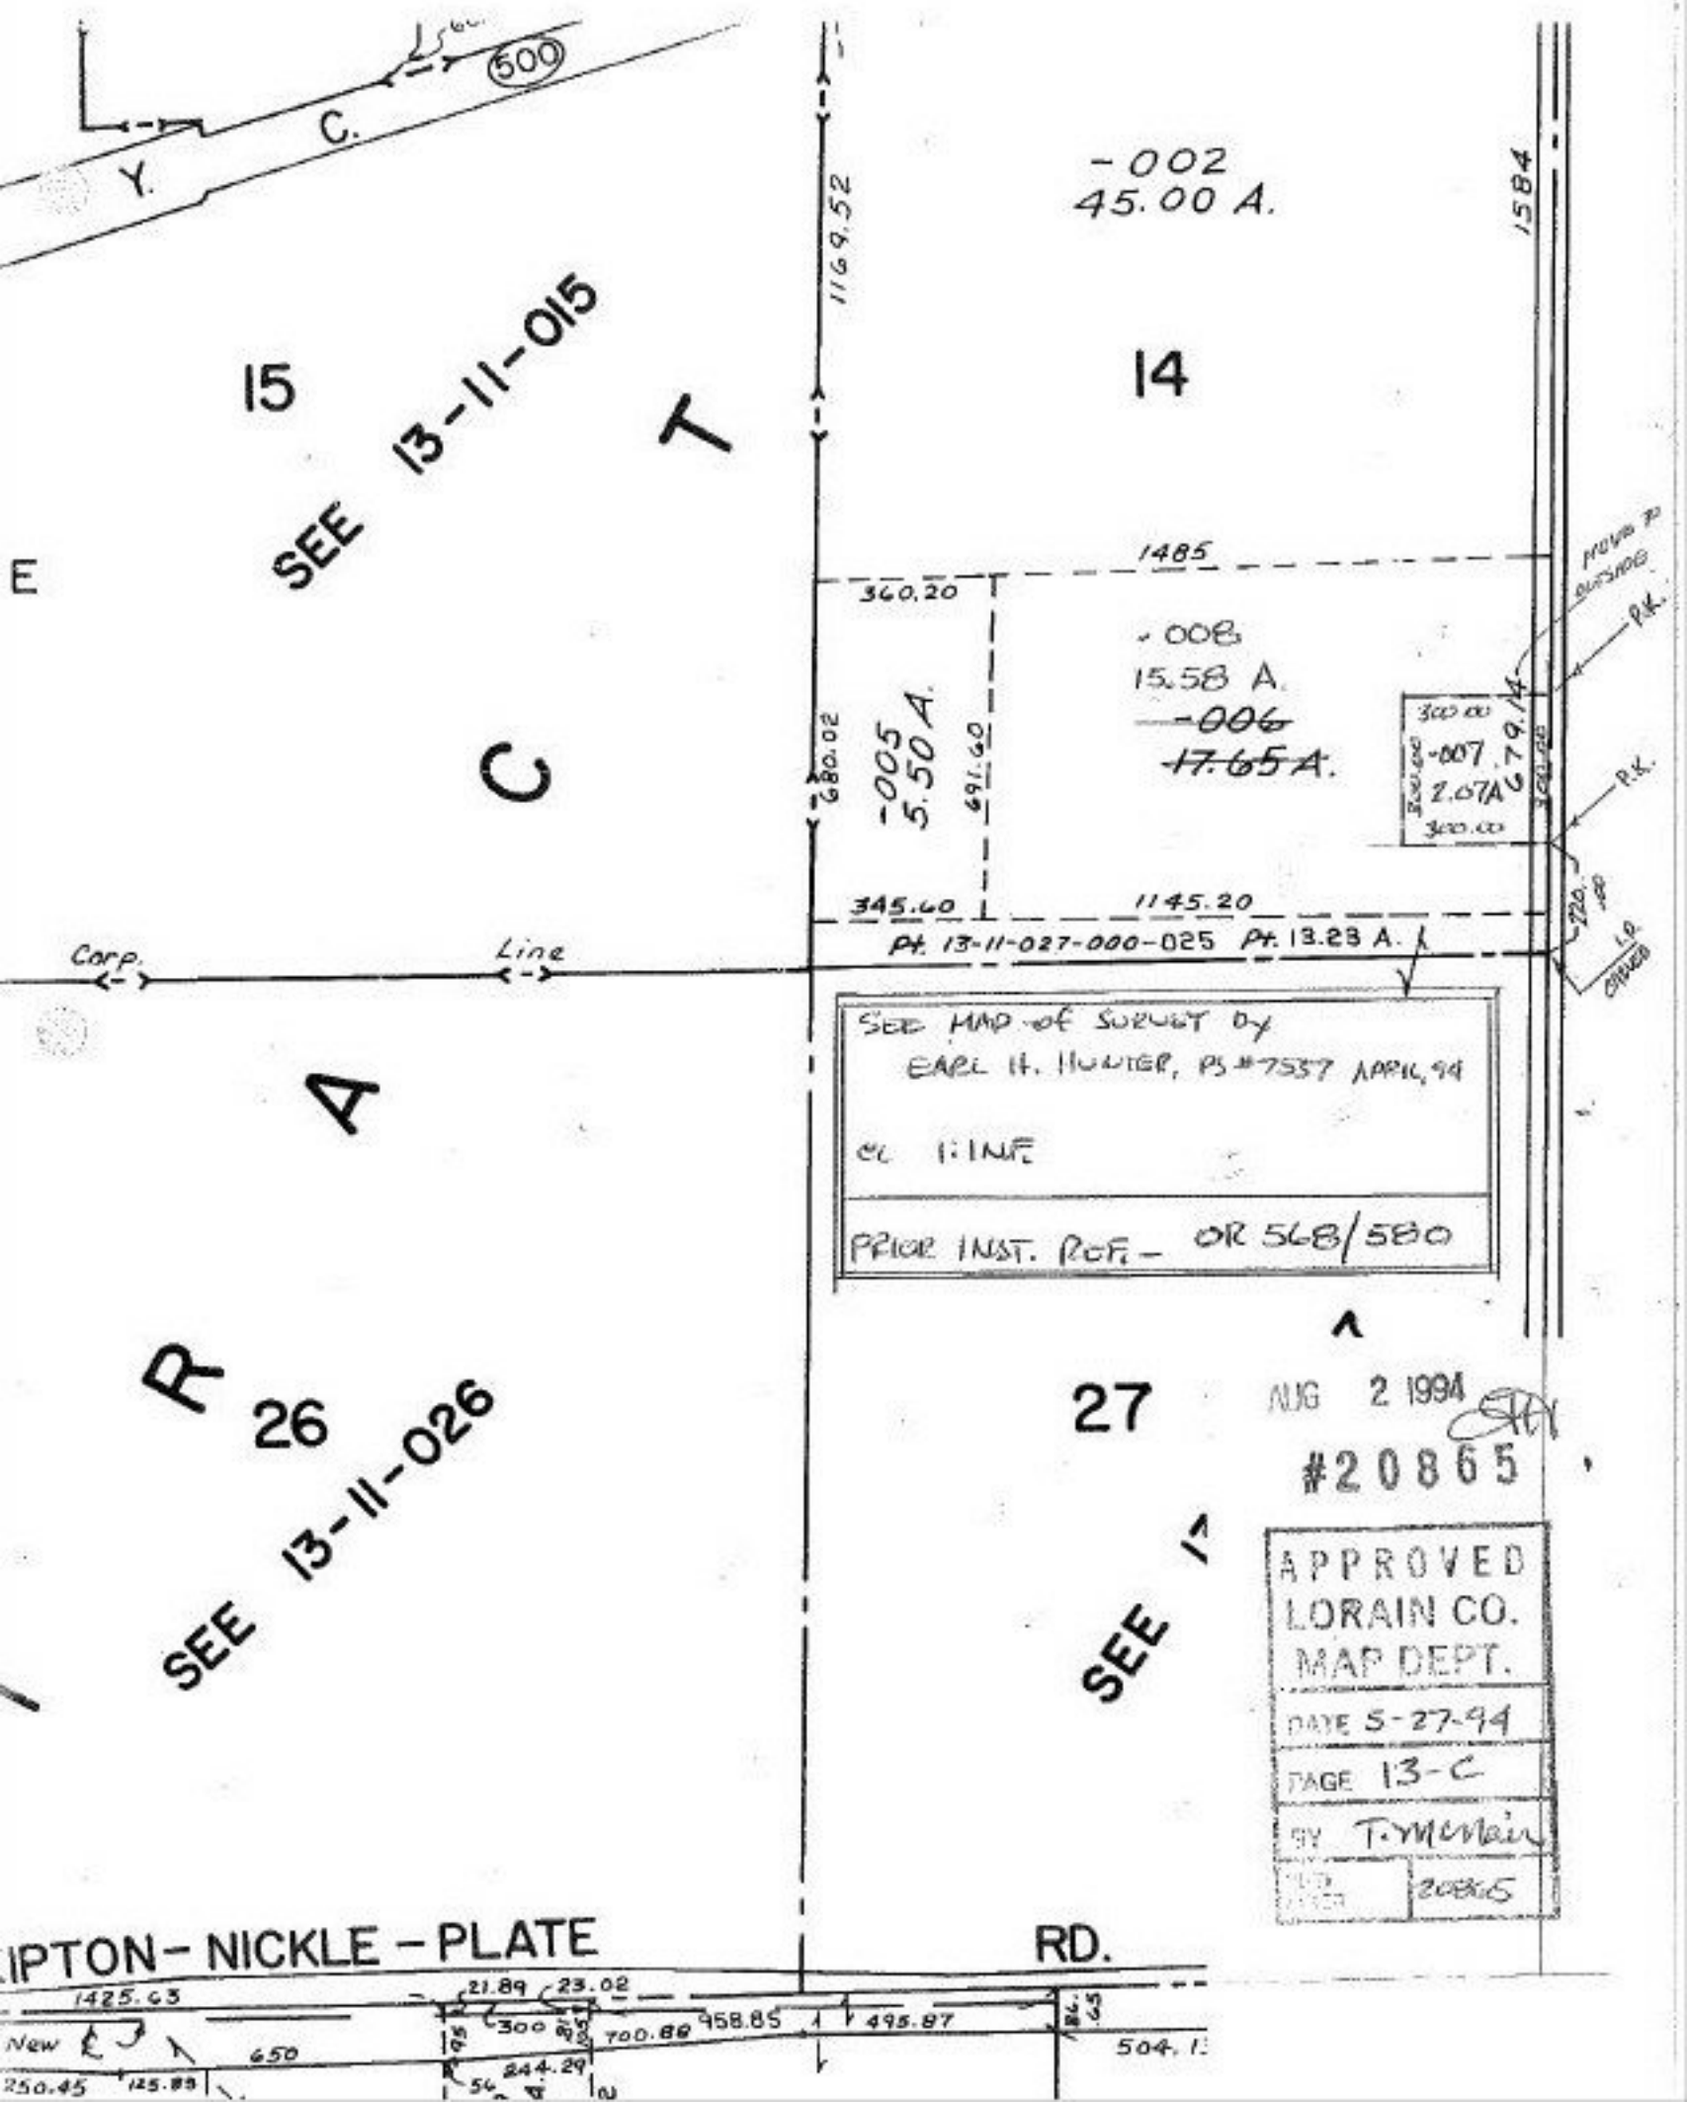

500
Y.
C.
-002
45.00 A.
1169.52
1584
15
SEE 13-11-015
14
T
E
1485
360.20
-008
15.58 A.
~~-006~~
~~17.65 A.~~
-005
5.50 A.
680.02
691.60
300.00
-007
2.07A
679.14
300.00
P.K.
P.K.
345.60
1145.20
Pt. 13-11-027-000-025 Pt. 13.23 A.
Corp.
Line
SEE MAP of SURVEY by
EARL H. HUNTER, PS #7537 APRIL, 94
cl 1:INF
PRIOR INST. REF. - OR 568/580
A
R
26
SEE 13-11-026
27
SEE
AUG 2 1994
#20865
APPROVED
LORAIN CO.
MAP DEPT.
DATE 5-27-94
PAGE 13-C
BY T. McMain
20865
IPTON - NICKLE - PLATE
RD.
1425.63
21.89
23.02
300
700.88
958.85
495.87
New
650
244.29
250.45
125.85
504.1