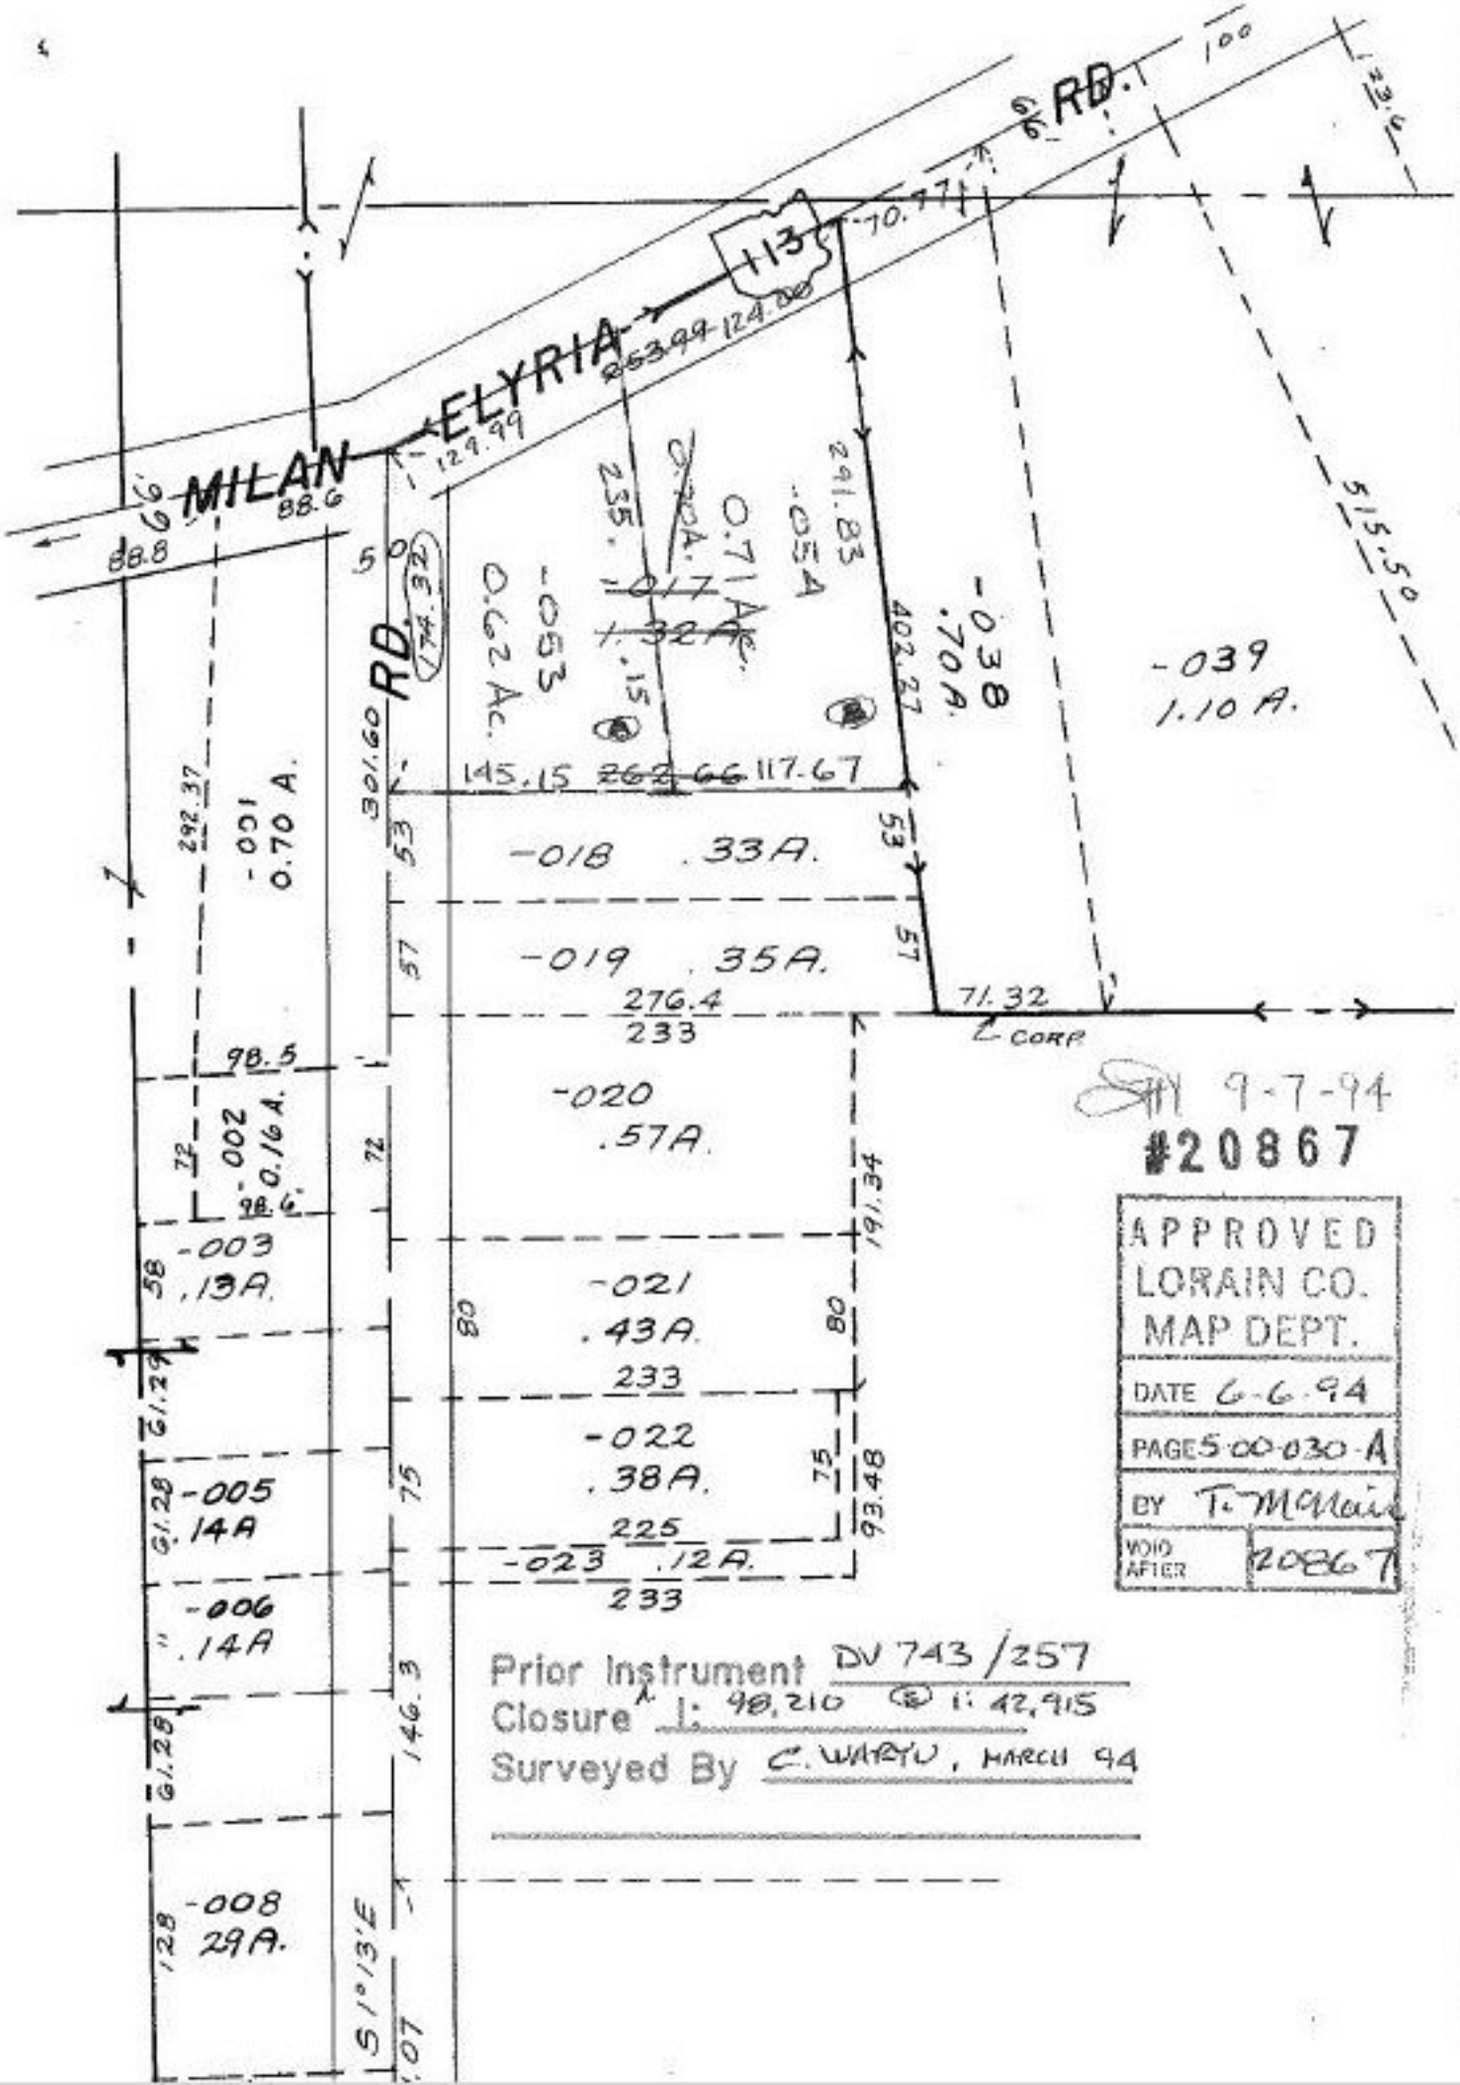
MILAN
ELYRIA
RD.
RD.
113
-039
1.10 A.
-038
.70 A.
-054
0.71 Ac.
-053
0.62 Ac.
-017
.32 Ac.
-001
0.70 A.
-018 .33A.
-019 .35A.
-020
.57A.
-002
0.16 A.
-003
.13A.
-021
.43A.
-022
.38A.
-005
.14A
-023 .12A.
-006
.14A
-008
29A.
S 1°13'E
CORR
9-7-94
#20867
APPROVED
LORAIN CO.
MAP DEPT.
DATE 6-6-94
PAGE 5-00-030-A
BY T. McGrain
VOID AFTER 20867
Prior Instrument DV 743/257
Closure
Surveyed By C. WARYU, MARCH 94