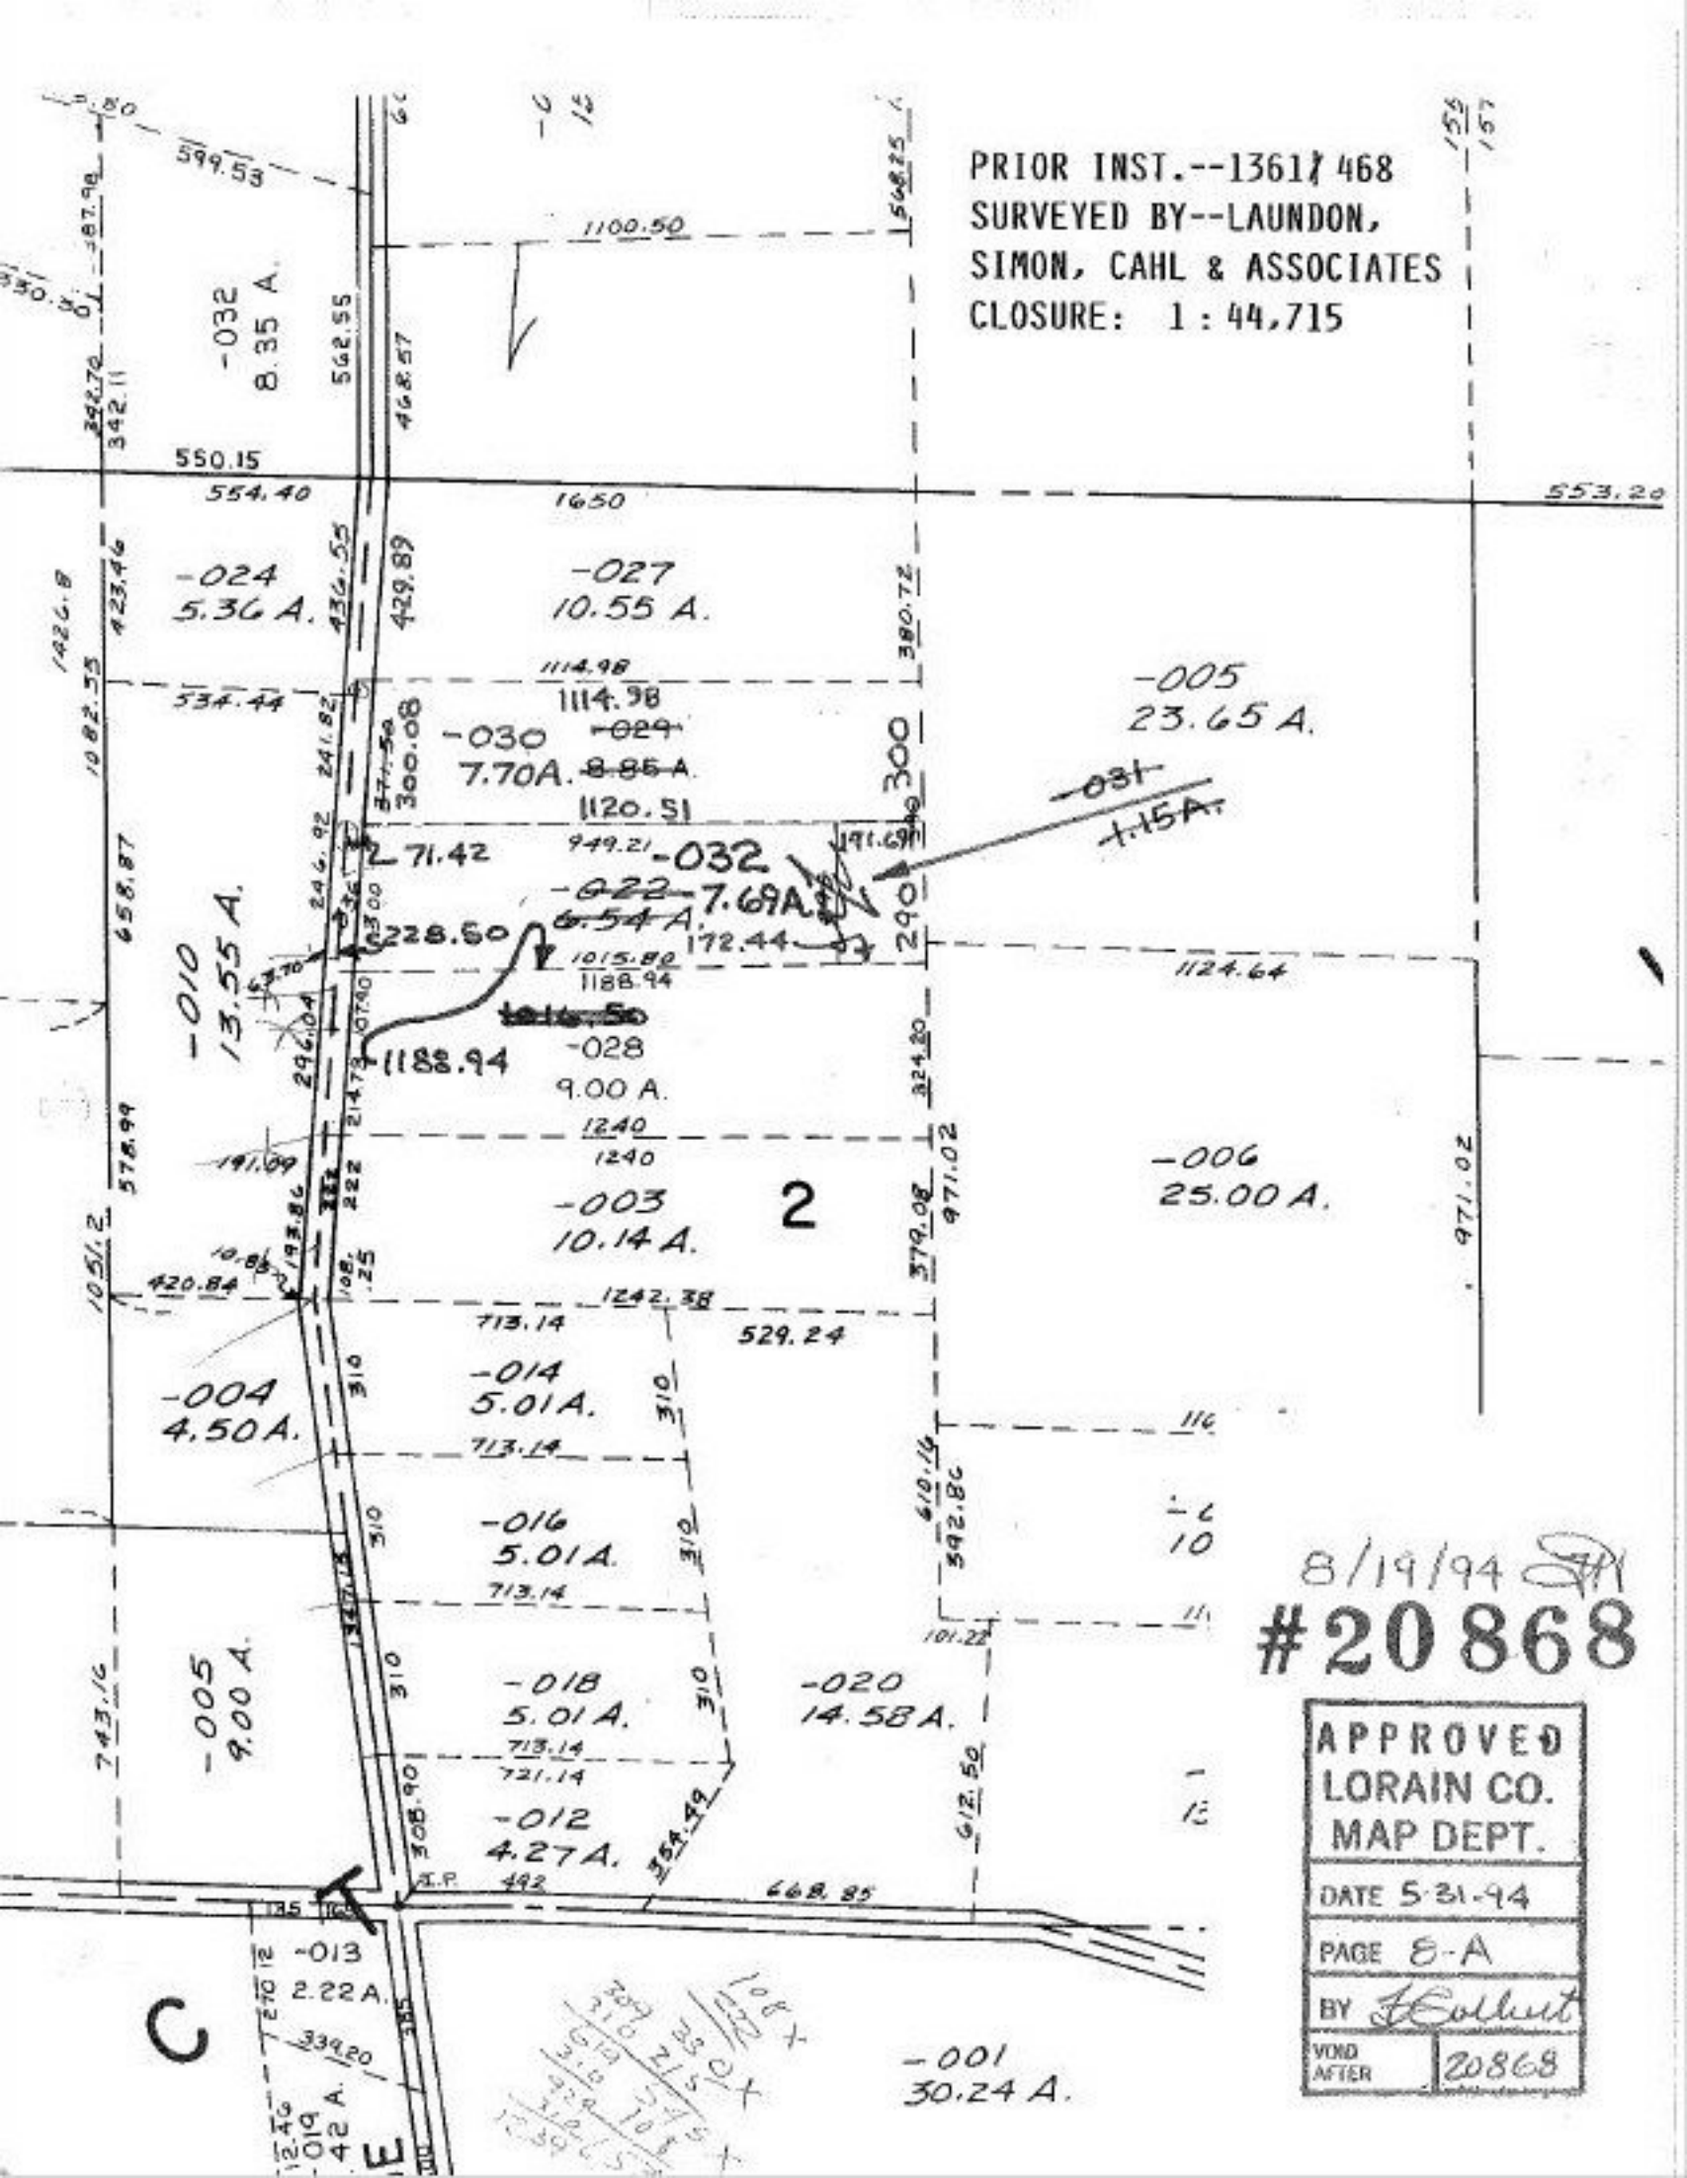
PRIOR INST.--1361/468
SURVEYED BY--LAUNDON, SIMON, CAHL & ASSOCIATES
CLOSURE: 1 : 44,715
-032 8.35 A.
-024 5.36 A.
-027 10.55 A.
-005 23.65 A.
-030 7.70A. 8.85 A.
-031 1.15A.
-032 7.69A. 6.54 A.
-010 13.55 A.
-028 9.00 A.
-003 10.14 A.
2
-006 25.00 A.
-004 4.50A.
-014 5.01A.
-016 5.01A.
-005 9.00 A.
-018 5.01 A.
-020 14.58 A.
-012 4.27A.
-013 2.22 A.
-001 30.24 A.
C
E
8/19/94
#20868
APPROVED
LORAIN CO.
MAP DEPT.
DATE 5-31-94
PAGE 8-A
BY
VOID AFTER 20868