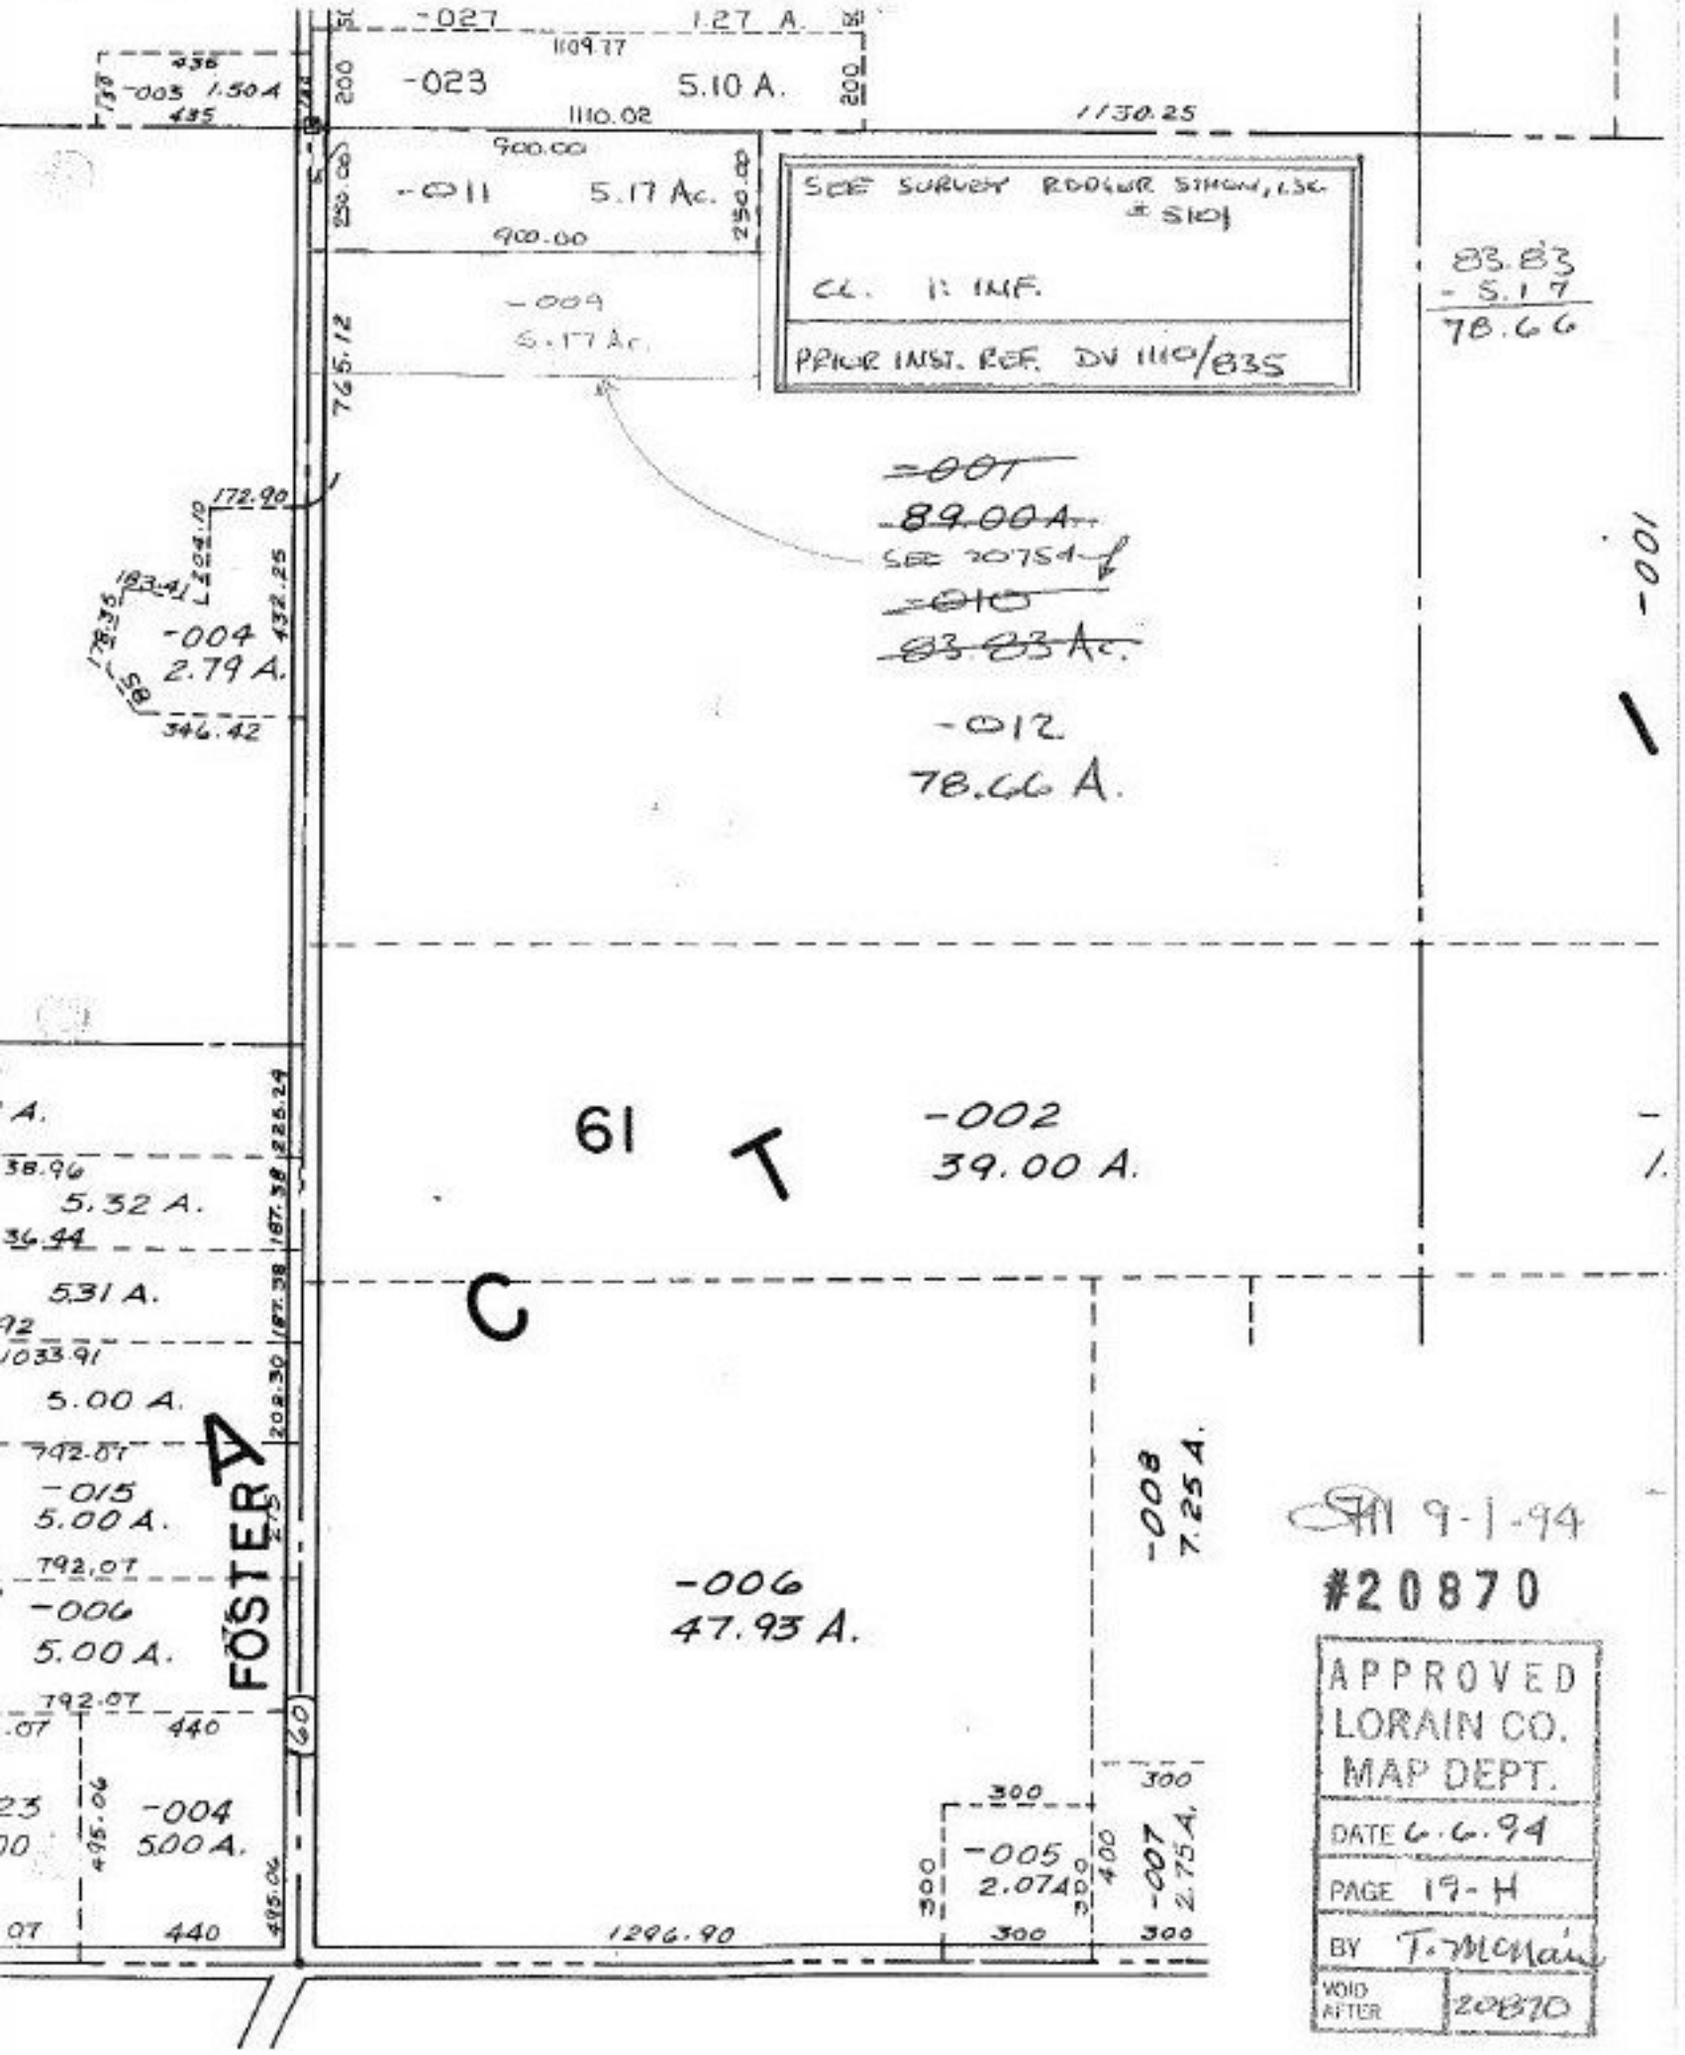

9-1-94

#20870

APPROVED
LORAIN CO.
MAP DEPT.
DATE 6.6.94
PAGE 19-H
BY T. McMain
VOID AFTER 20870