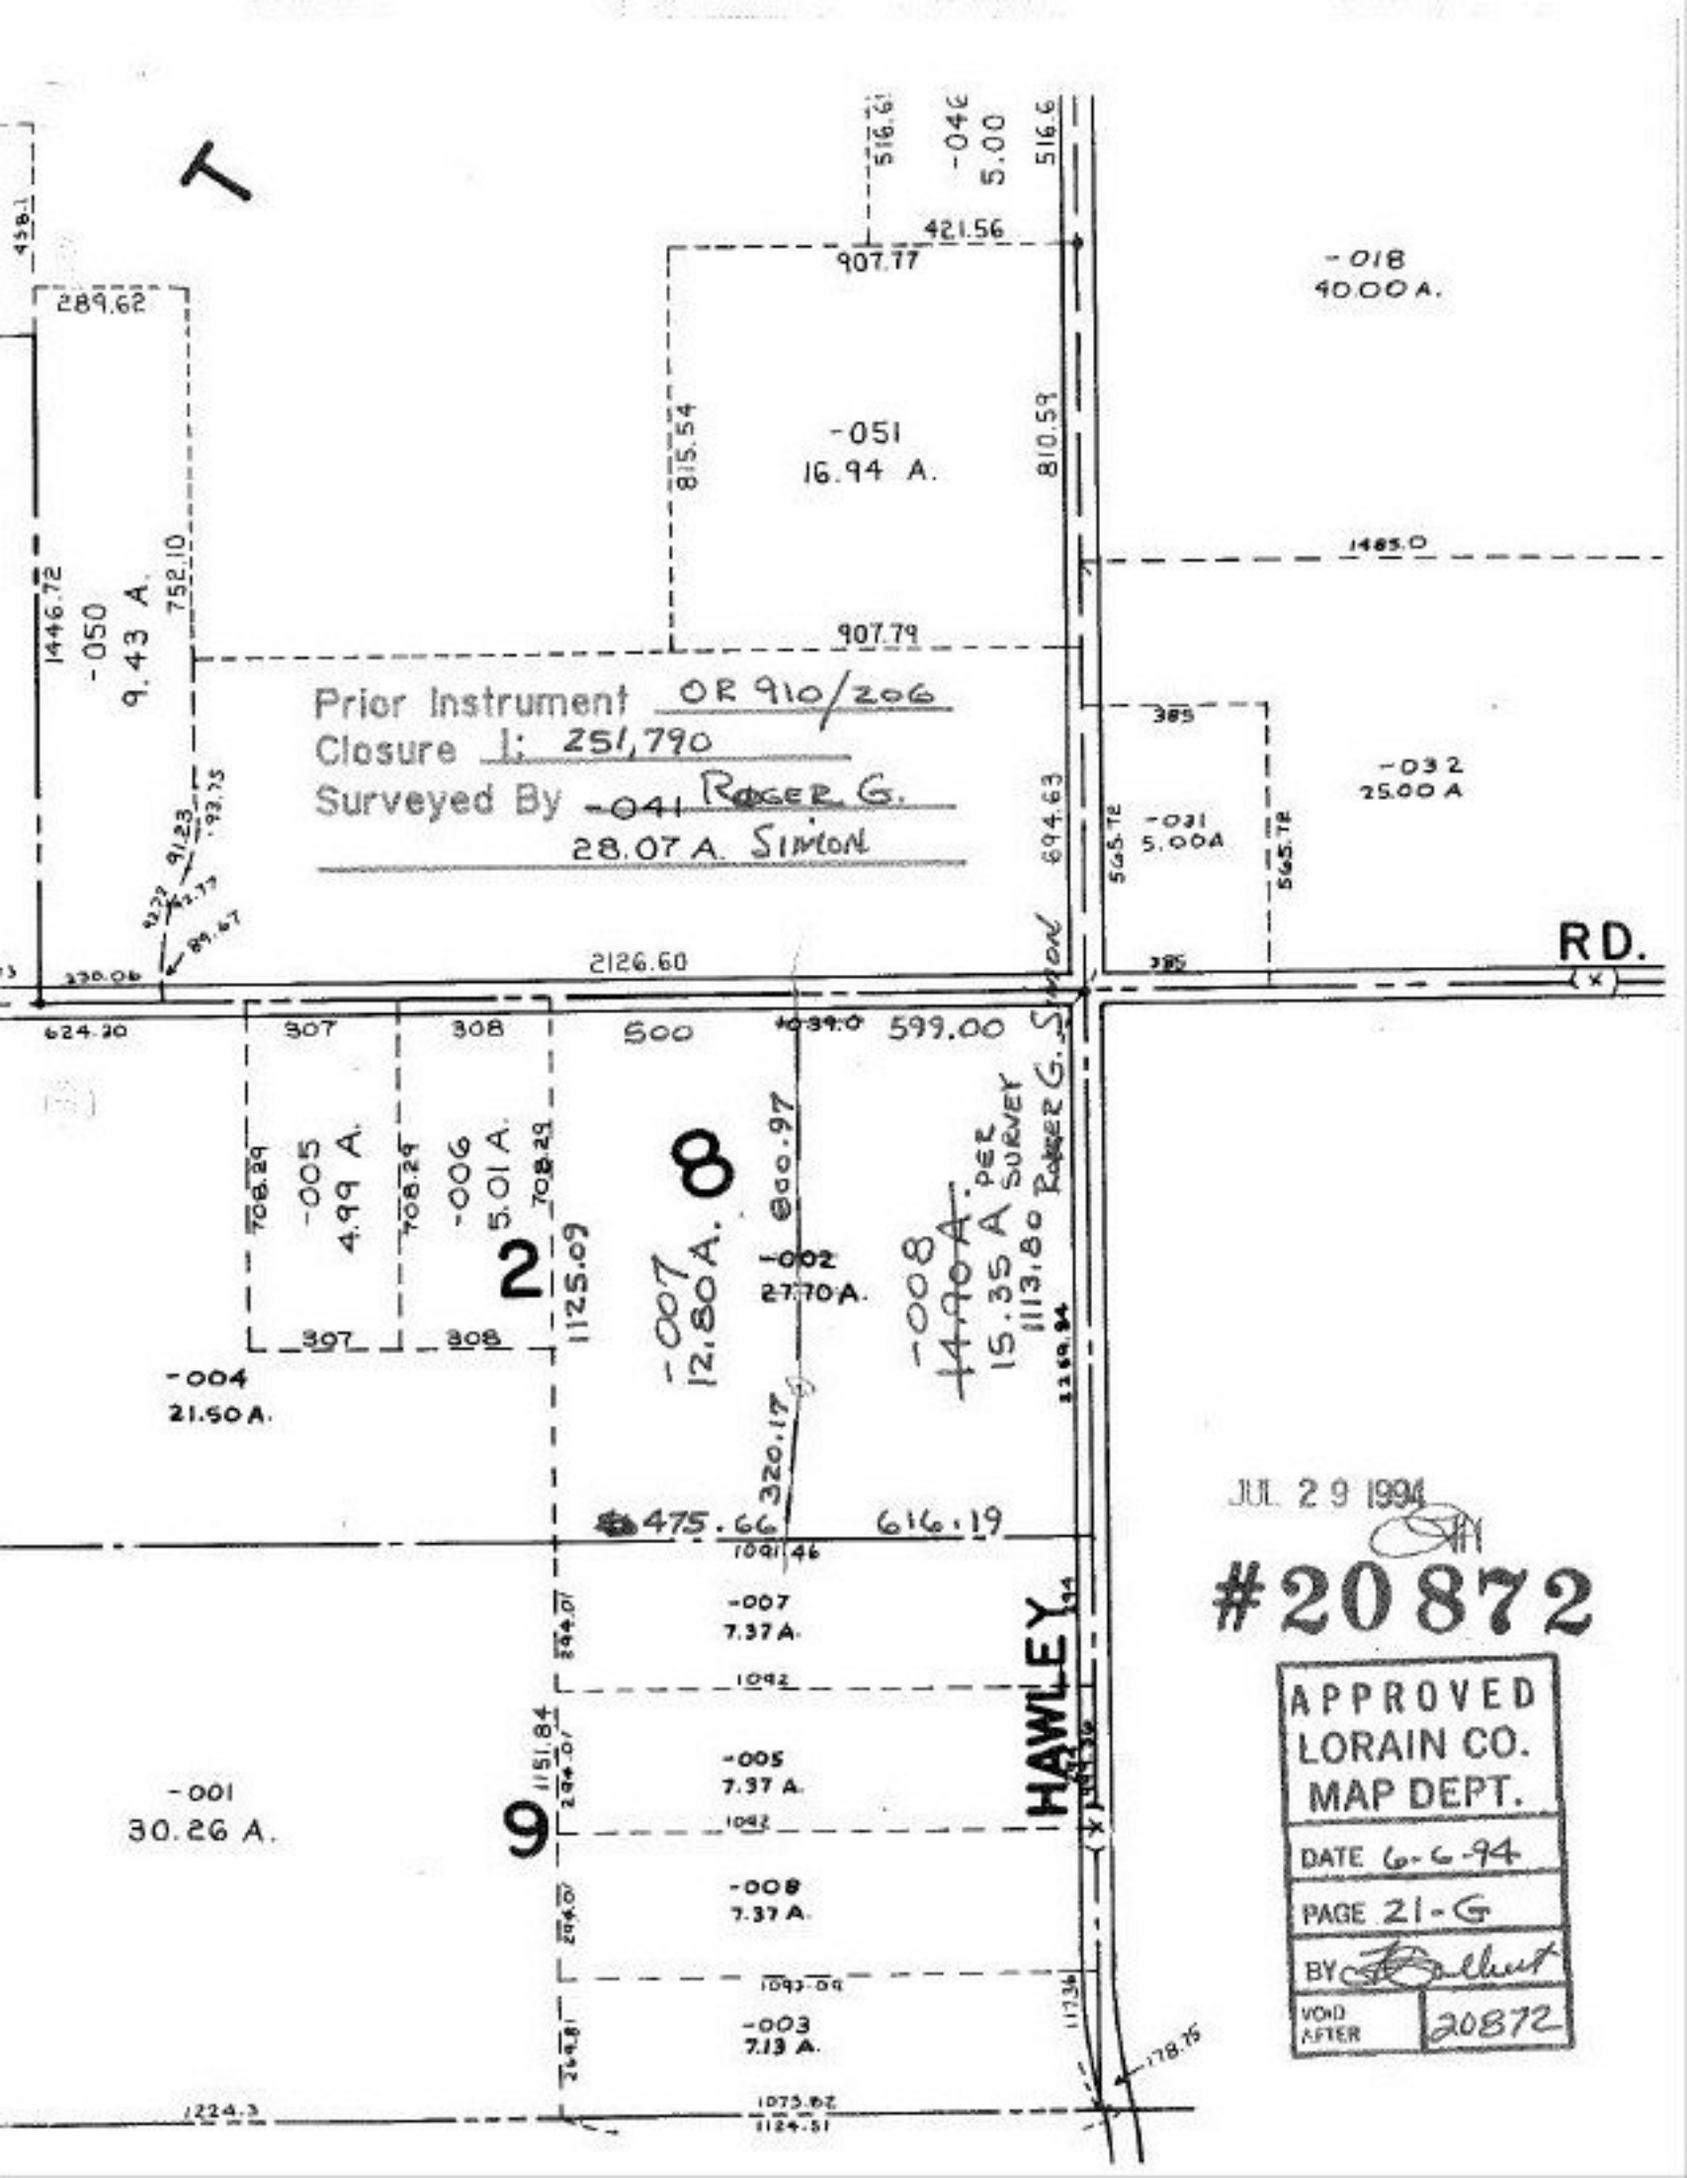

JUL 29 1994

#20872

APPROVED
LORAIN CO.
MAP DEPT.

DATE 6-6-94

PAGE 21-G

BY

VOID AFTER 20872