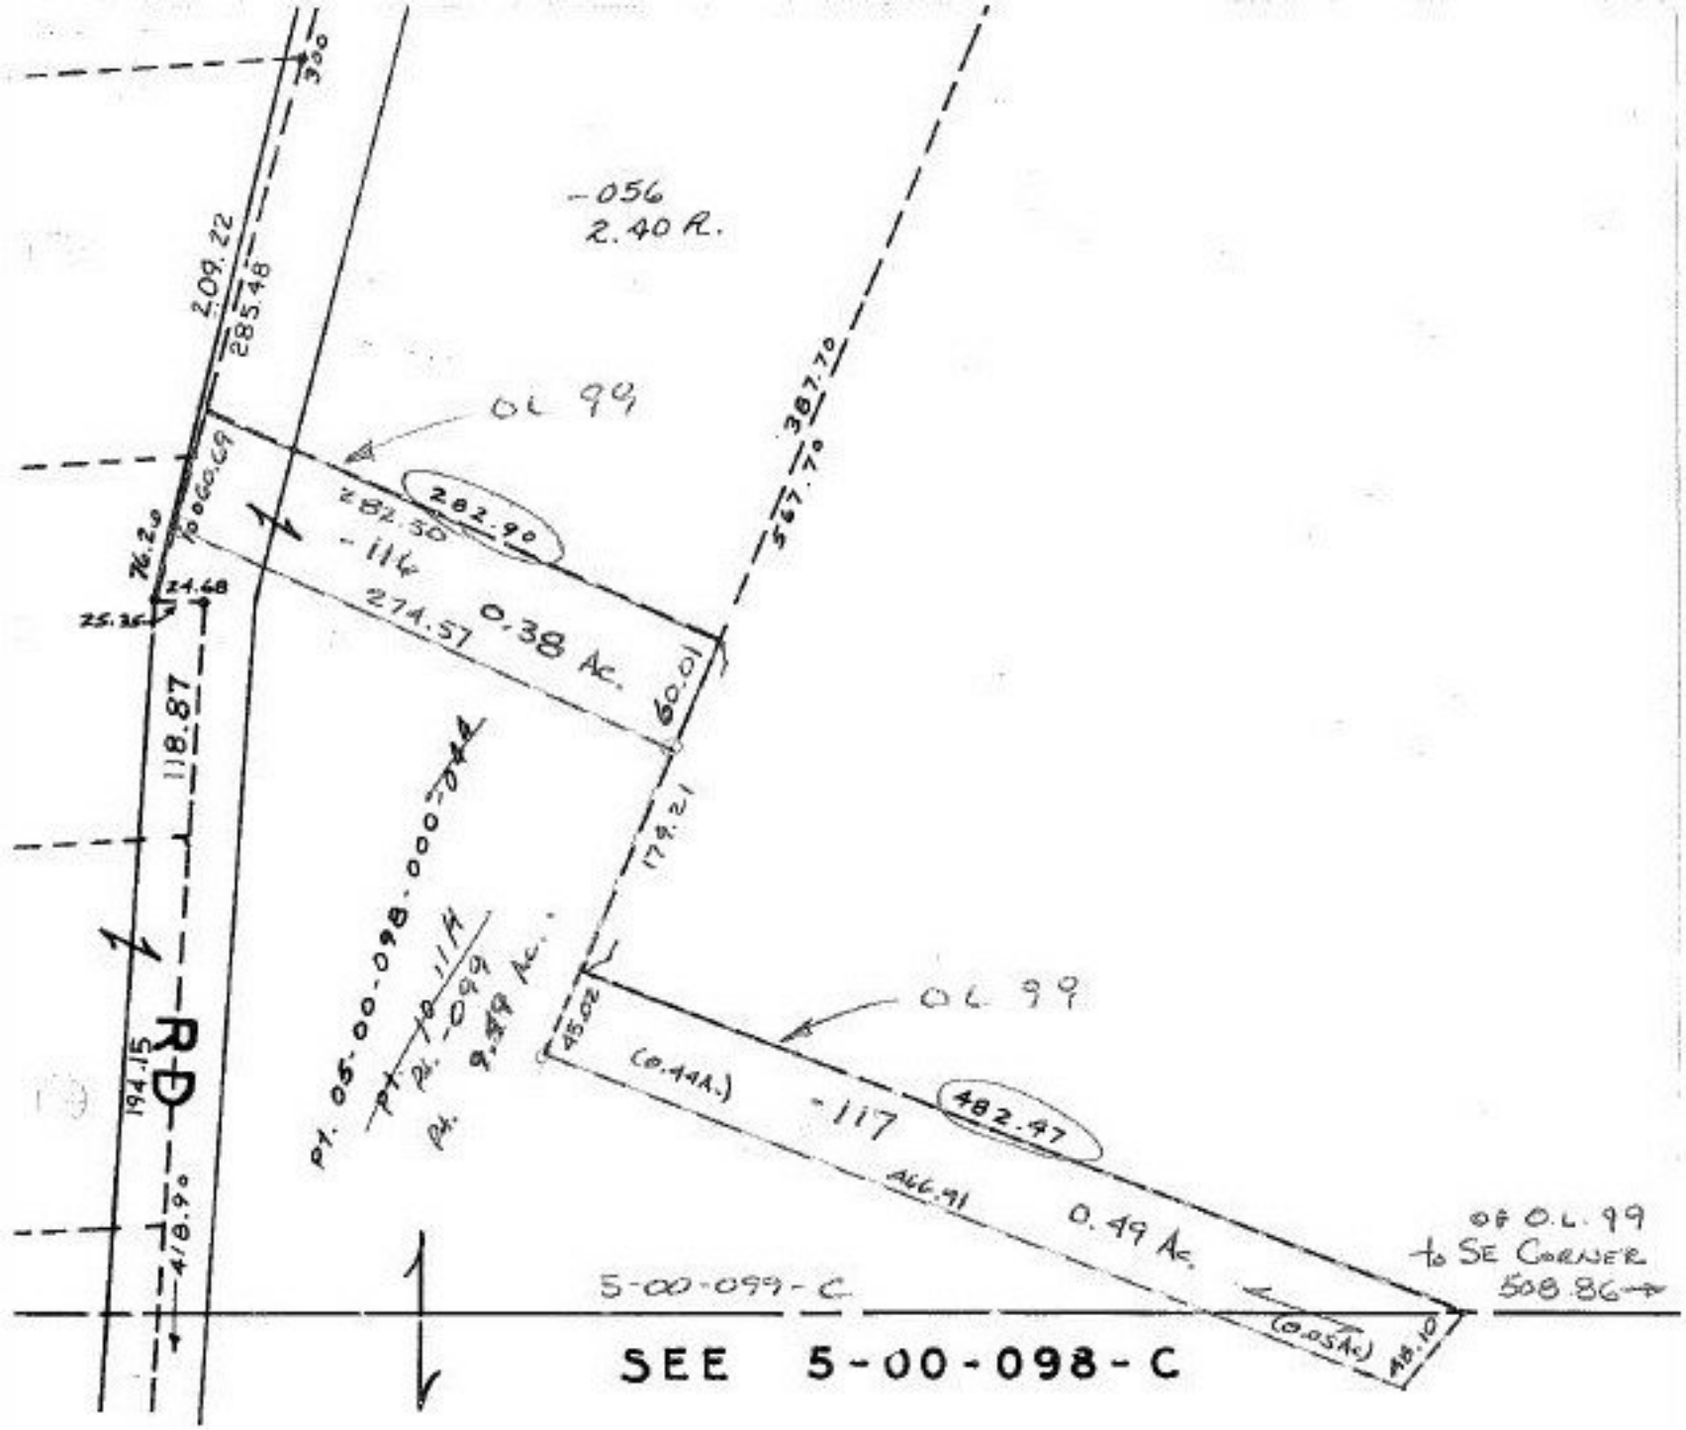

Prior Instrument _____

Closure @ I: 148,673 @ I: 359,538

Surveyed By Roger G. Simon, L.S.

9-7-94

#20883

APPROVED
LORAIN CO.
MAP DEPT.
DATE 6-15-94
PAGE 5-00-099-C
BY T. McMain
MAP # 20883