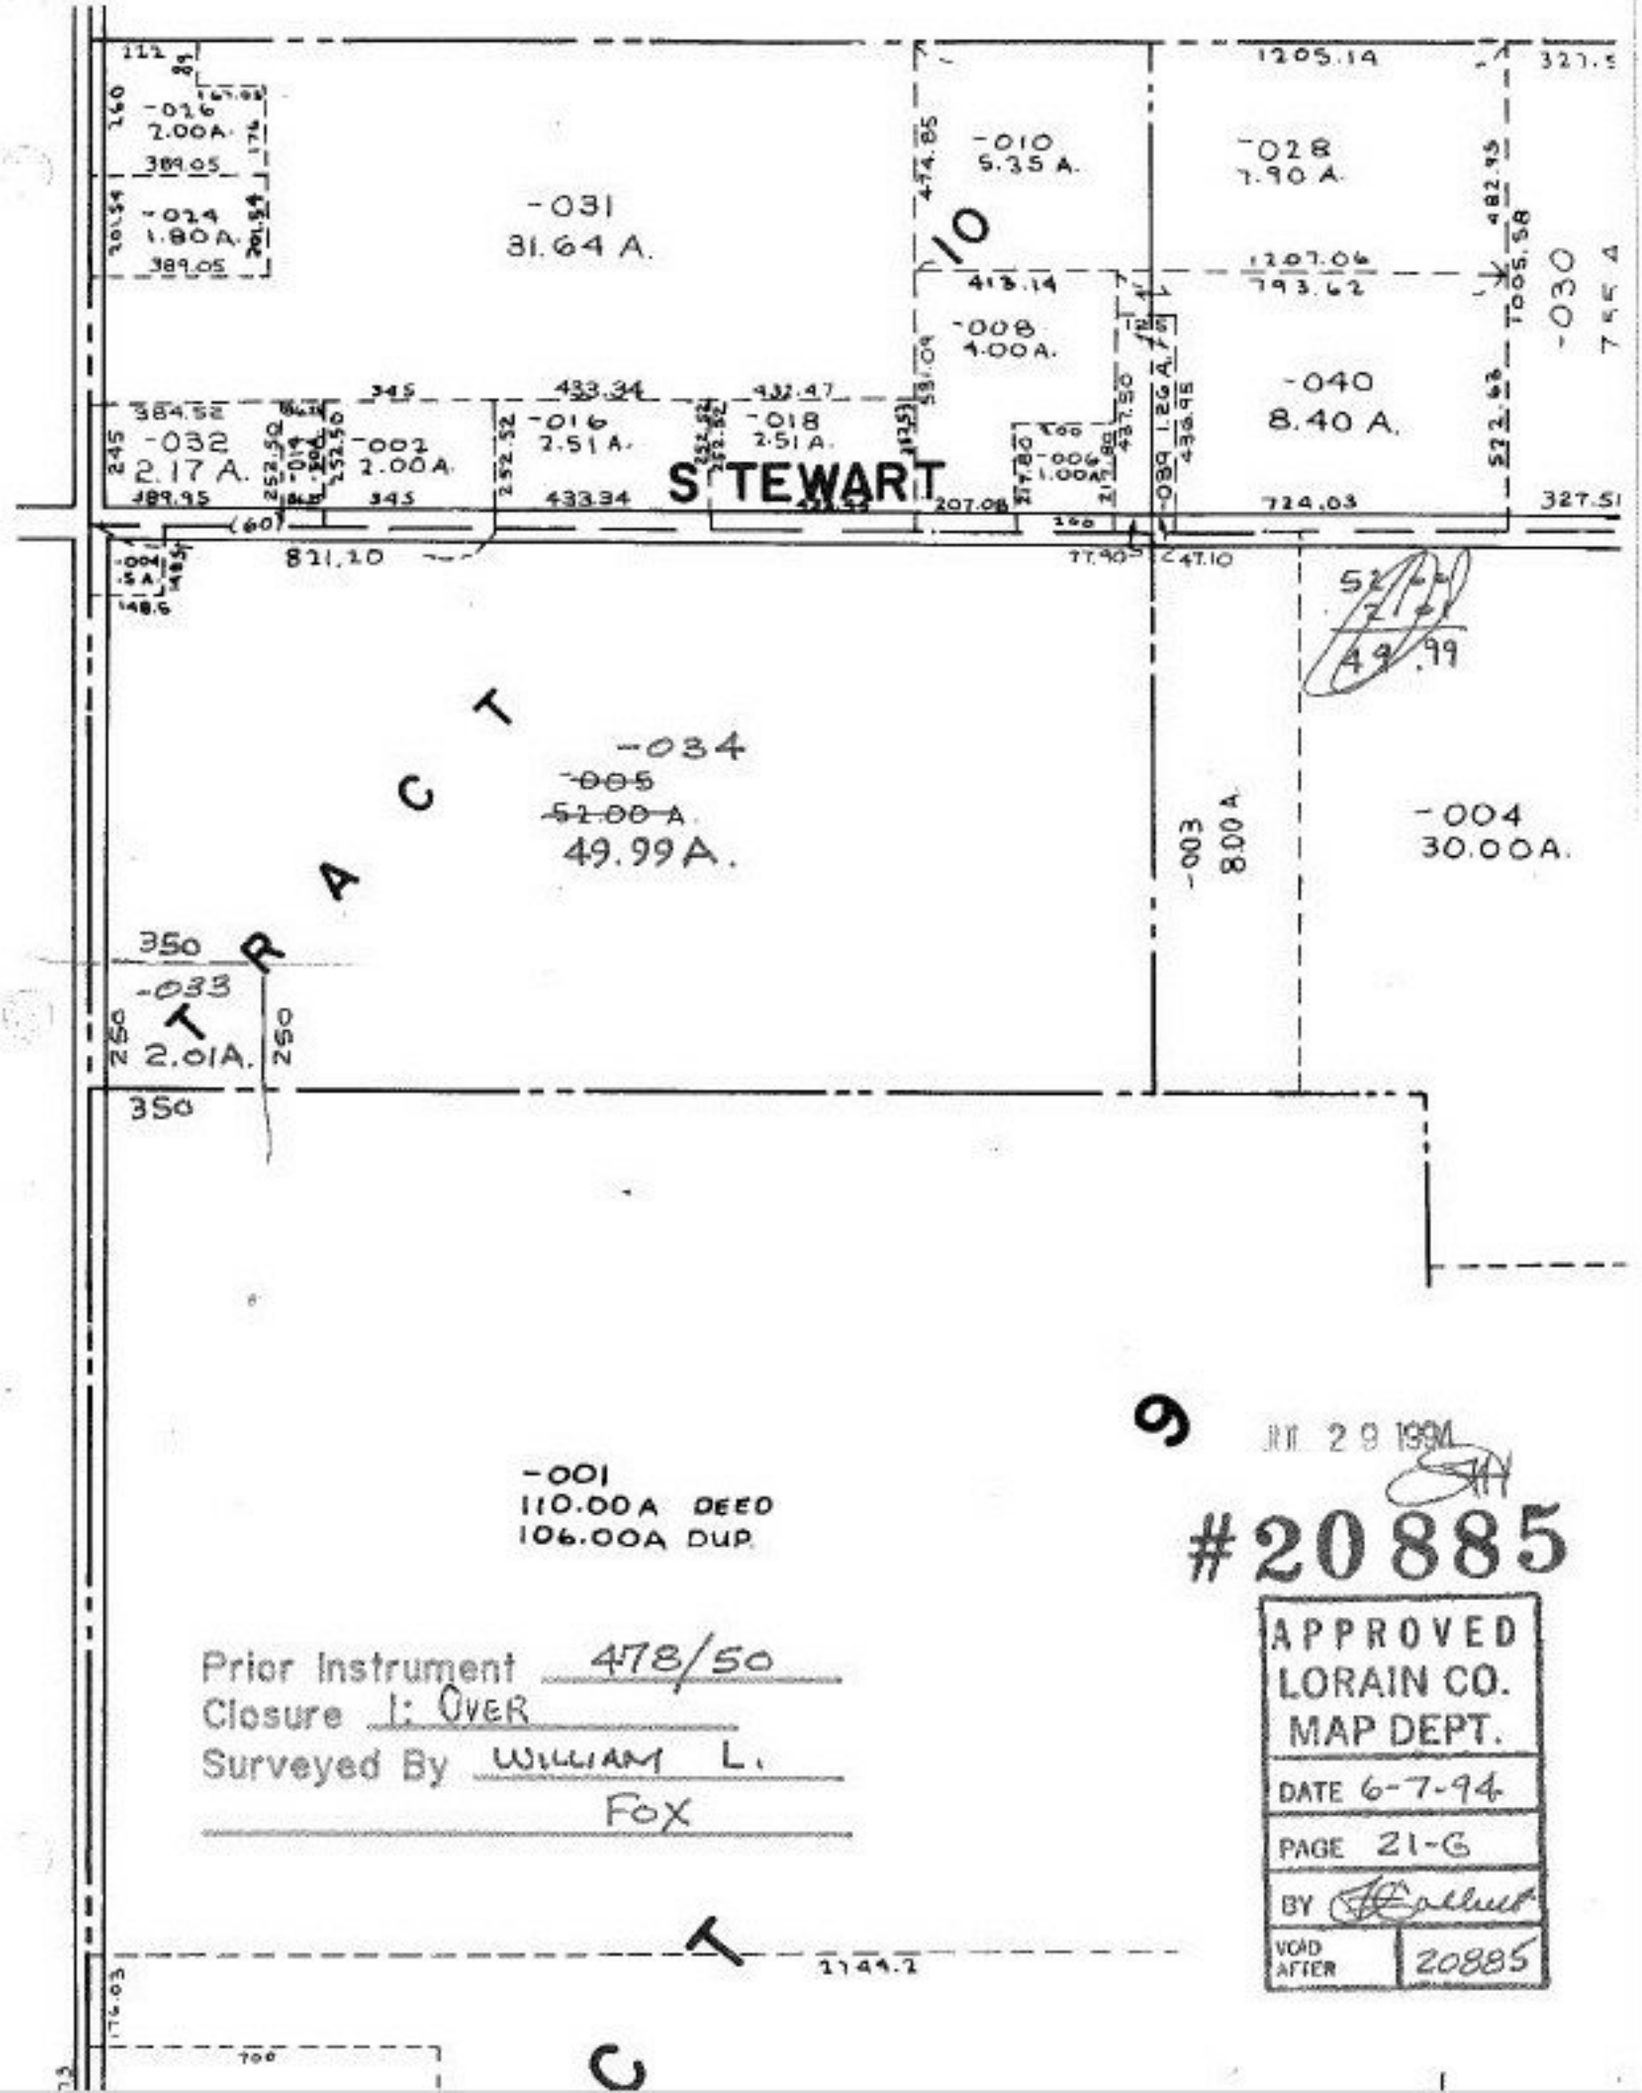
-031
81.64 A.
-010
5.35 A.
-028
7.90 A.
-030
-008
4.00A.
-040
8.40 A.
-032
2.17 A.
-002
2.00A.
-016
2.51 A.
-018
2.51 A.
STEWART
-034
-005
~~51.00 A.~~
49.99A.
-003
8.00 A.
-004
30.00A.
-033
2.01A.
TRACT
-001
110.00A DEED
106.00A DUP.
9
10
JUL 29 1994
#20885
APPROVED
LORAIN CO.
MAP DEPT.
DATE 6-7-94
PAGE 21-G
BY
VOID AFTER 20885
Prior Instrument 478/50
Closure 1: OVER
Surveyed By WILLIAM L. FOX