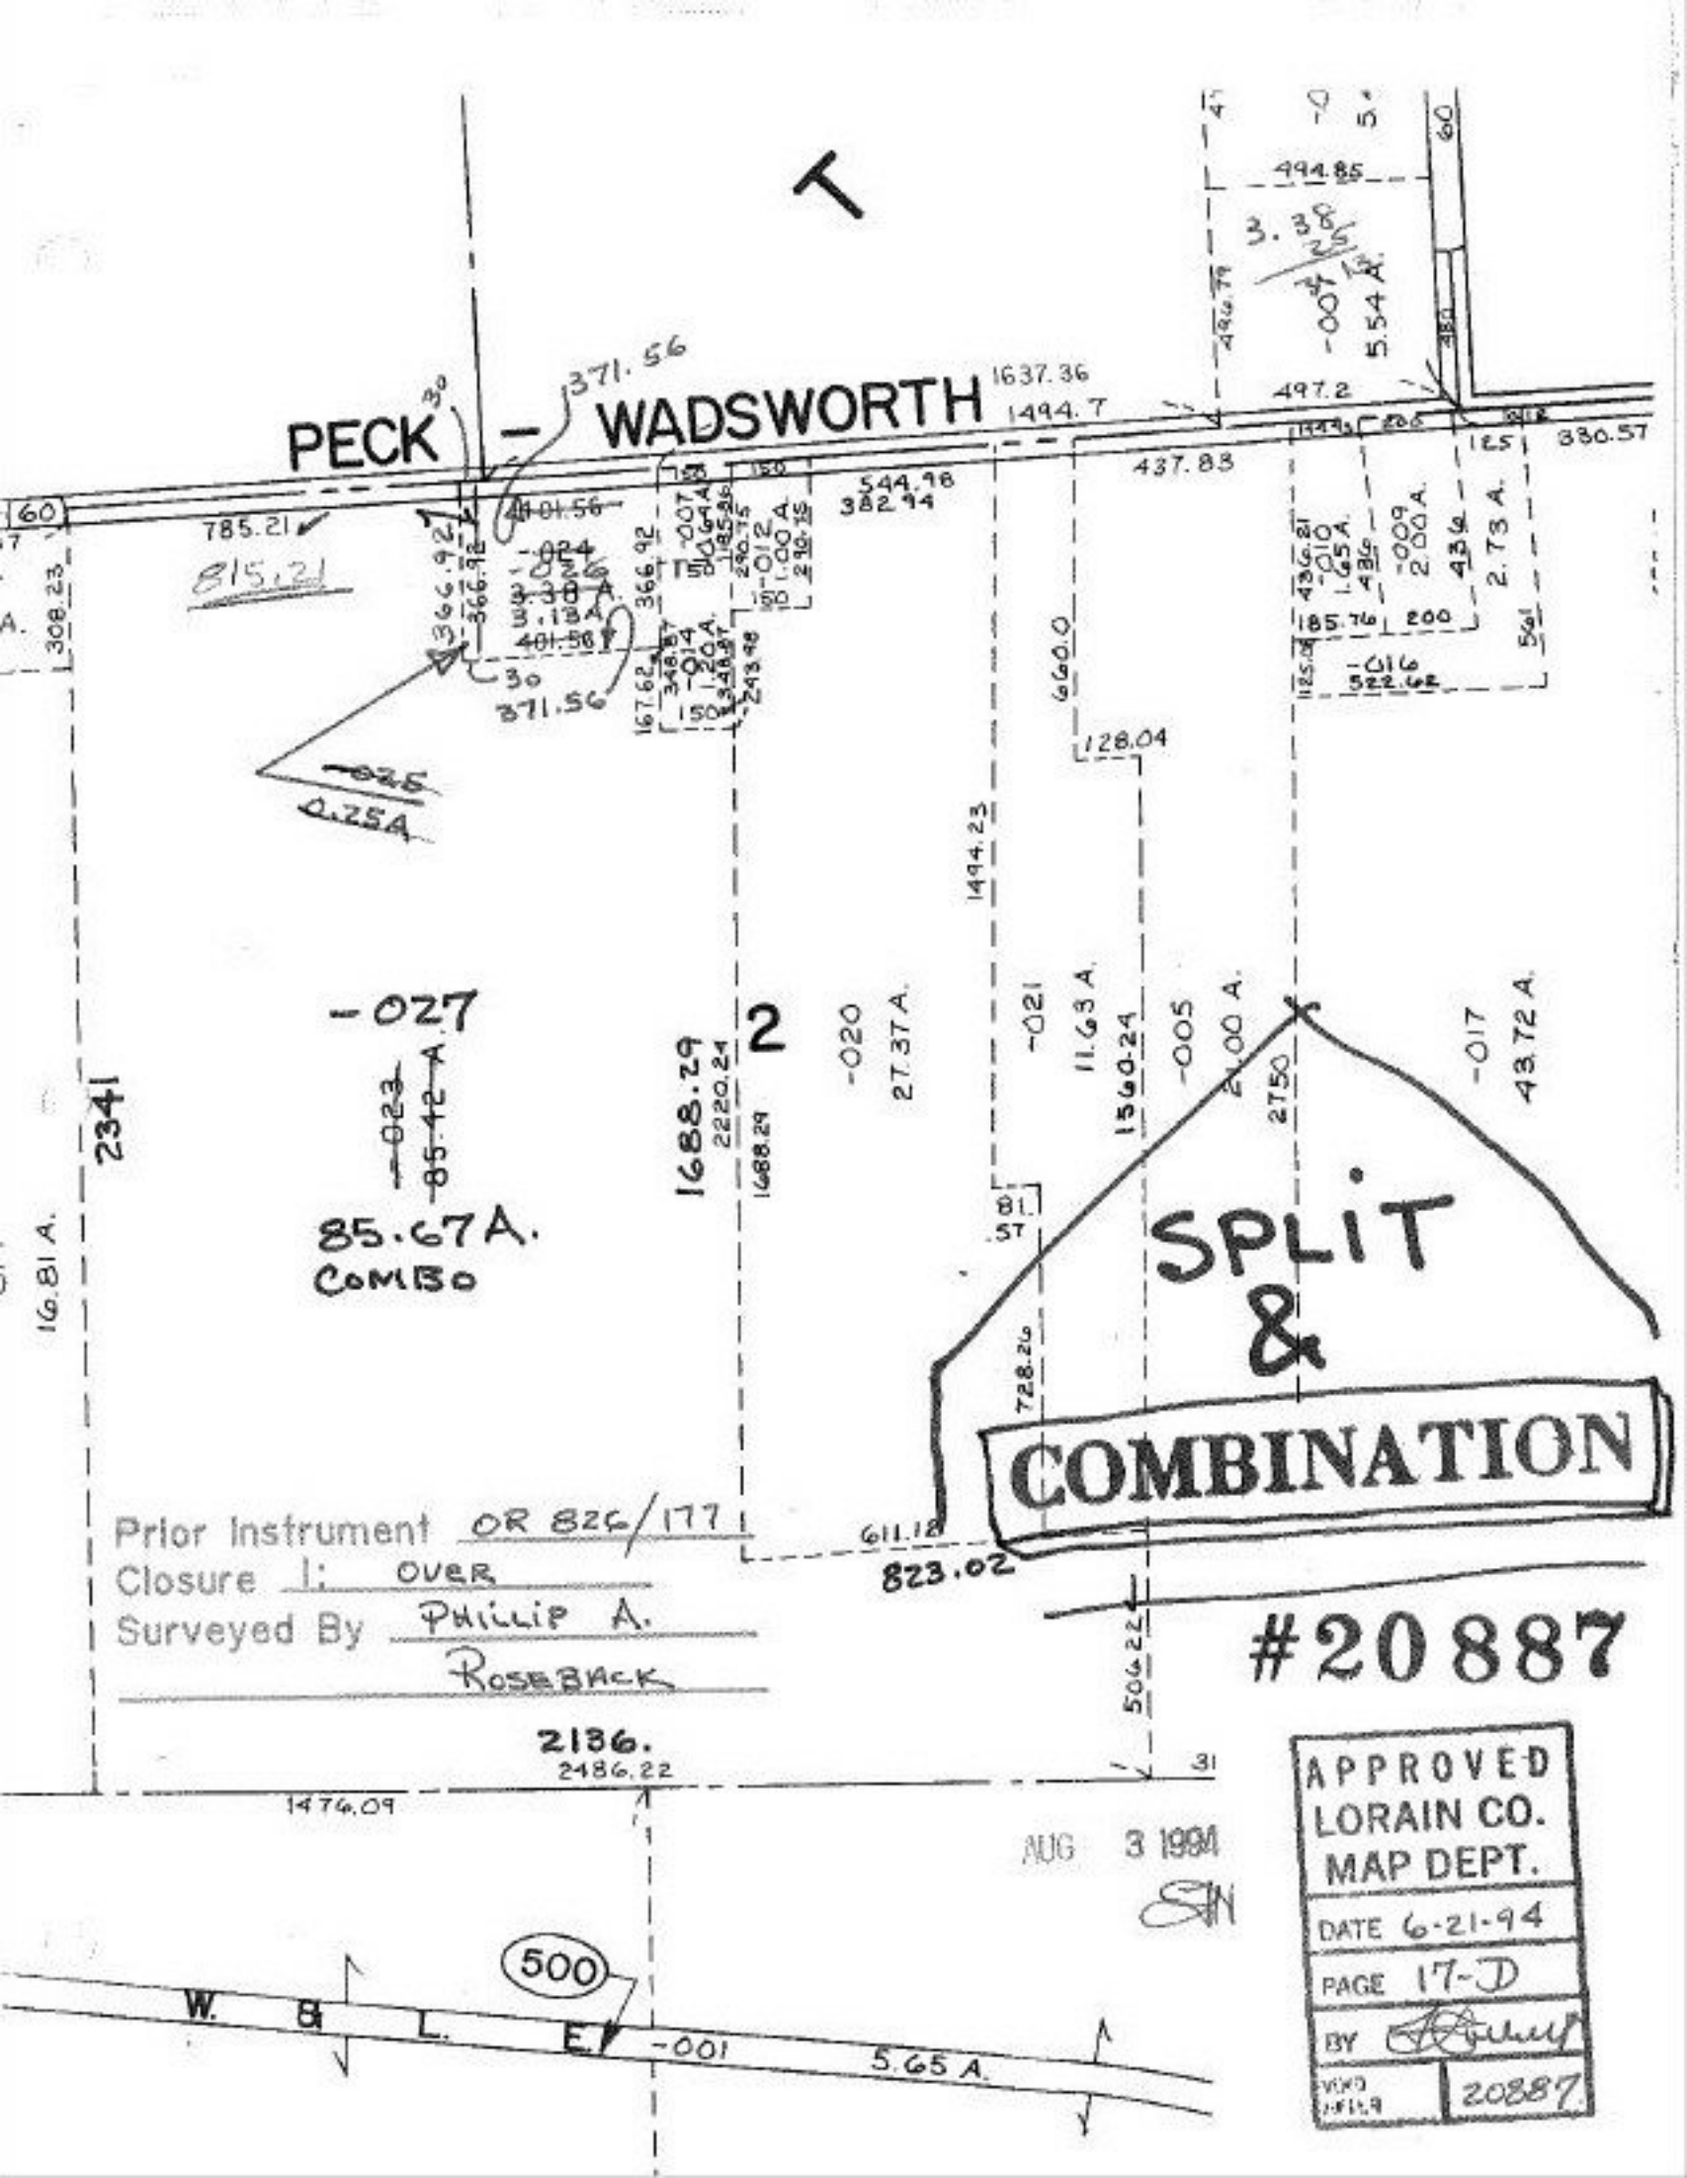

Prior Instrument OR 826/177
Closure 1: OVER
Surveyed By PHILLIP A. ROSEBACK