-001
16.19A.

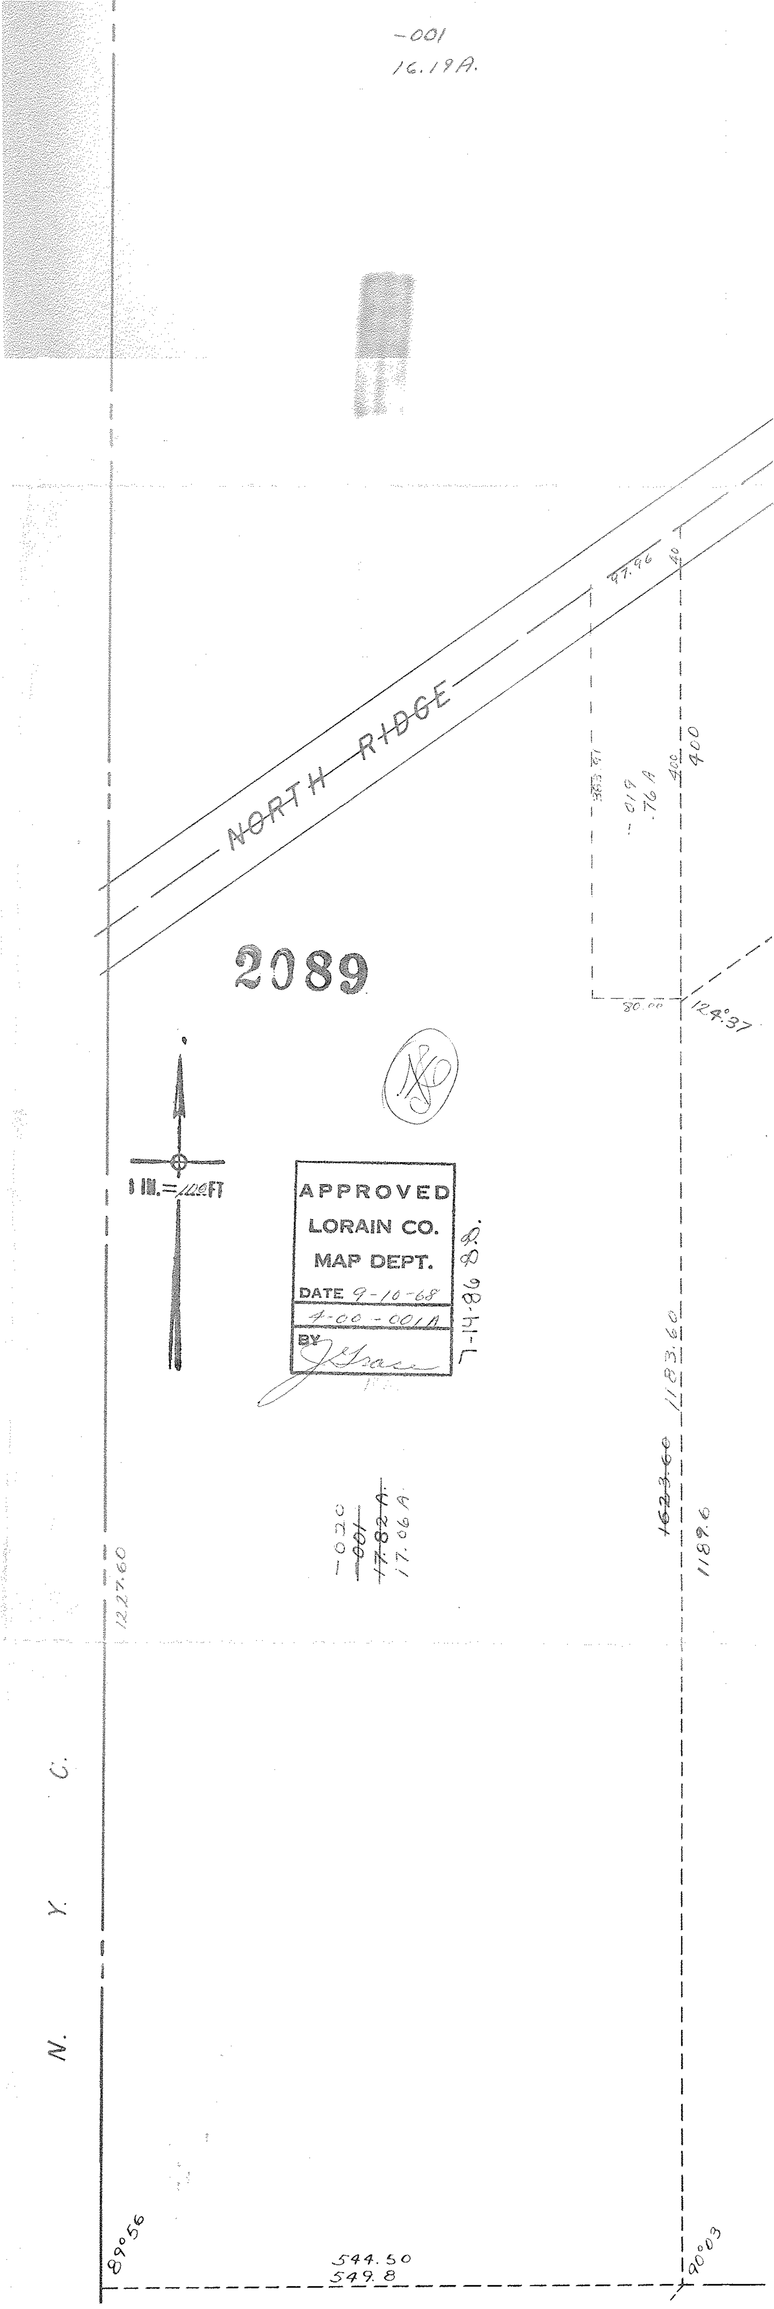

AVON VILLAGE

SCALE: 1" = 100'