20890 -A

Lake

SEE SURVEY H.G. HOPA, JUNE '93
S/L 57, 58, & PT. 59 WERE SURVEYED. I.P.'S SET ON N. LINE OF EDGEWATER DR. & AT TOP OF BANK ALONG EDGE OF LAKE.
PRIOR INST. Ref - OR 425, Pg. 267

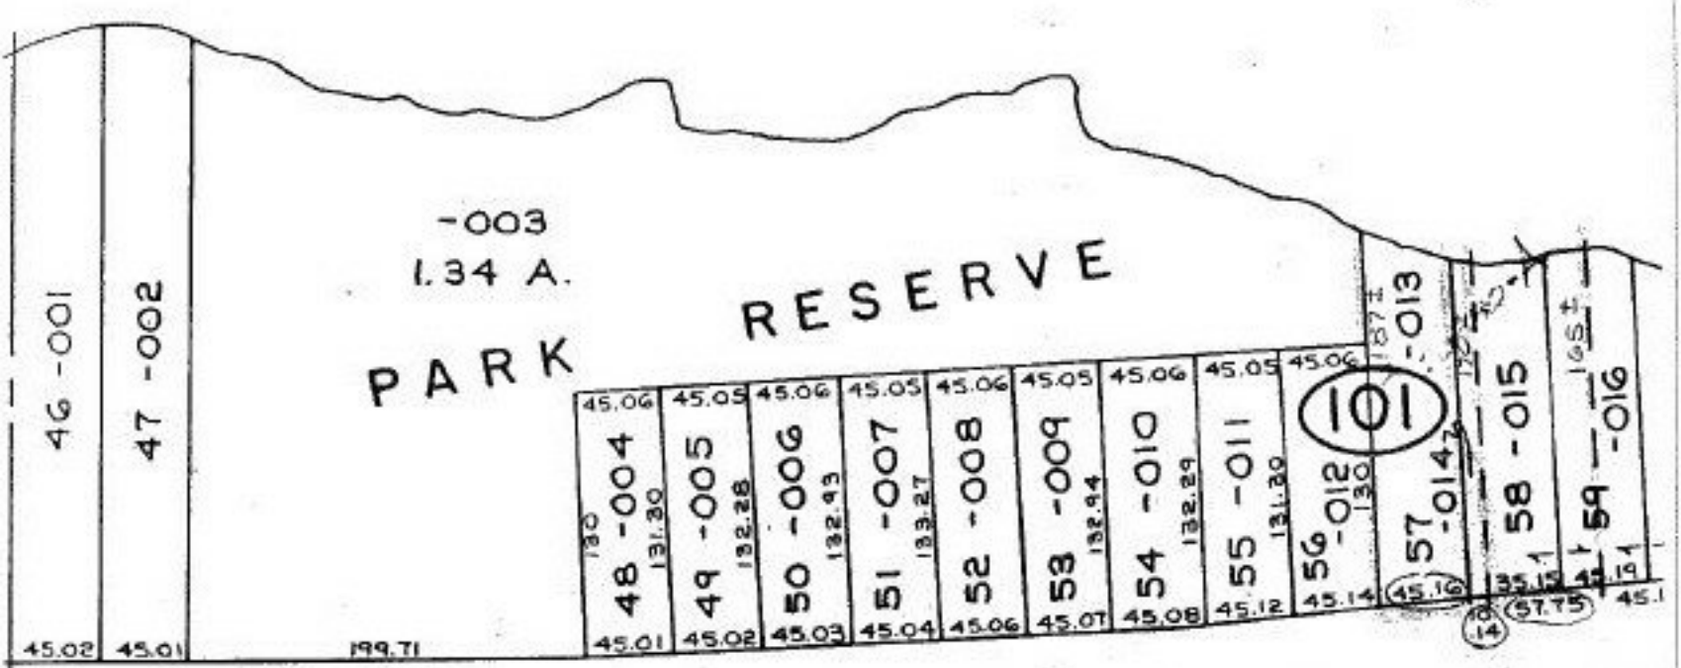

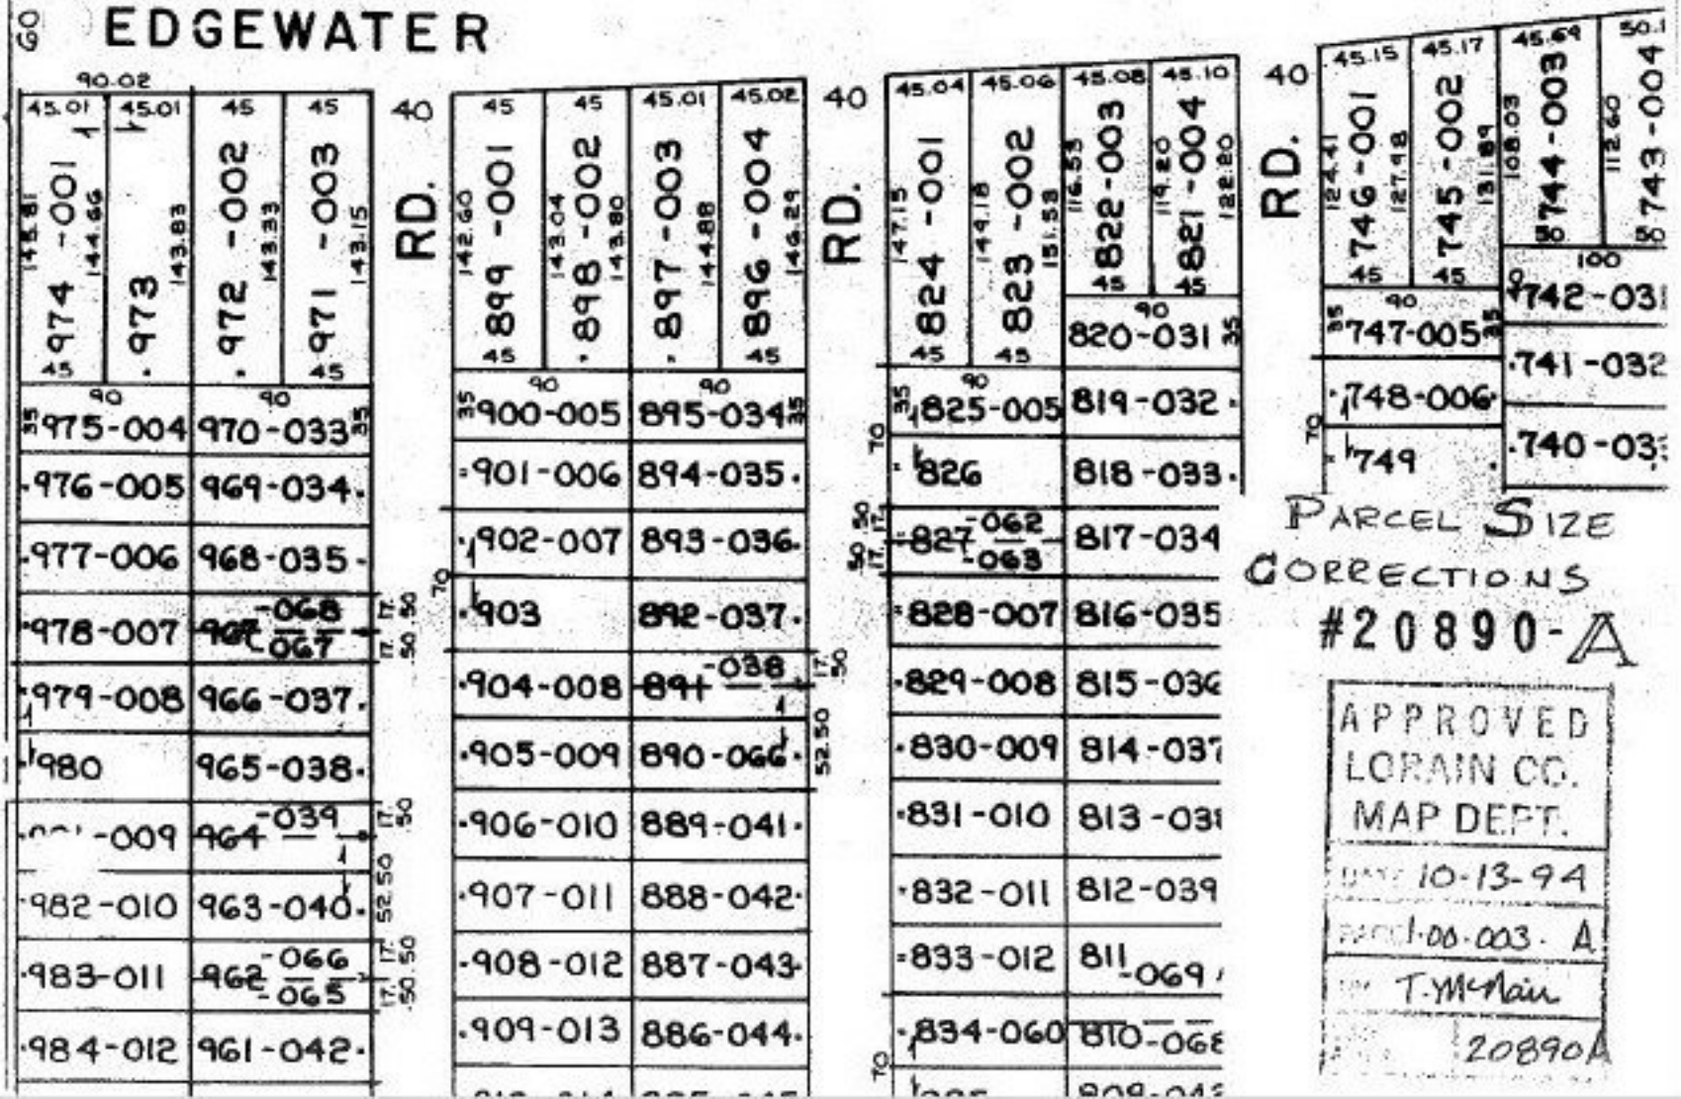

PARCEL SIZE CORRECTIONS
#20890-A

APPROVED
LORAIN CO.
MAP DEPT.
DATE 10-13-94
PARCEL 1-00-003. A
BY T. McMain
20890A