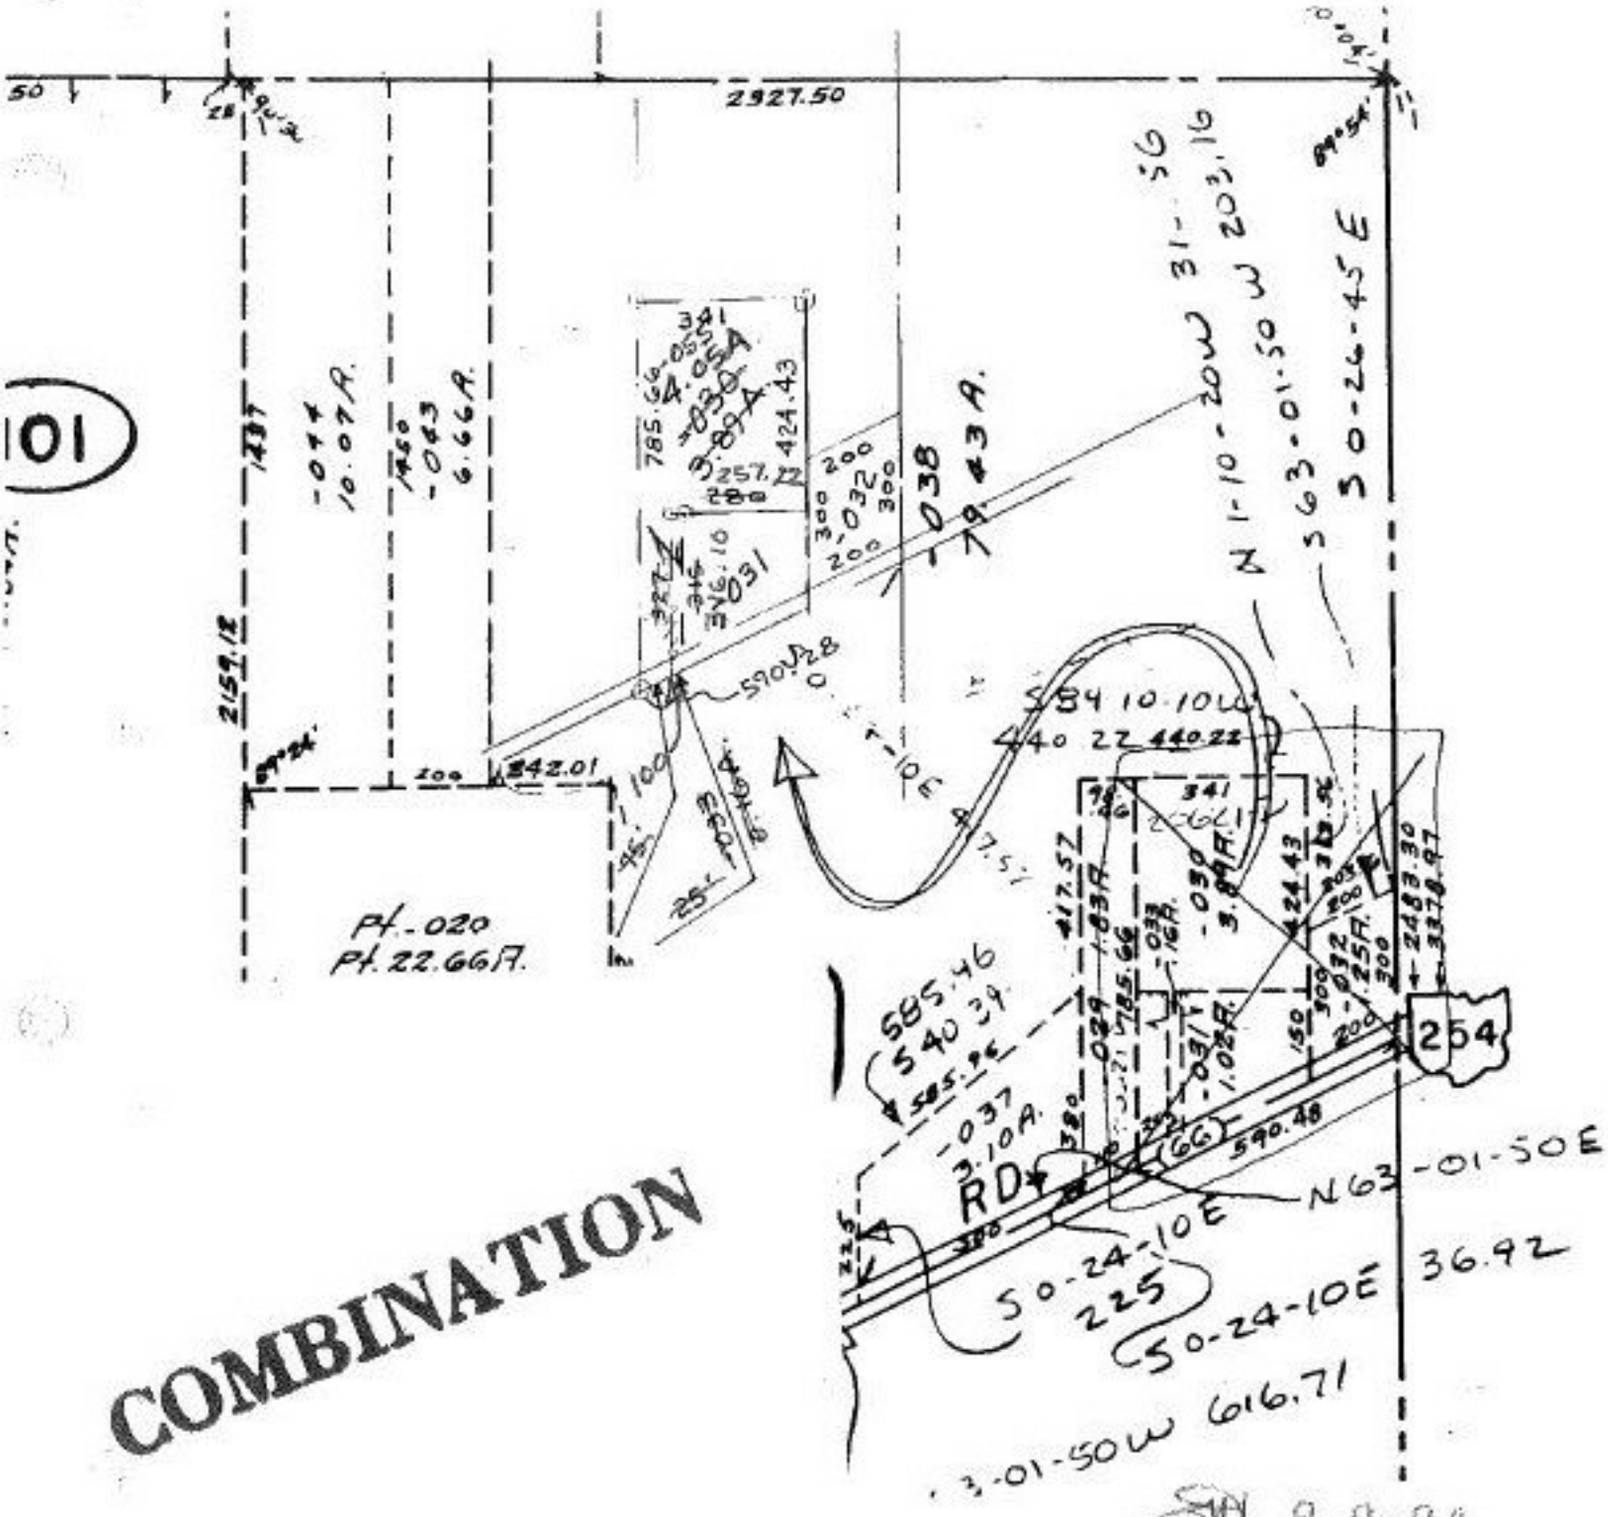

SM 9-9-94

#20892

APPROVED
LORAIN CO.
MAP DEPT.

DATE 6-21-94

PAGE 4-H

BY

VOID AFTER 20892