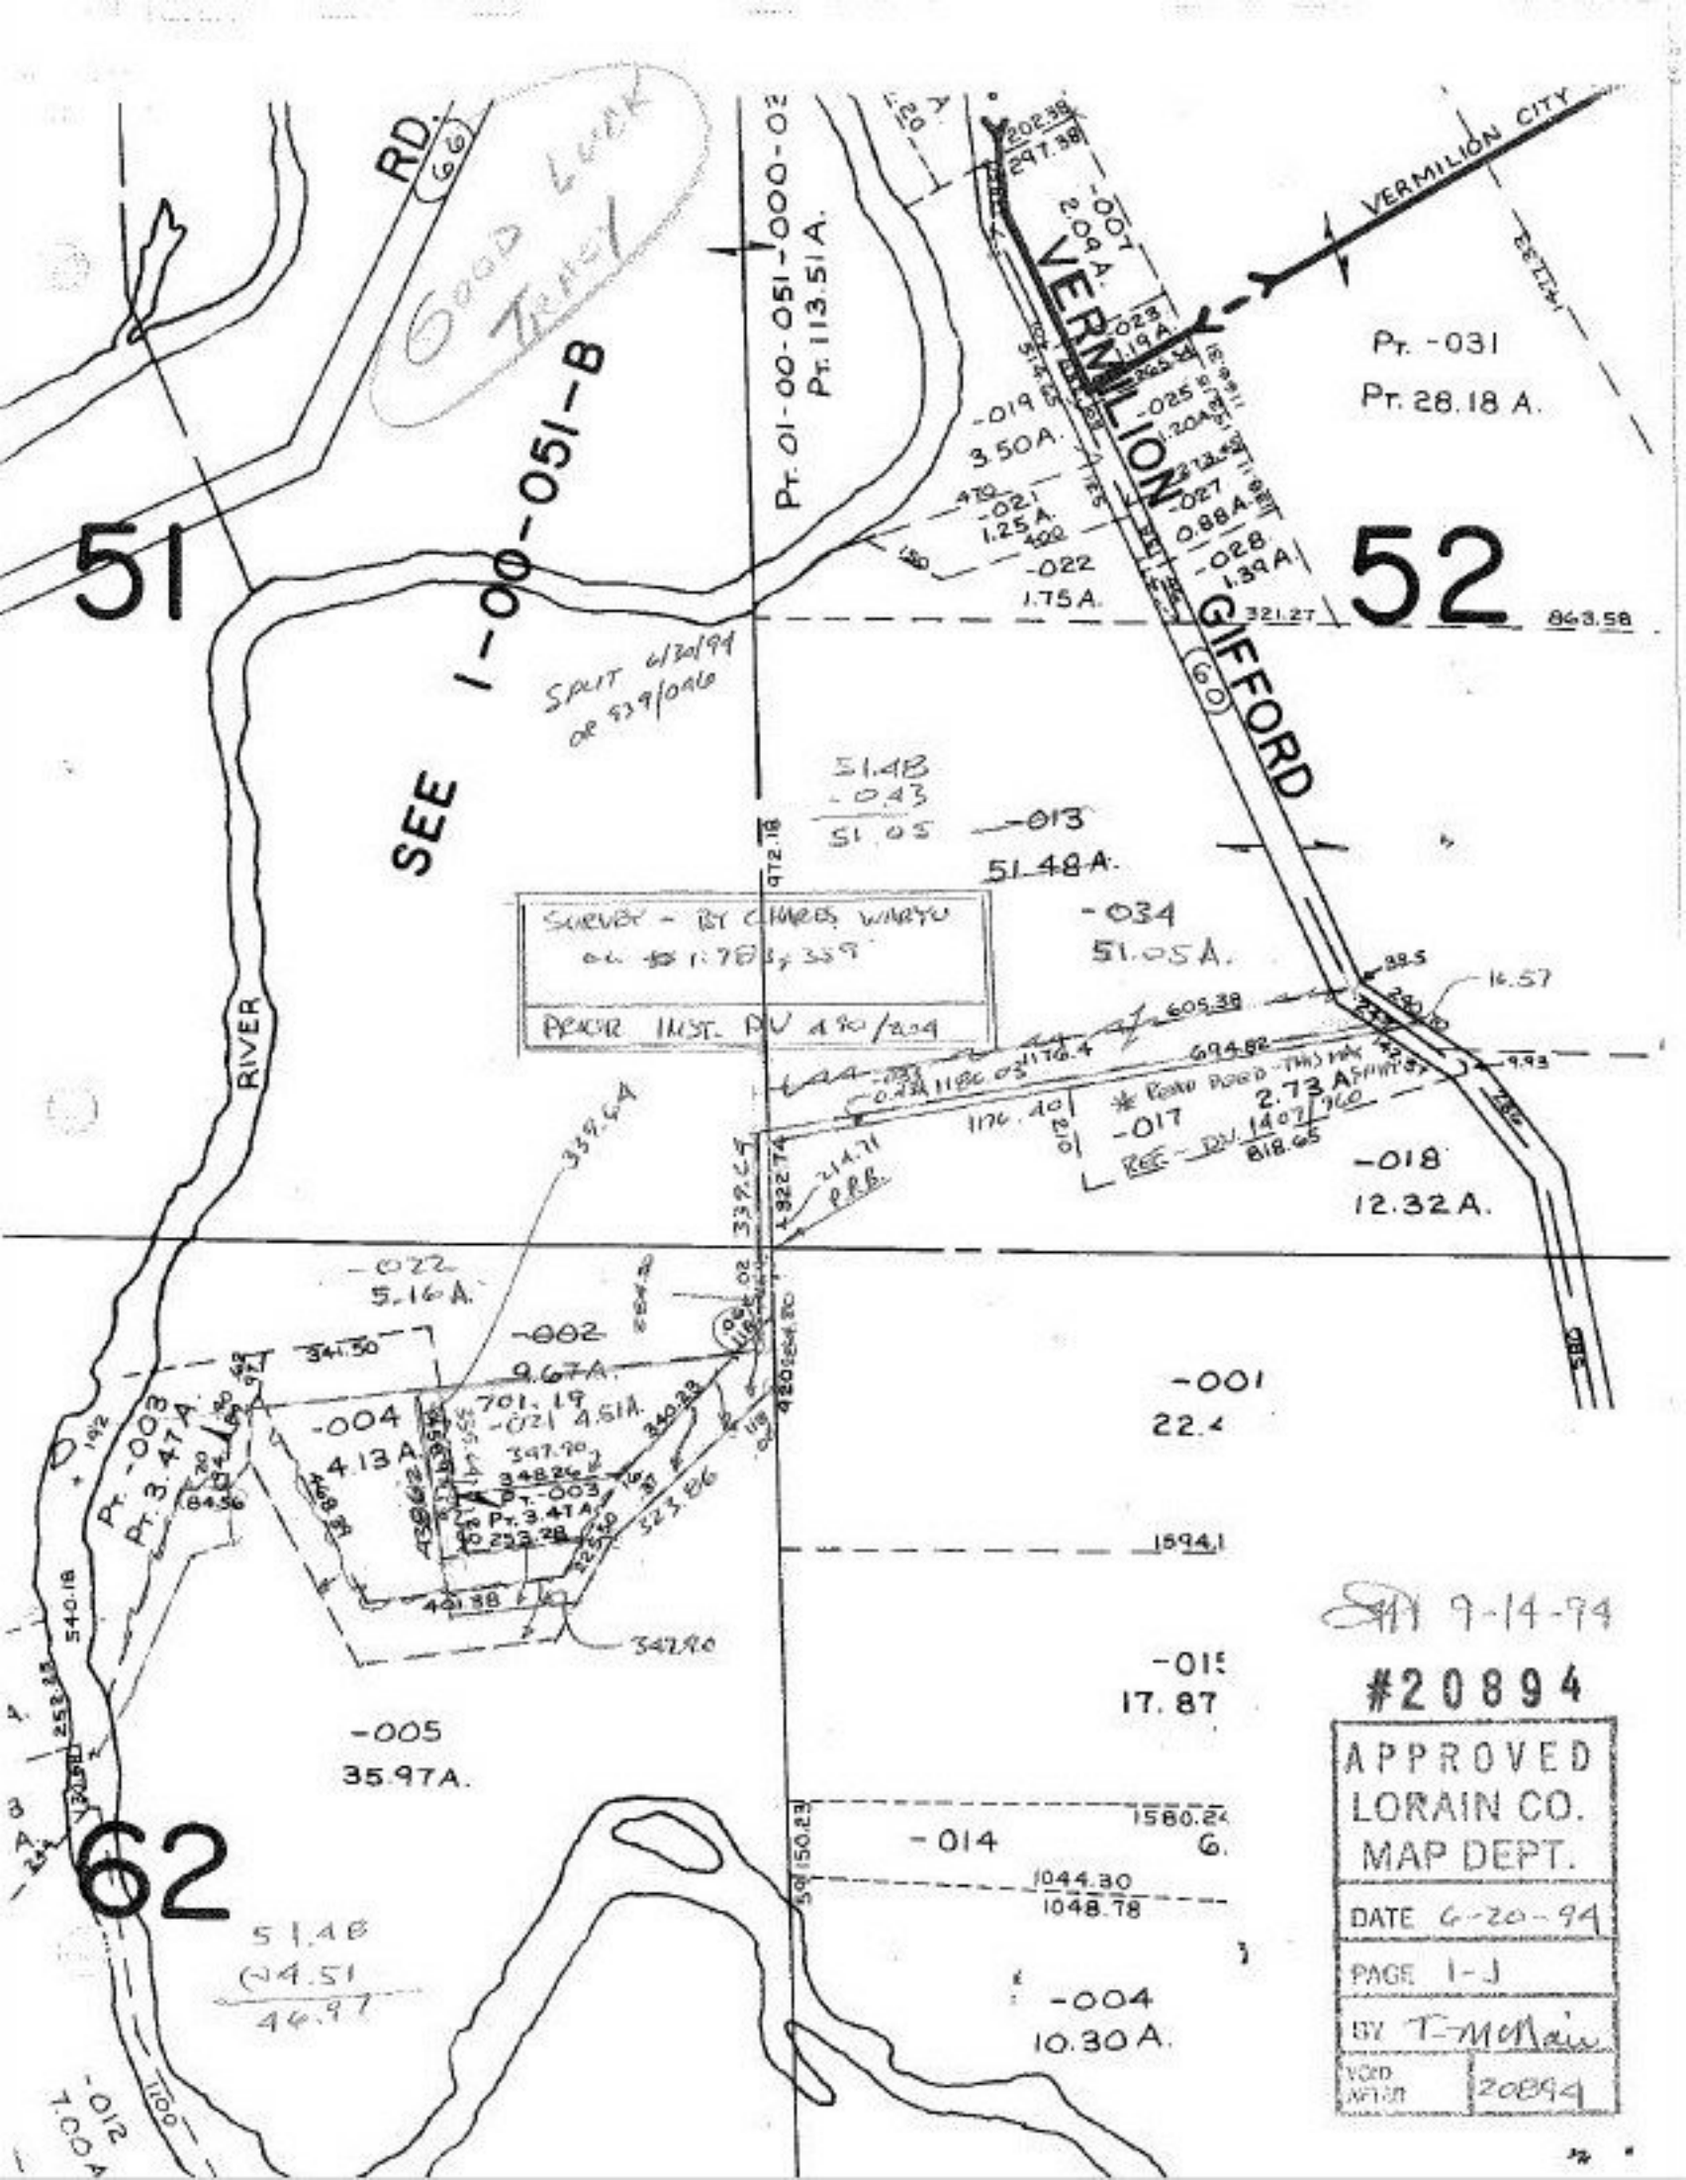
RD.
66
GOOD LUCK
51
52
62
SEE 1-00-051-B
Pt. 01-00-051-000-02
Pt. 113.51 A.
VERMILION CITY
VERMILION
GIFFORD
60
Pt. -031
Pt. 28.18 A.
SPLIT 6/20/94
OR 539/0460
-019
3.50A.
-021
1.25A.
-022
1.75A.
-025
2.04A.
-027
0.88A.
-028
1.39A.
-007
2.09A.
-023
1.19A.
51.48
-.43
51.05
-013
51.48A.
-034
51.05A.
SURVEY - BY CHARLES WARTH
ON 1:78 & 359
PRIOR INST. RV 490/204
-017
2.73A
-018
12.32A.
-022
5.16A.
-002
9.67A.
-004
4.13A
-003
Pt. 3.47A
-021 4.51A.
-001
22.4
-015
17.87
-005
35.97A.
-014
51.48
-04.51
46.97
-004
10.30A.
-012
7.00A
RIVER
339.64
972.18
1322.74
214.71 P.R.R.
1176.40
605.38
694.82
818.65
1594.1
1560.24
1044.30
1048.78
540.18
253.38
342.90
523.86
397.90
348.24
701.19
420.24
150.23
16.57
9.93
SURVEY 9-14-94
#20894
APPROVED
LORAIN CO.
MAP DEPT.
DATE 6-20-94
PAGE 1-J
BY T. McMain
VOID AFTER 20894