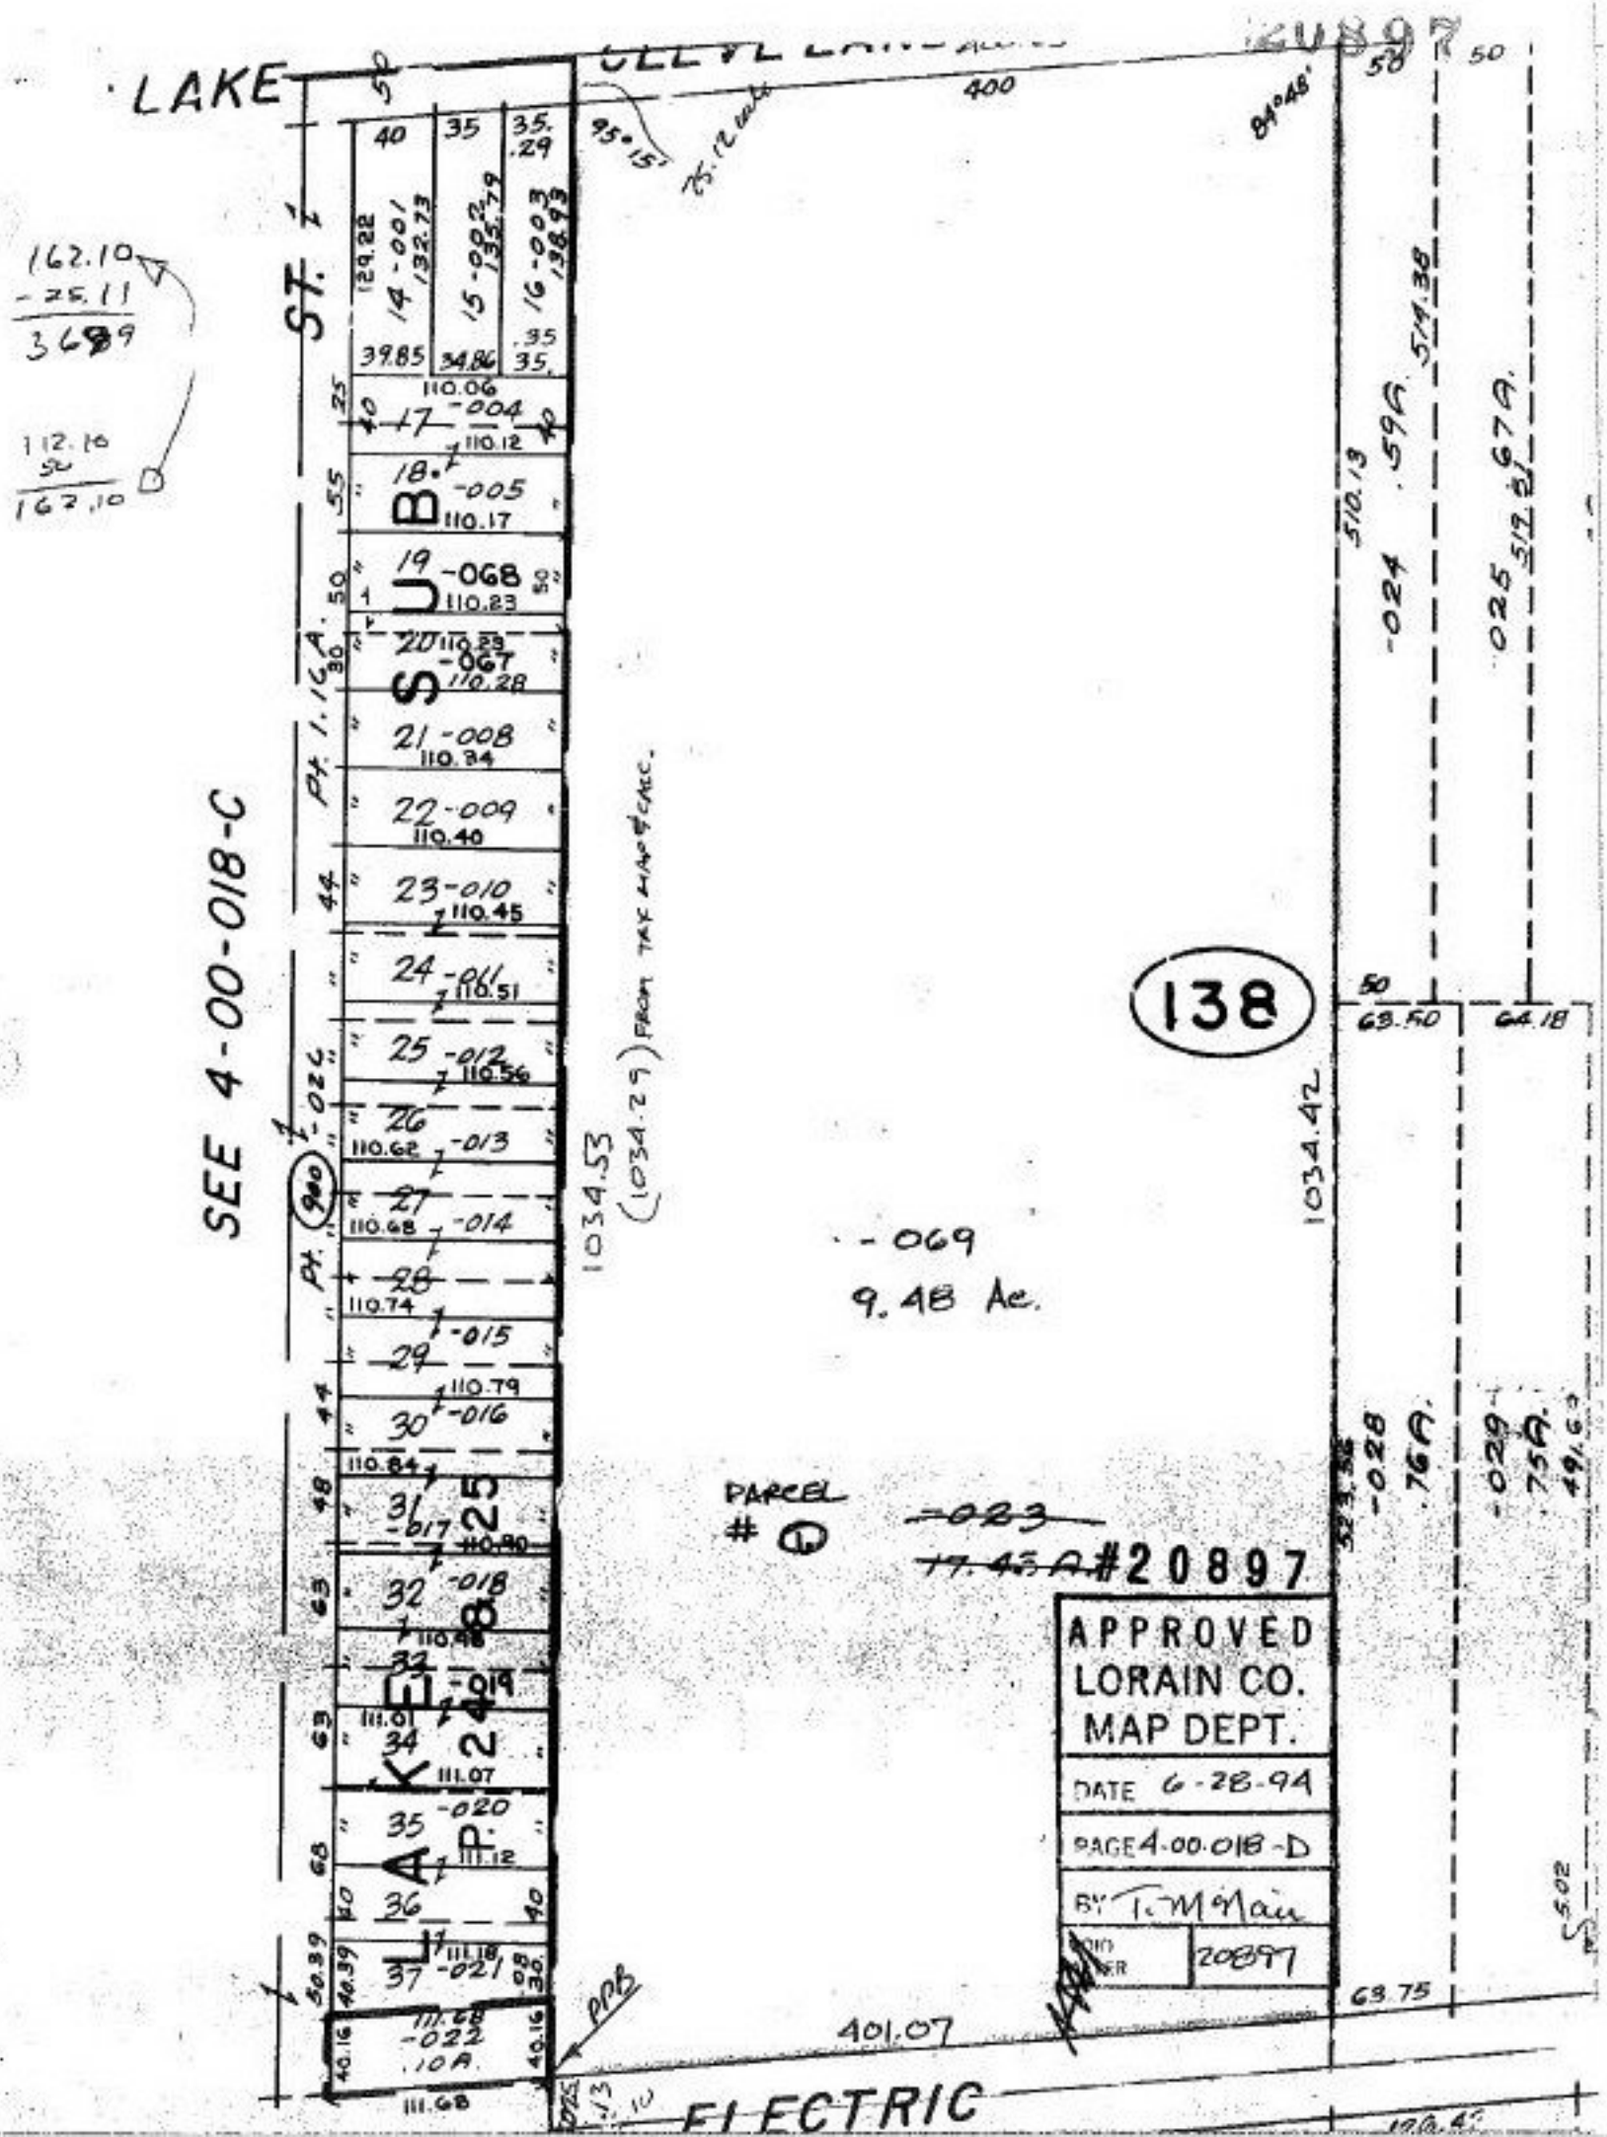

LAKE
ST.
SEE 4-00-018-C
SUB
LAKE 24 & 25
138
-069
9.48 Ac.
PARCEL #1
#20897
APPROVED
LORAIN CO.
MAP DEPT.
DATE 6-28-94
PAGE 4-00-018-D
BY T. McMain
20897
ELECTRIC
401.07
1034.53
1034.42