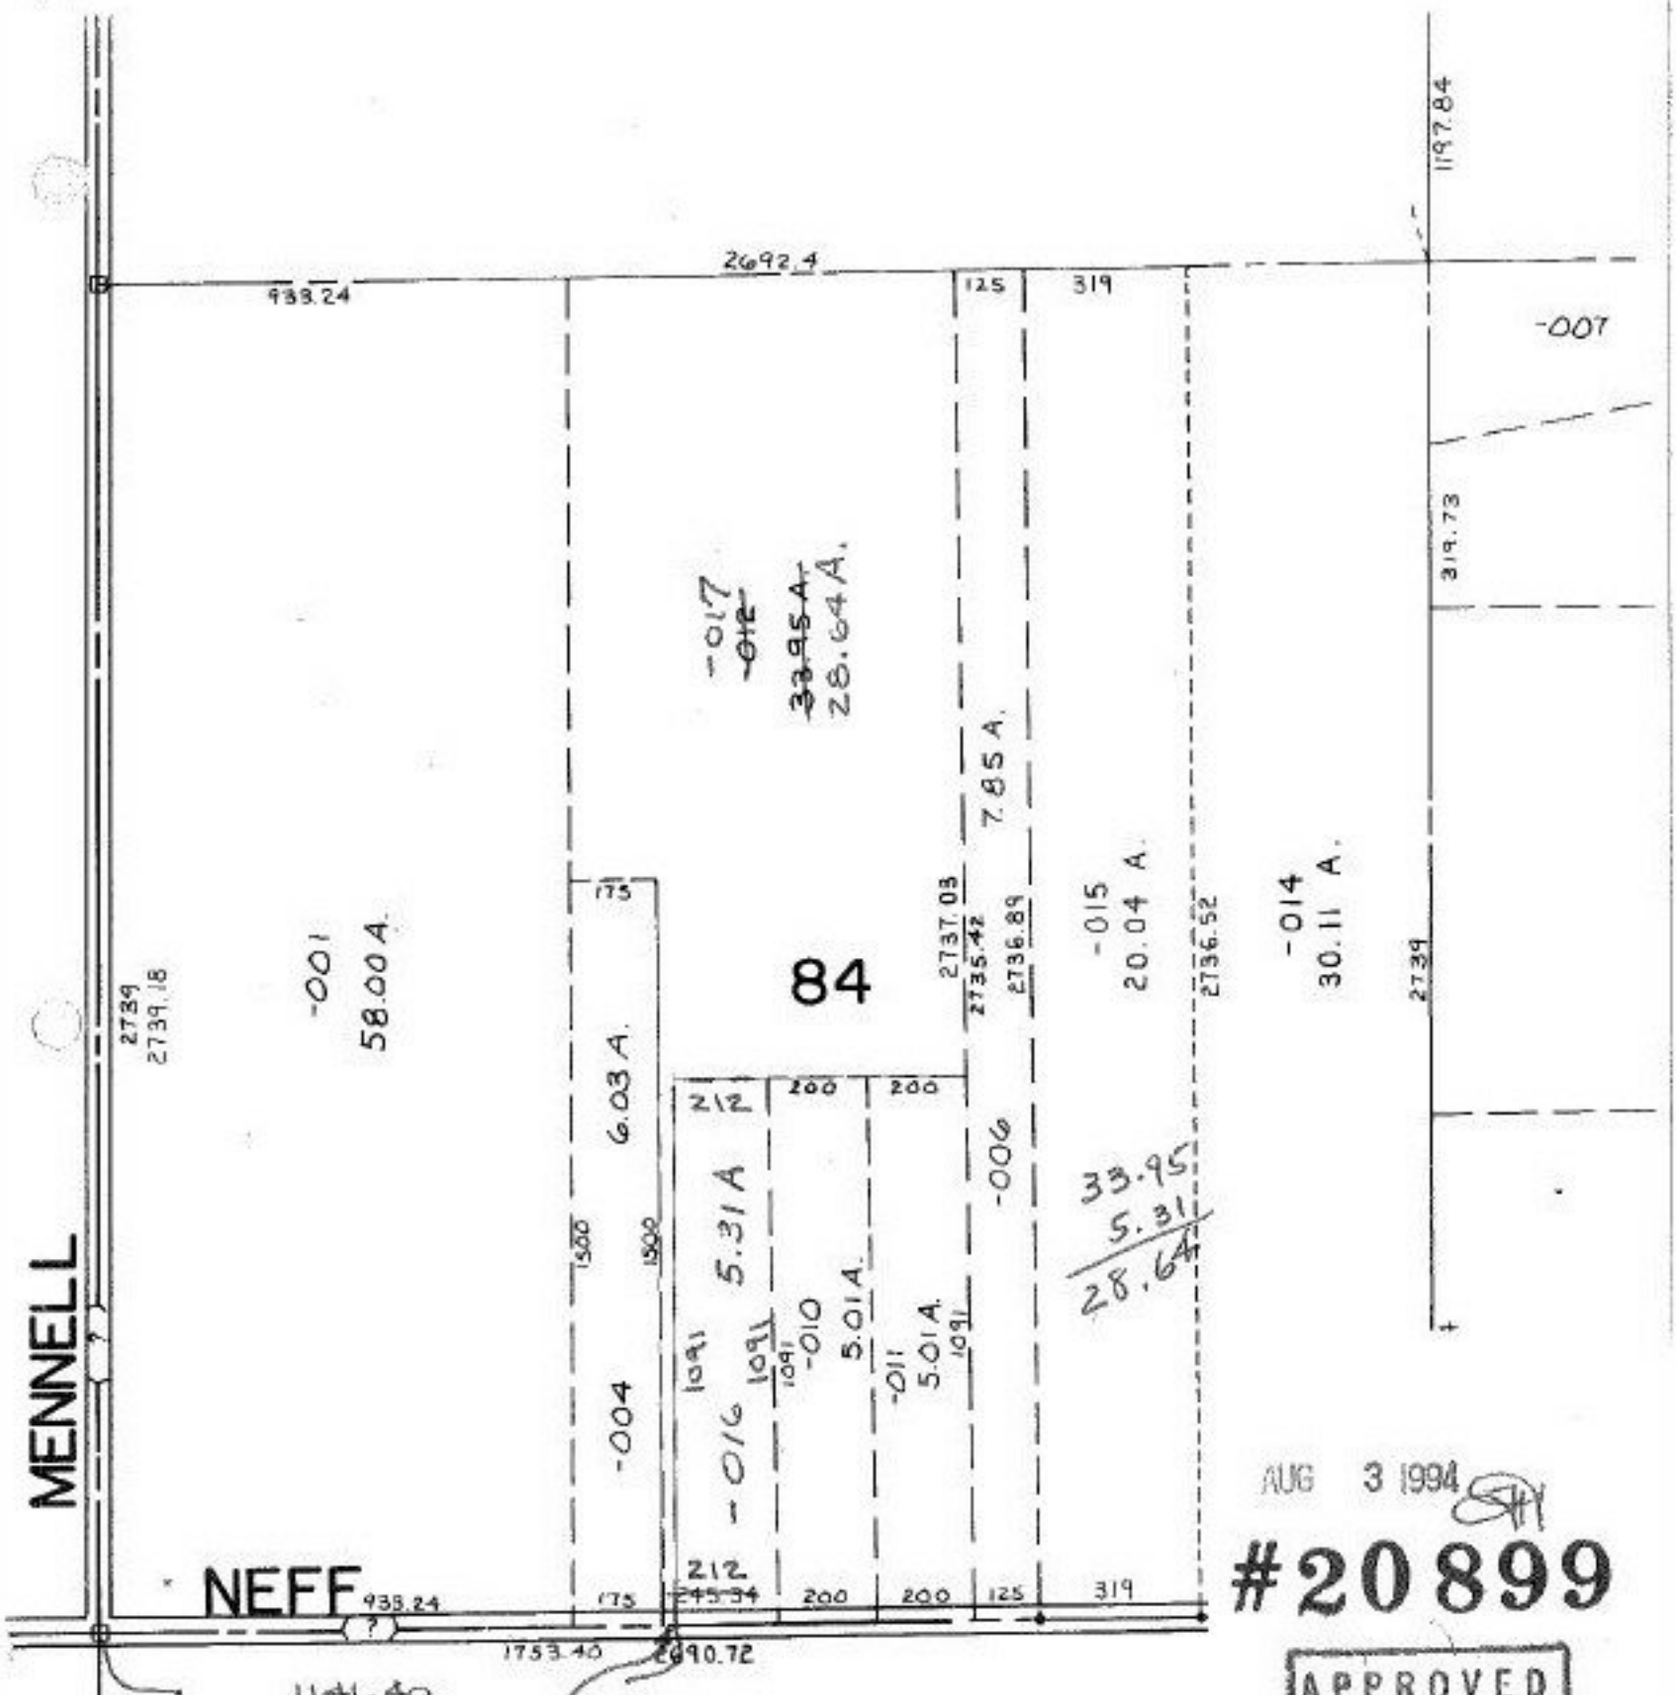

AUG 3 1994

#20899

Prior Instrument 1149/747
Closure 1: OVER
Surveyed By DAVID L ELWELL

APPROVED
LORAIN CO.
MAP DEPT.
DATE 6-24-94
PAGE 16-F
BY
VOID AFTER 20899

-001
174.80 A. MAP