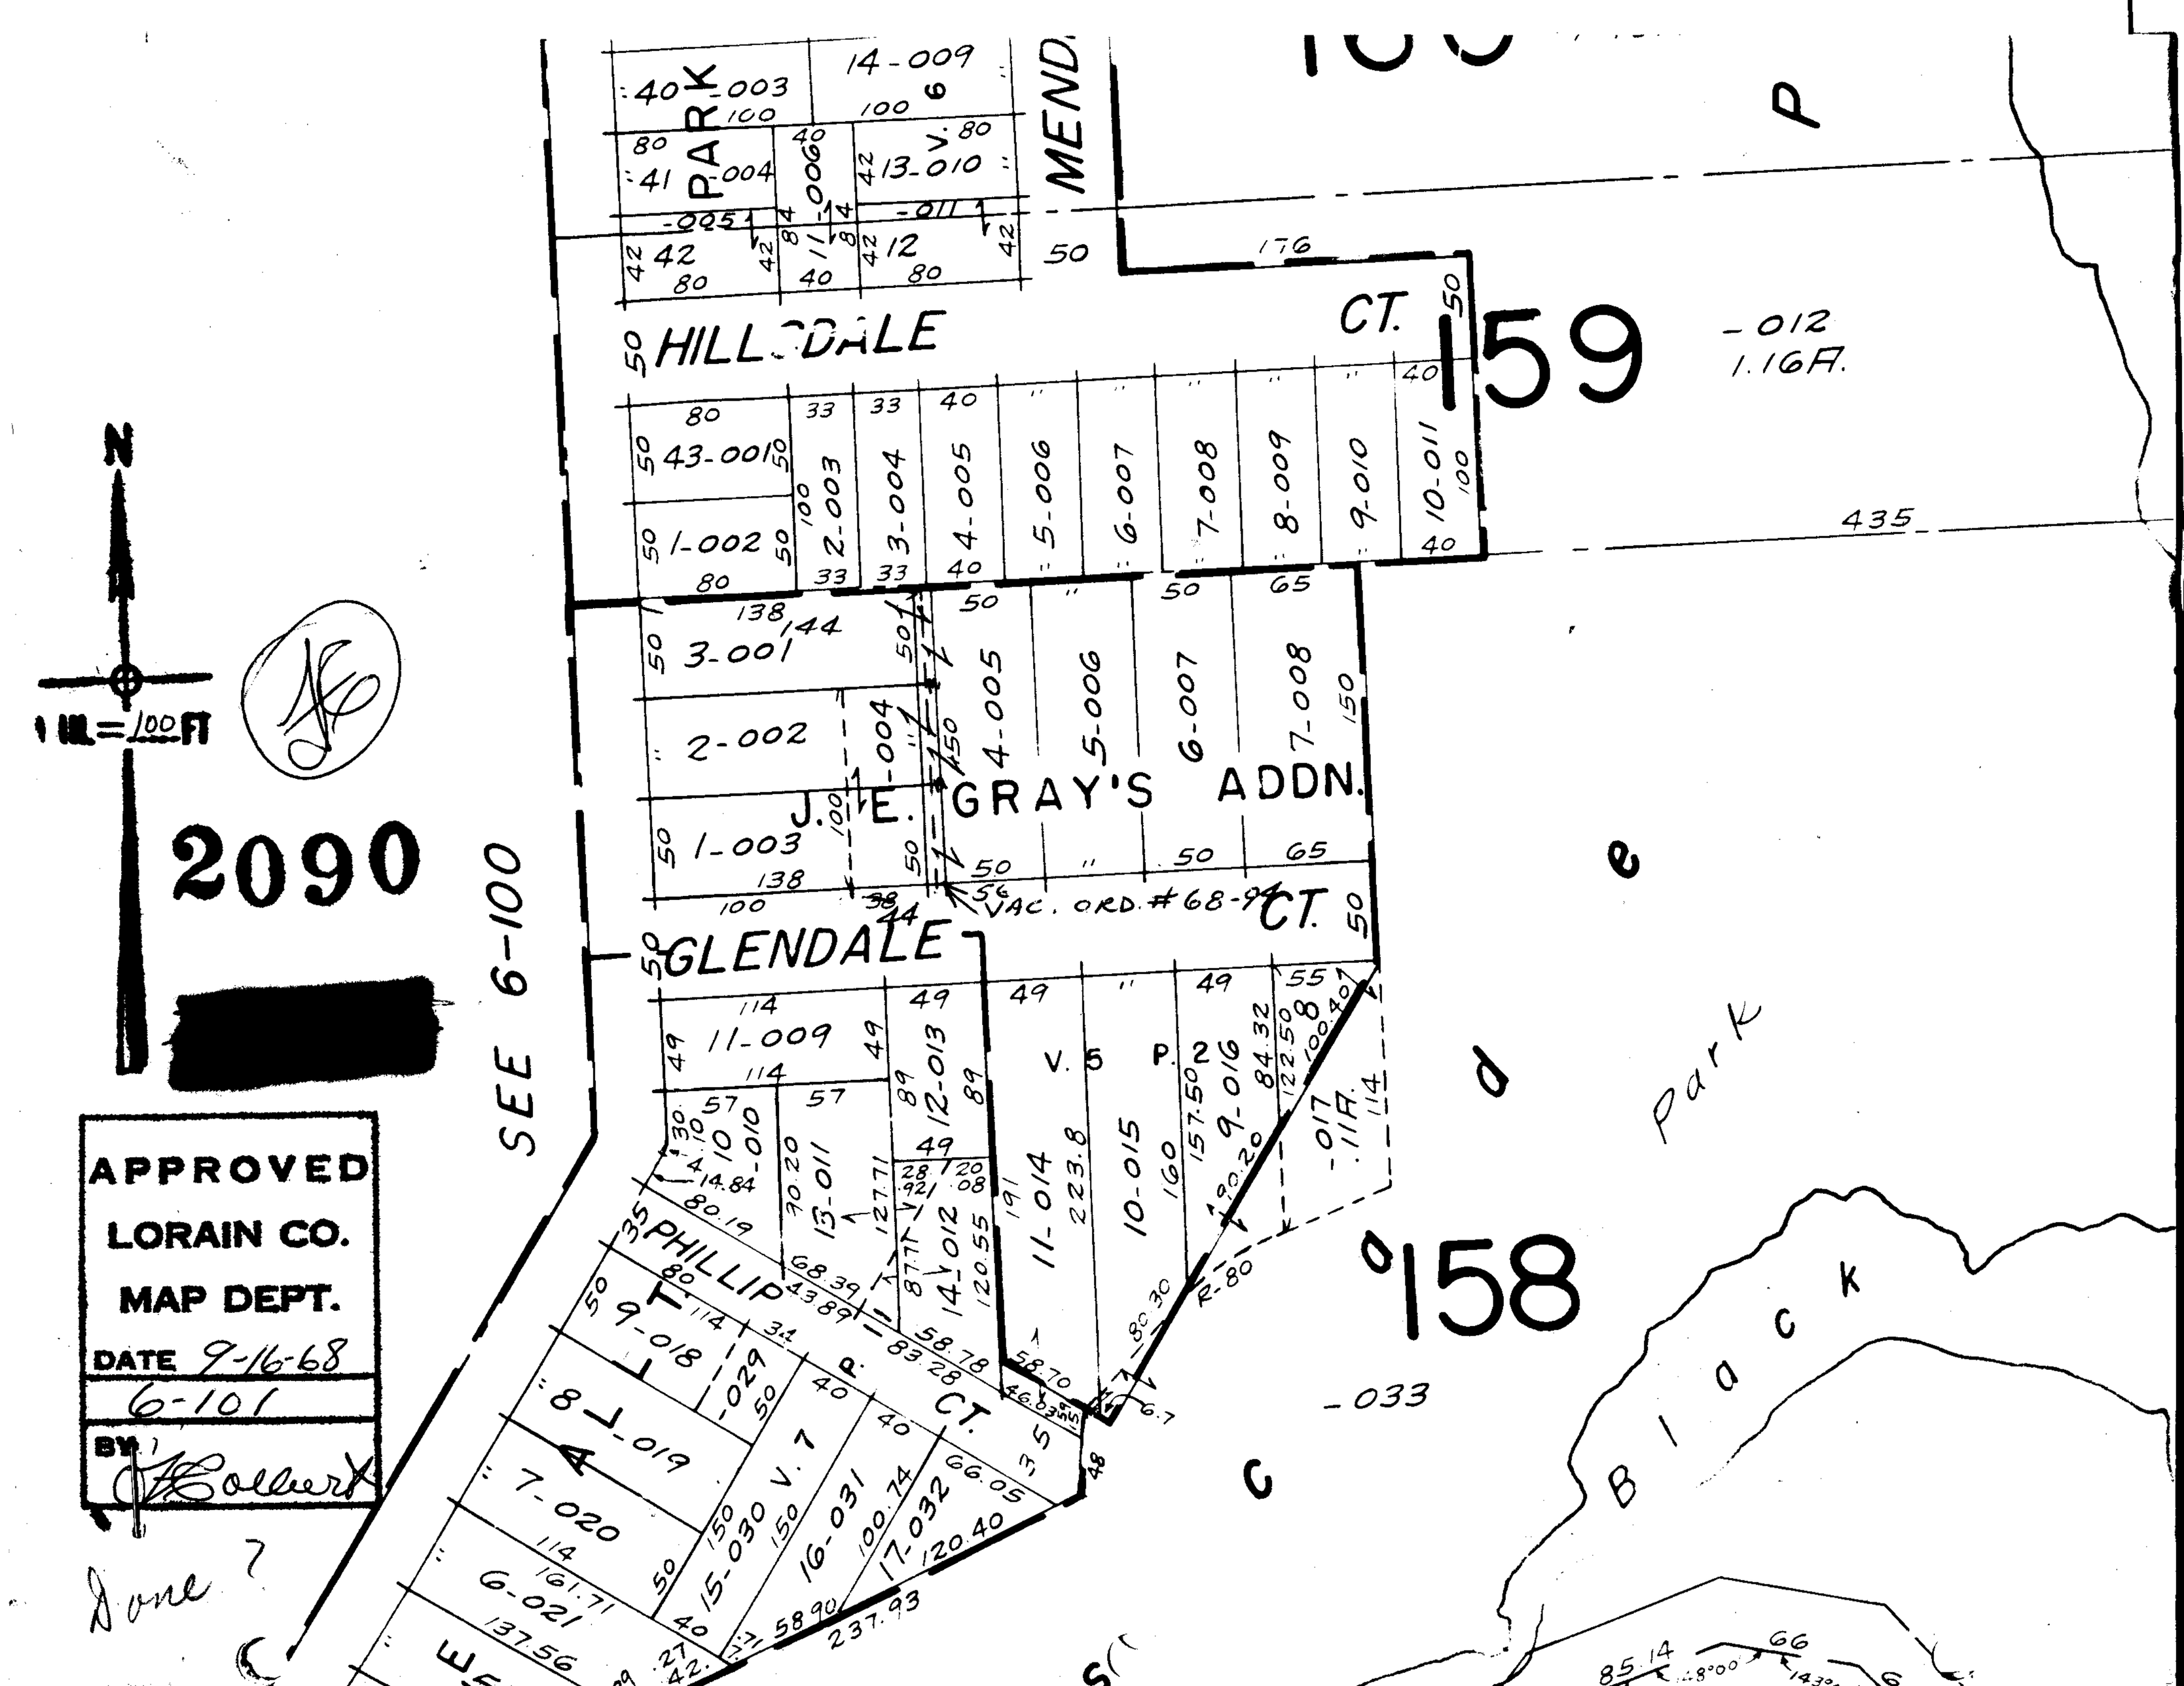

N
1 IN. = 100 FT
2090
[redacted]
APPROVED
LORAIN CO.
MAP DEPT.
DATE 9-16-68
6-101
BY
Done ?
SEE 6-100
PARK
MEND
HILLSDALE
CT.
159
-012
1.16A.
435
J. E. GRAY'S ADDN.
VAC. ORD. #68-94
GLENDALE
CT.
V. 5 P. 2
PHILLIP
CT.
V. 7
158
-033
Park
Black