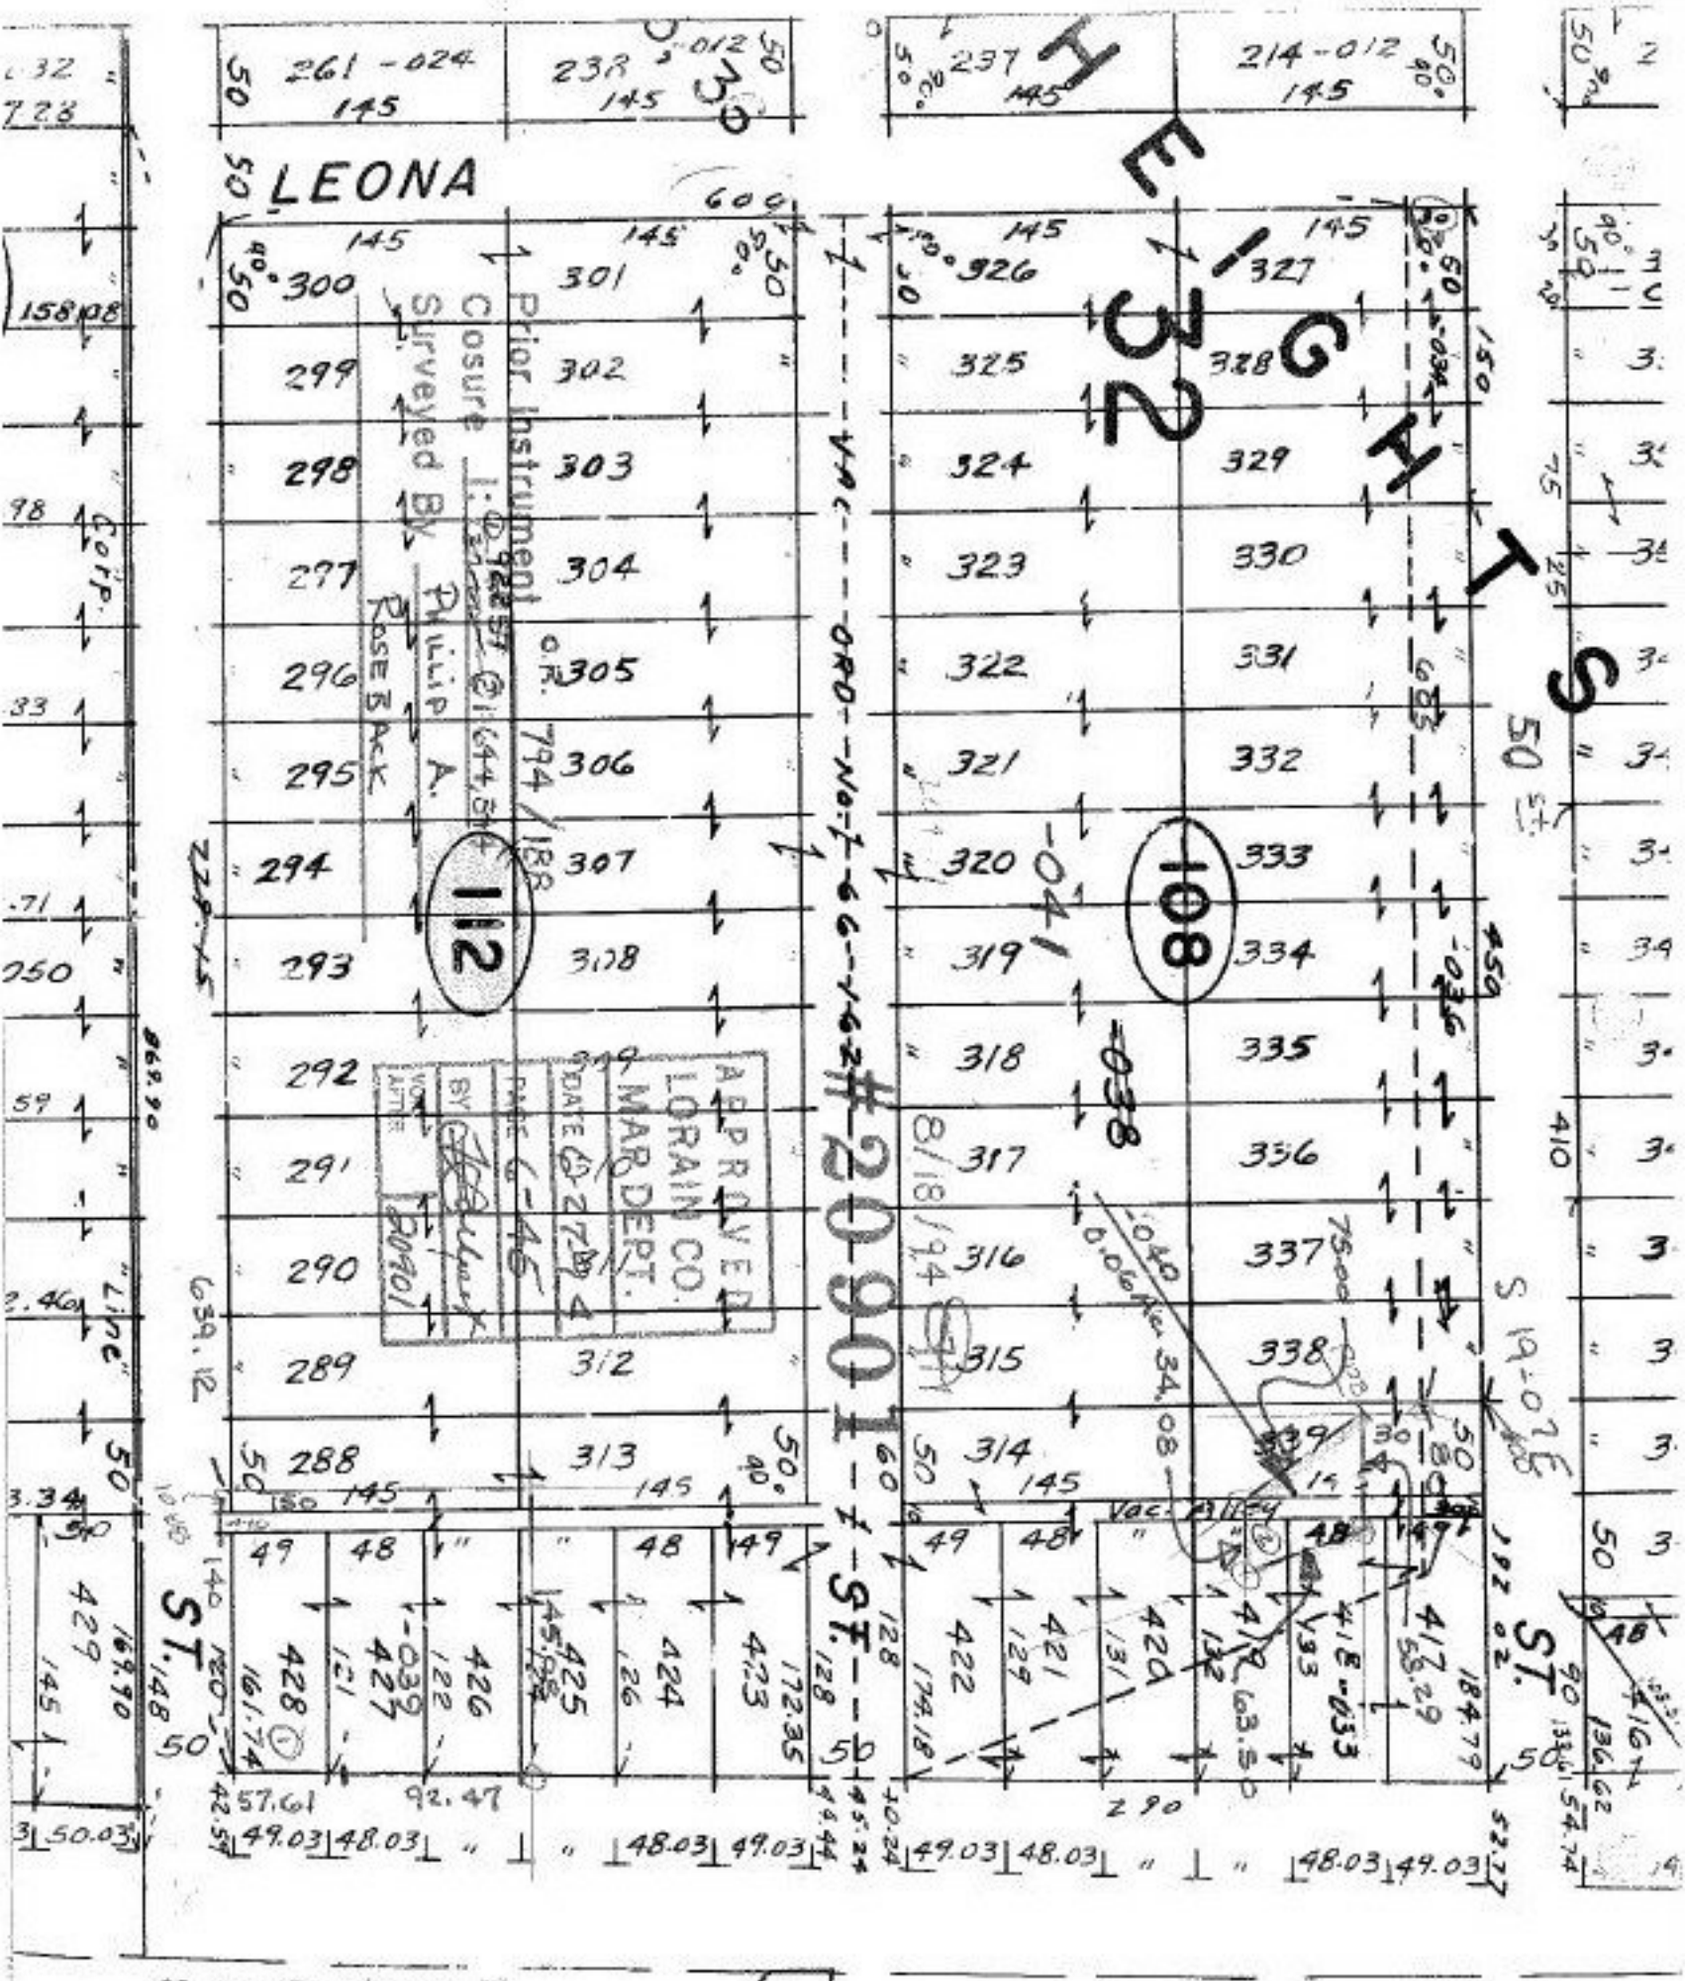

#20901

57

SEE 6-46