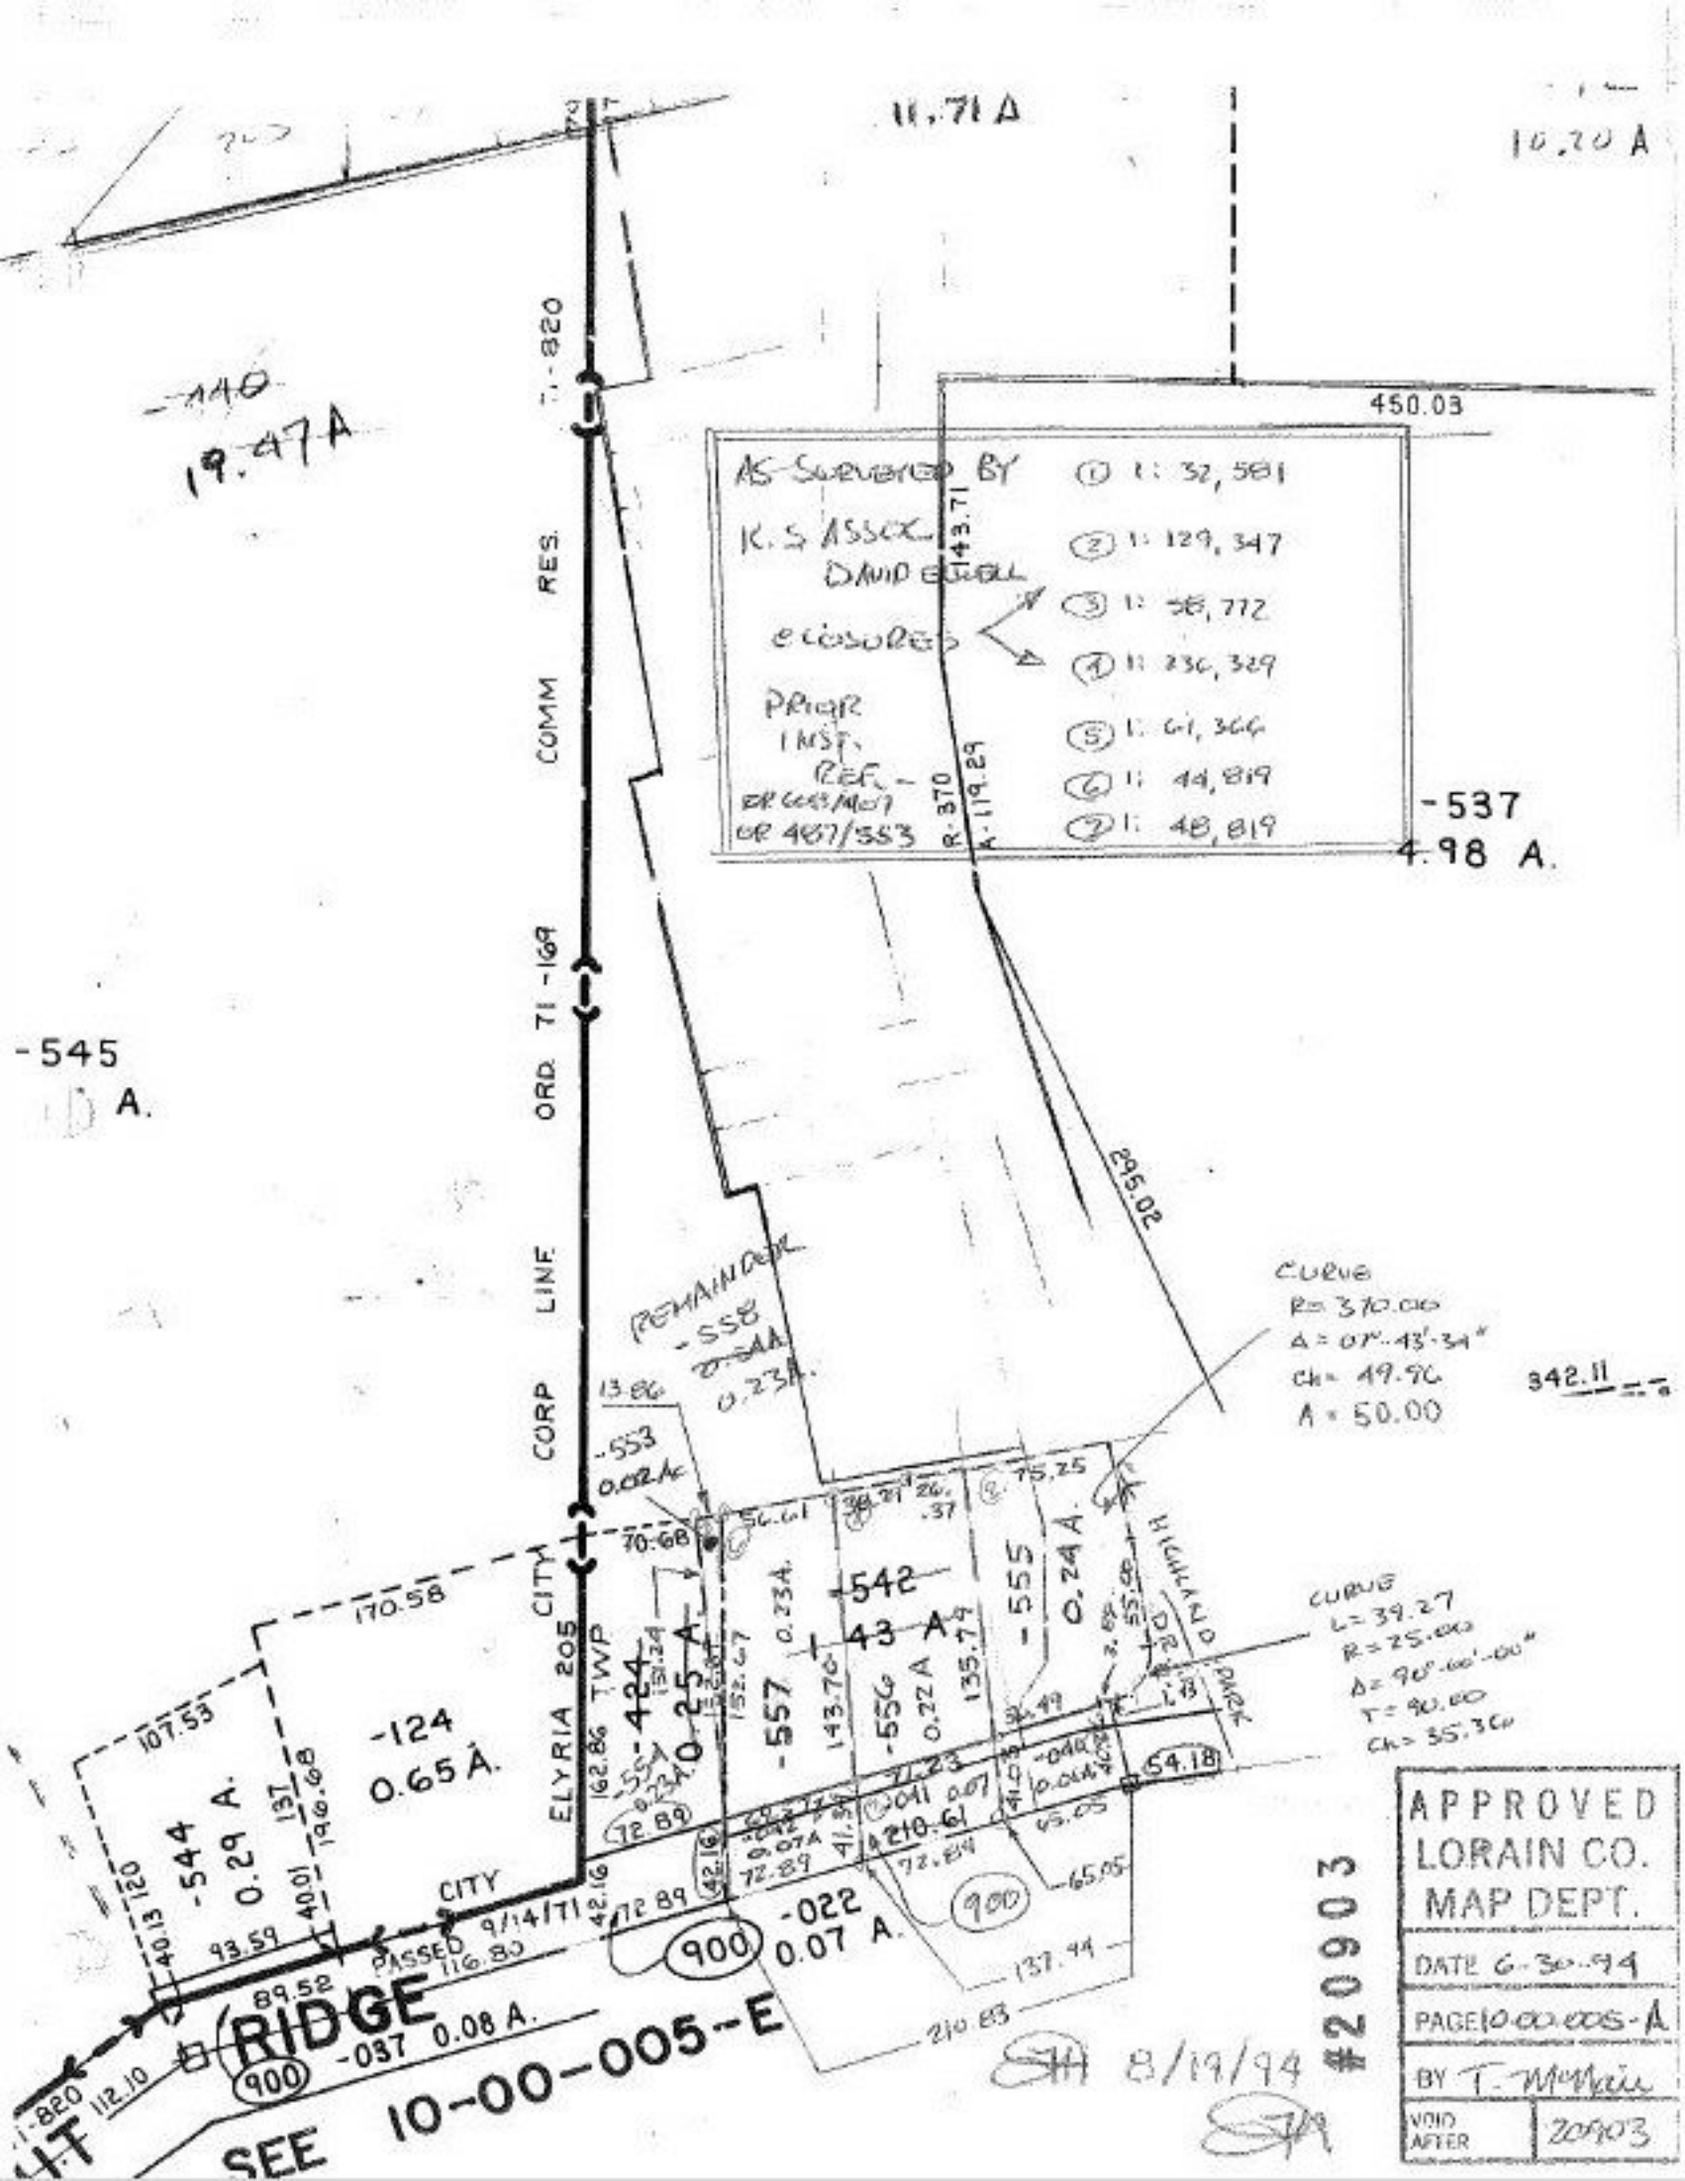
11.71 A
10.20 A
-110
19.47 A
450.03
AS SURVEYED BY
K. S ASSOC.
DAVID E. GILL
ENCLOSURES
PRIOR INST. REF. - OR 466/467 OR 467/553
R=870
A=119.29
143.71
① 1: 32,581
② 1: 129,347
③ 1: 58,772
④ 1: 236,329
⑤ 1: 61,366
⑥ 1: 44,819
⑦ 1: 48,819
-537
4.98 A.
-545
A.
COMM RES.
ORD 71-169
CORP LINE
CITY
ELYRIA 205 TWP
295.02
REMAINDER
-558
0.54A
0.23A.
13.66
-553
0.02Ac
70.68
56.61
38.21
26.37
75.25
CURVE
R=370.00
Δ=07°-43'-34"
CH=49.90
A=50.00
342.11
170.58
107.53
-124
0.65 A.
-544
0.29 A.
137
196.68
40.13
120
40.01
93.59
CITY
PASSED 9/14/71
116.80
89.52
RIDGE
-037 0.08 A.
900
112.10
SEE 10-00-005-E
-424
0.25 A.
131.24
132.07
162.86
-557
0.23A.
143.70
-542
43 A
-556
0.22 A
135.74
-555
0.24 A.
HIGHLAND DR.
CURVE
L=39.27
R=25.00
Δ=90°-00'-00"
T=90.00
CH=35.36
PARK
54.18
65.05
137.44
210.83
-022
0.07 A.
8/19/94
#20903
APPROVED
LORAIN CO.
MAP DEPT.
DATE 6-30-94
PAGE 10-00-005-A
BY T. McMain
VOID AFTER
20903