~~-116~~
~~33.10 A.~~

-158
32.90 A.

Prior Instrument D.V. 932 / 796
Closure 1: INF.
Surveyed By VINCENT C. McGERVEY

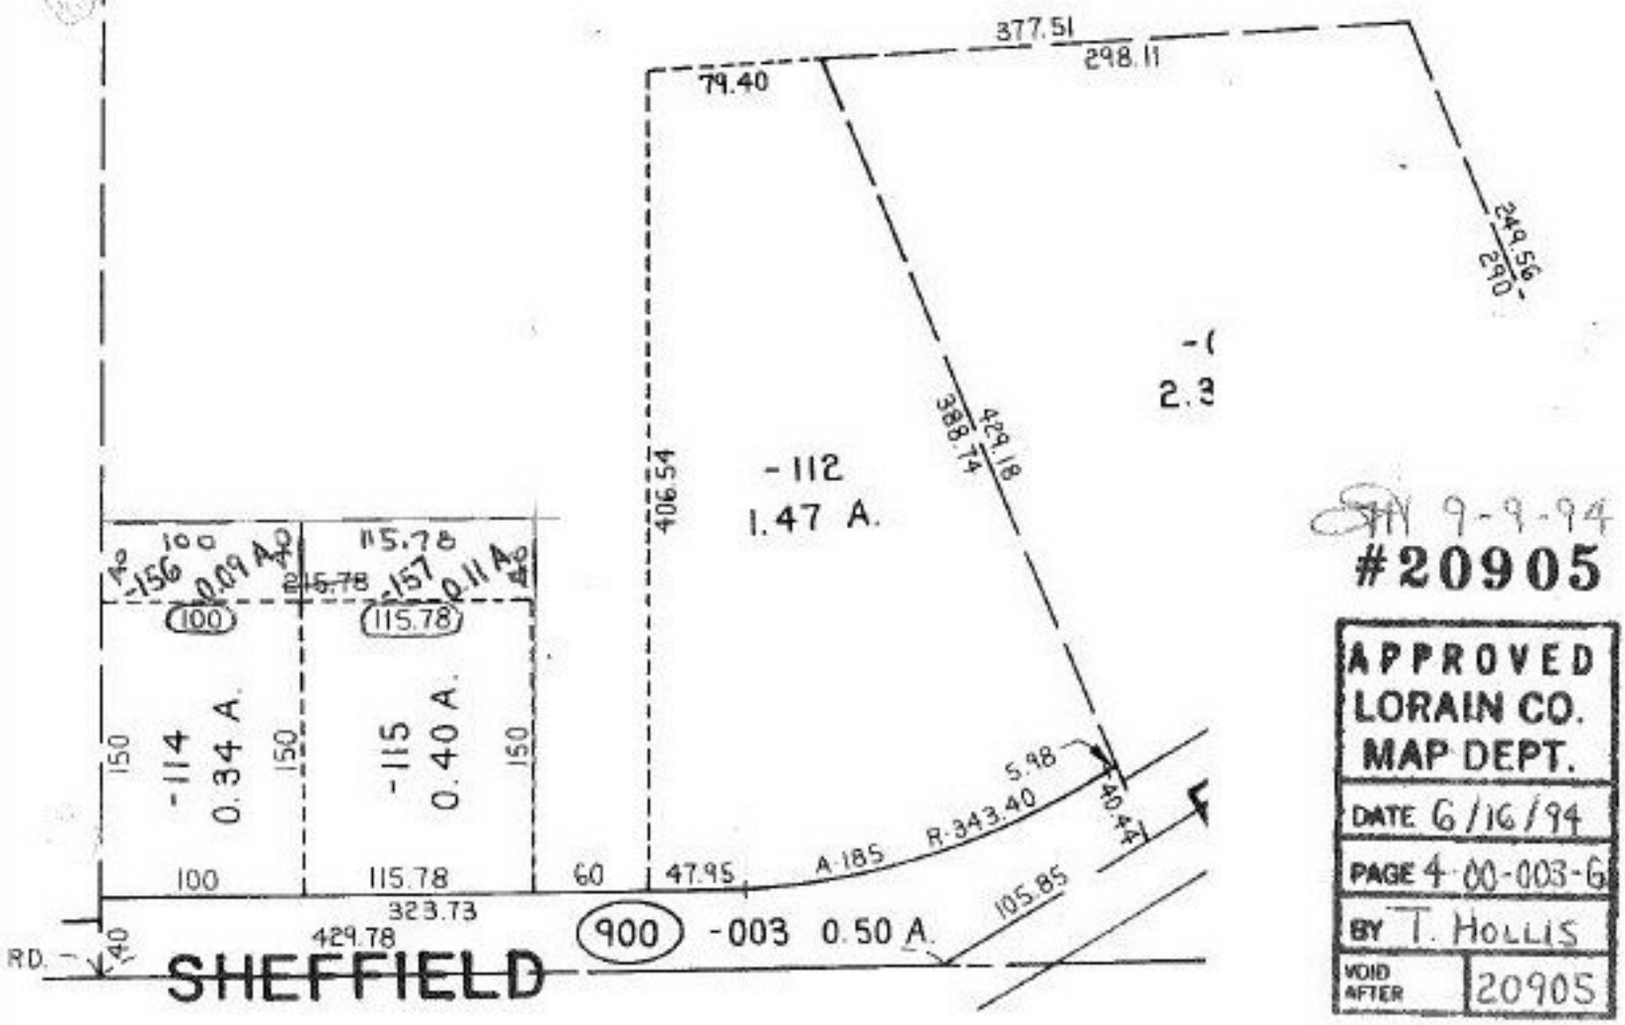

9-9-94
#20905

APPROVED
LORAIN CO.
MAP DEPT.
DATE 6/16/94
PAGE 4-00-003-6
BY T. HOLLIS
VOID AFTER 20905