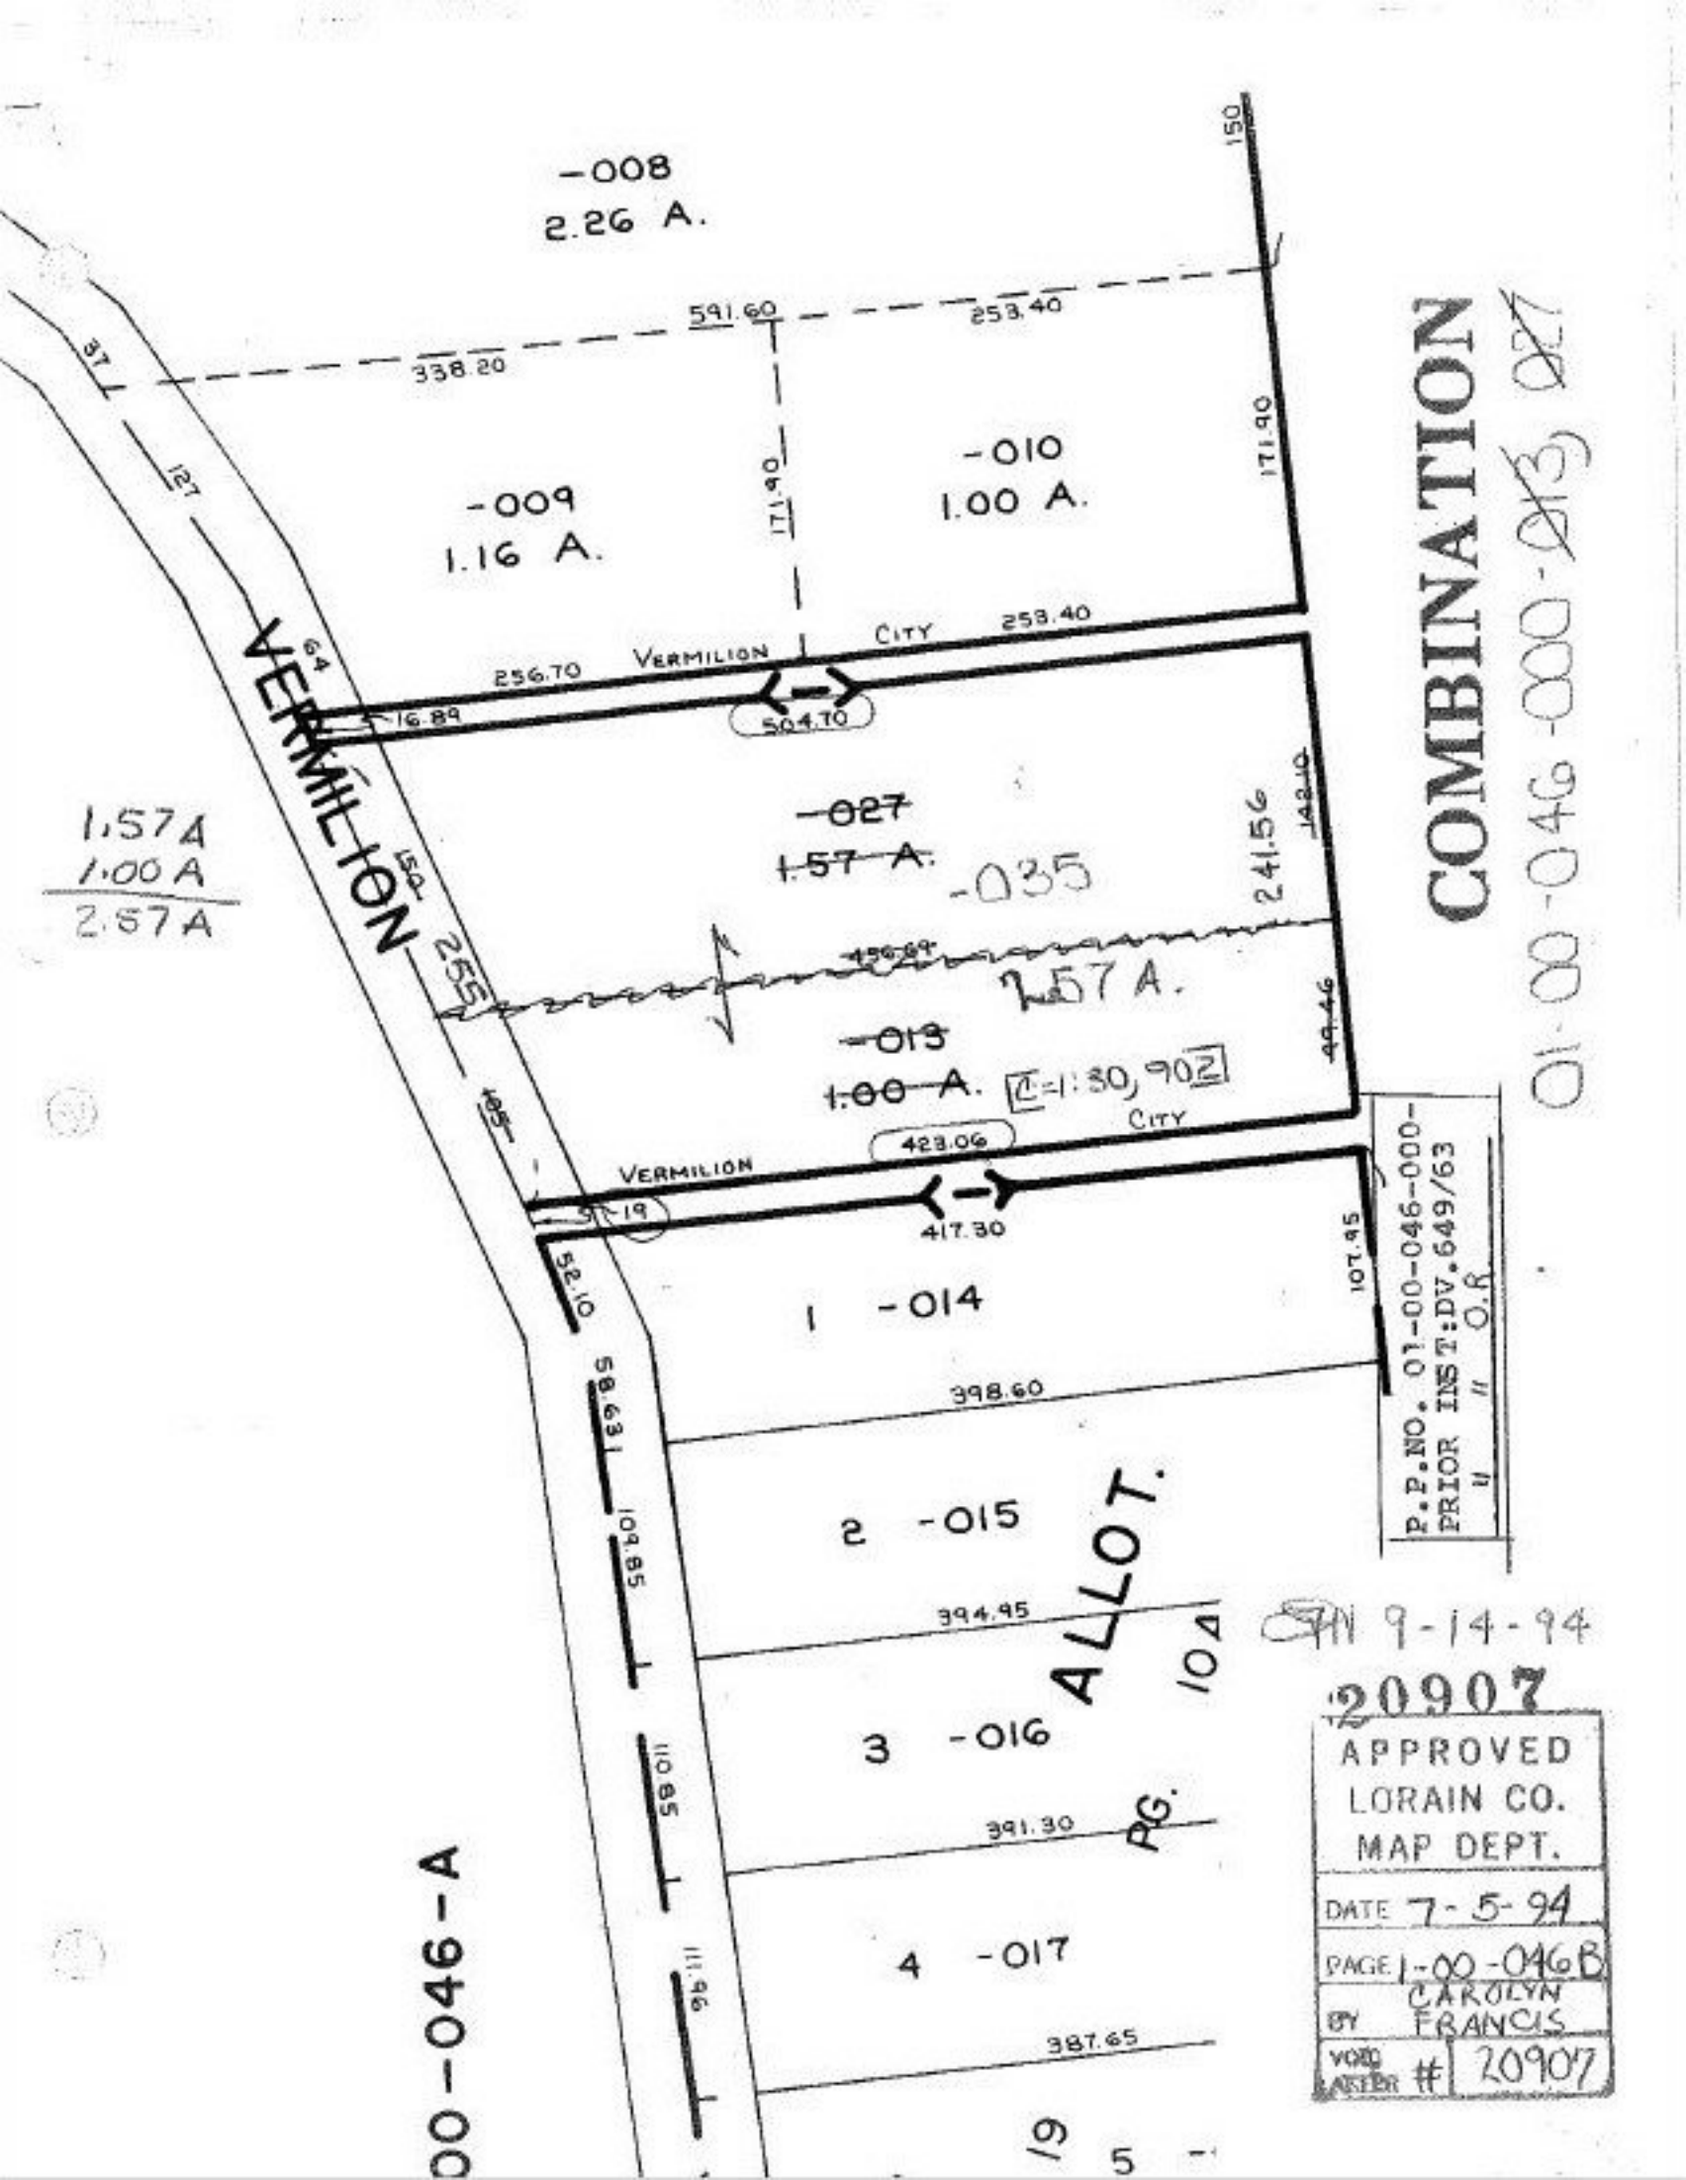
-008
2.26 A.
591.60
253.40
338.20
150
171.90
-009
1.16 A.
-010
1.00 A.
VERMILION
CITY
256.70
504.70
253.40
16.89
64
127
1.57A
1.00A
2.57A
-027
1.57 A.
-035
241.56
142.10
1.57A.
-013
1.00 A.
423.06
417.30
49.46
107.95
52.10
58.63
109.85
110.85
111.96
398.60
394.95
391.30
387.65
1 -014
2 -015
3 -016
4 -017
5
ALLOT.
104
PG.
P.P.NO. 01-00-046-000-
PRIOR INST:DV.649/63
O.R
COMBINATION
01-00-046-000-013 027
9-14-94
20907
APPROVED
LORAIN CO.
MAP DEPT.
DATE 7-5-94
PAGE 1-00-046B
BY CAROLYN FRANCIS
VOID AFTER # 20907
00-046-A