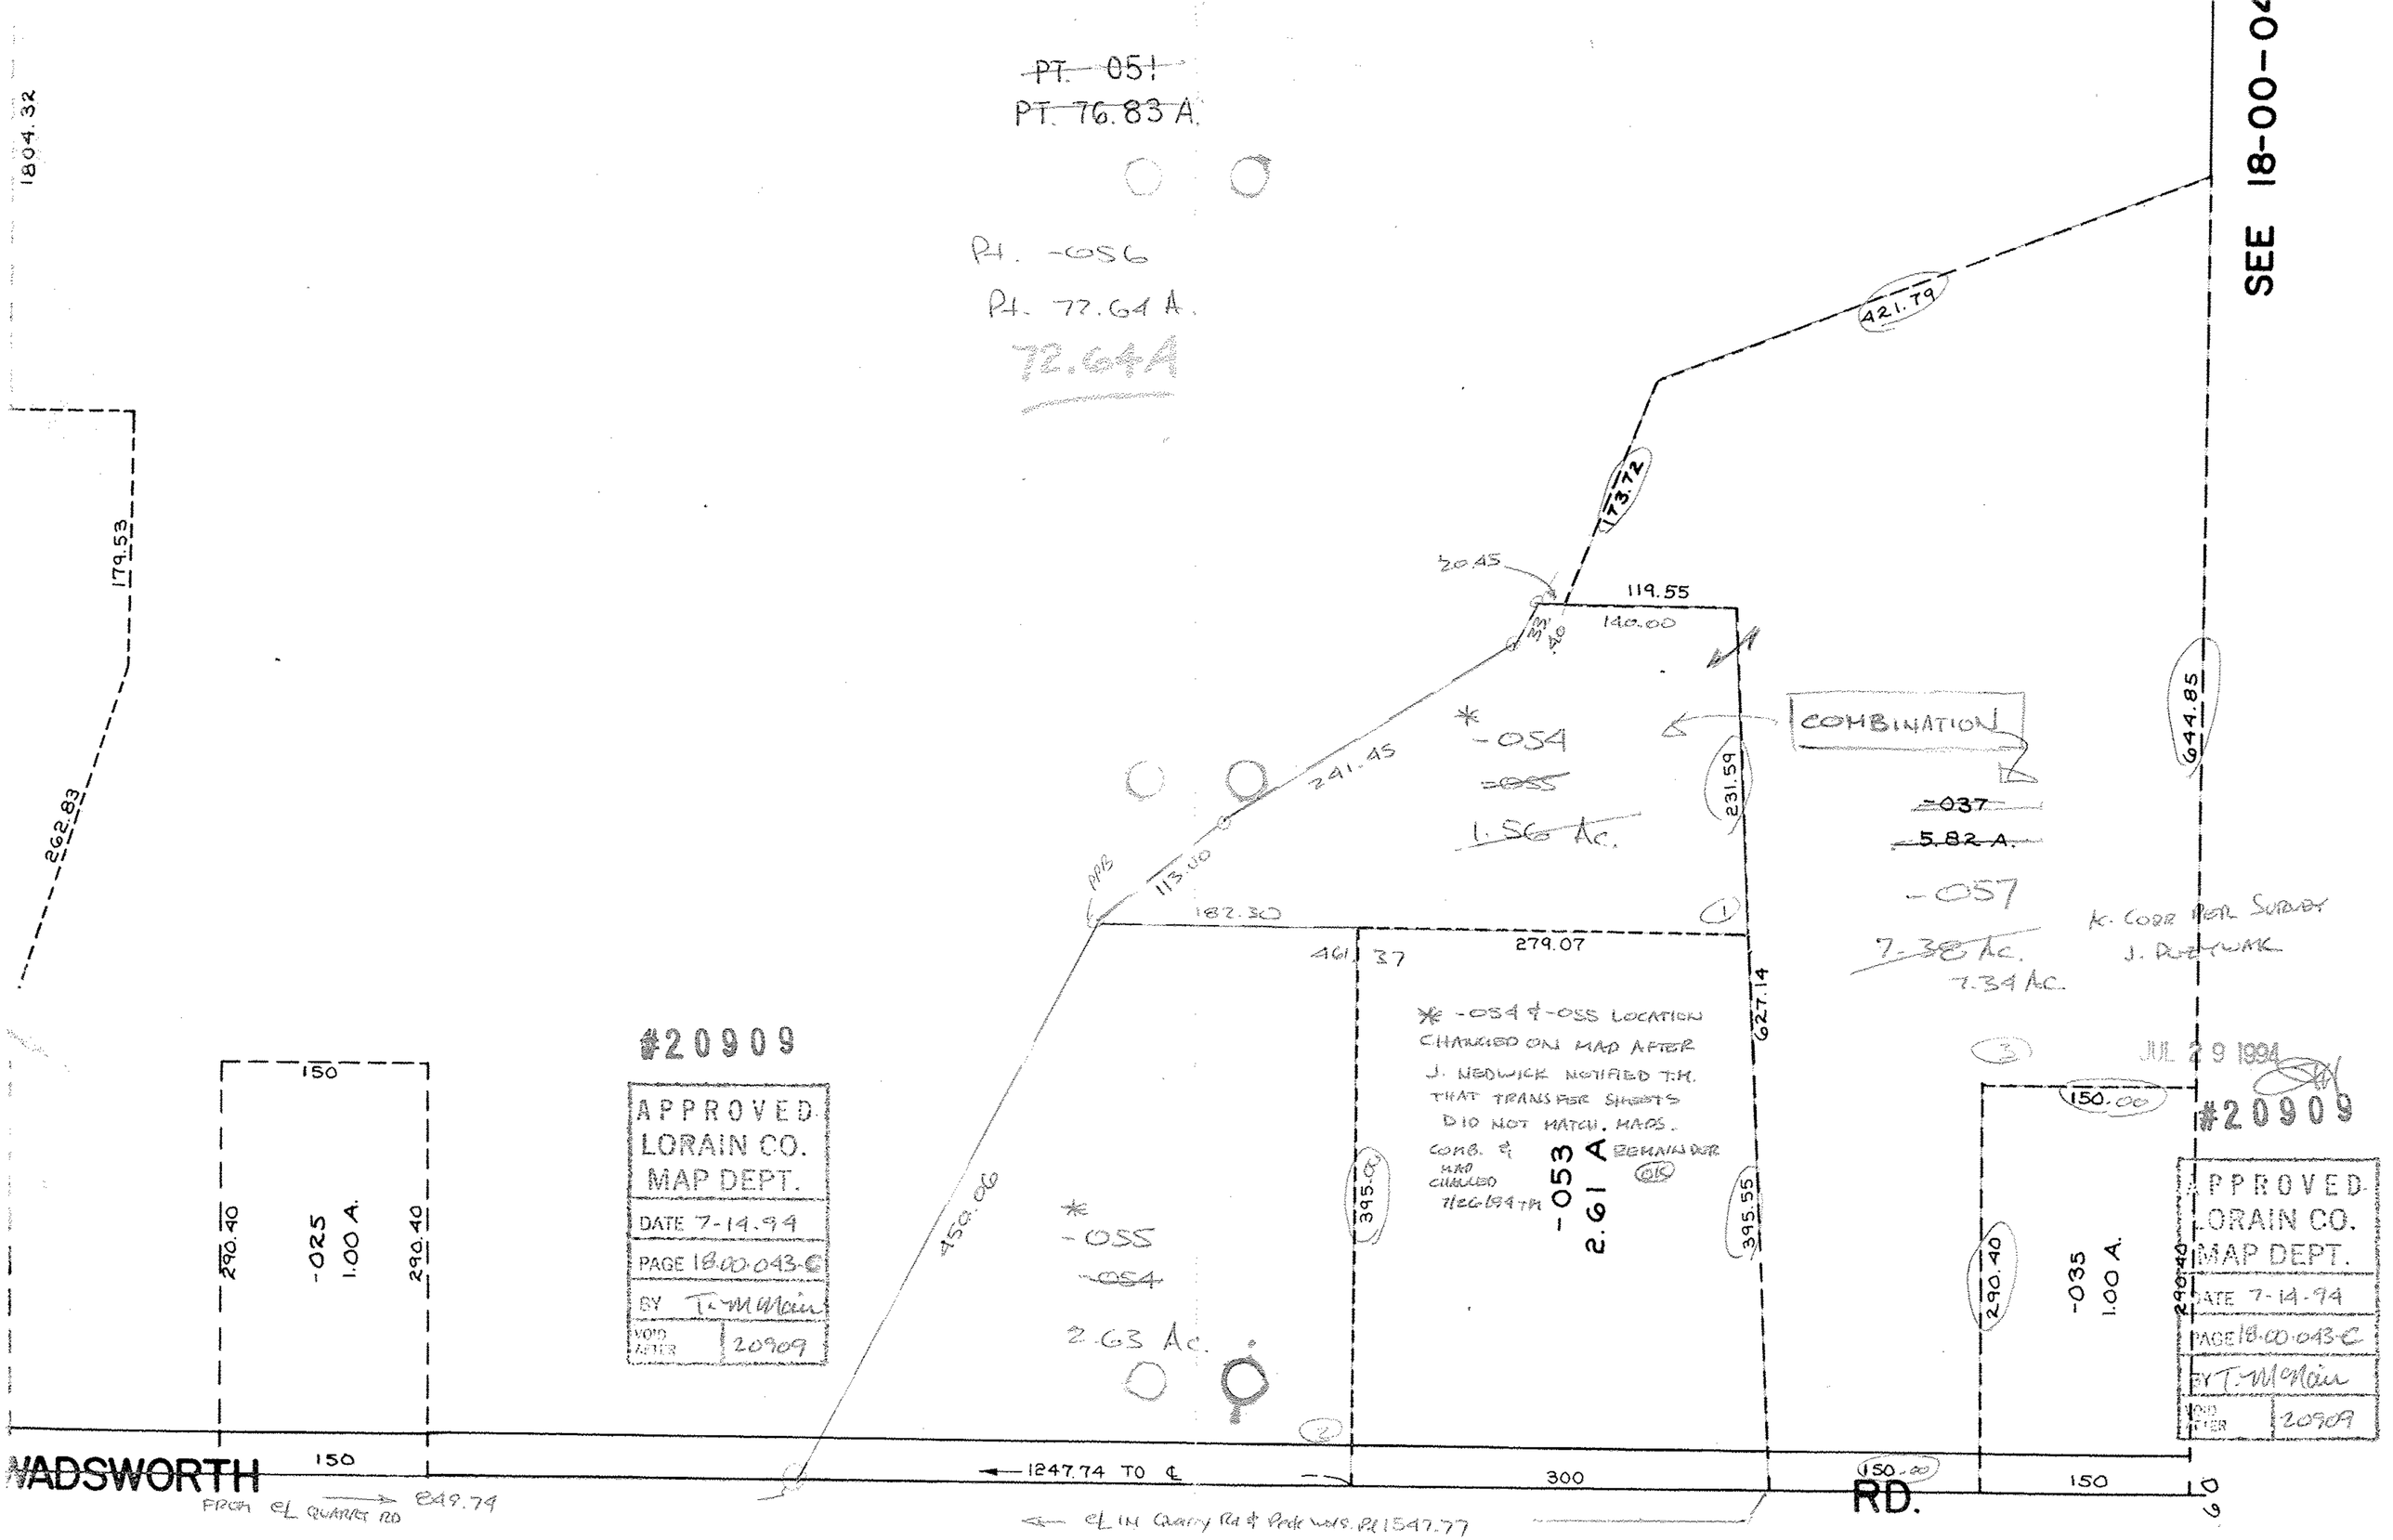

SEE 18-00-04
~~PT. 051~~
~~PT. 76.83 A.~~
Pt. -056
Pt. 72.64 A.
72.64A
1804.32
179.53
262.83
421.79
173.72
20.45
119.55
140.00
33.40
241.45
113.00
182.30
461.37
279.07
231.59
627.14
395.55
395.00
450.06
644.85
COMBINATION
*-054
~~-055~~
~~1.56 Ac.~~
~~-037~~
~~5.82 A.~~
-057
~~7.38 Ac.~~
7.34 Ac.
K. CORR PER SURVEY
J. DUZYWAK
JUL 29 1994
*-054 & -055 LOCATION CHANGED ON MAP AFTER J. NEDWICK NOTIFIED T.M. THAT TRANSFER SHEETS DID NOT MATCH. MAPS. COMB. & MAP CHANGED 7/26/94 TM
-053
2.61 A
REMAINDER
OK
*-055
~~-054~~
2.63 Ac.
150
290.40
-025
1.00 A.
290.40
150.00
290.40
-035
1.00 A.
290.40
150
1247.74 TO ℄
300
150.00
150
WADSWORTH
RD.
FROM ℄ QUARRY RD
849.74
℄ IN Quarry Rd & Peck Wds. Pl 1547.77
#20909
APPROVED
LORAIN CO.
MAP DEPT.
DATE 7-14-94
PAGE 18-00-043-C
BY T. McMain
VOID AFTER 20909