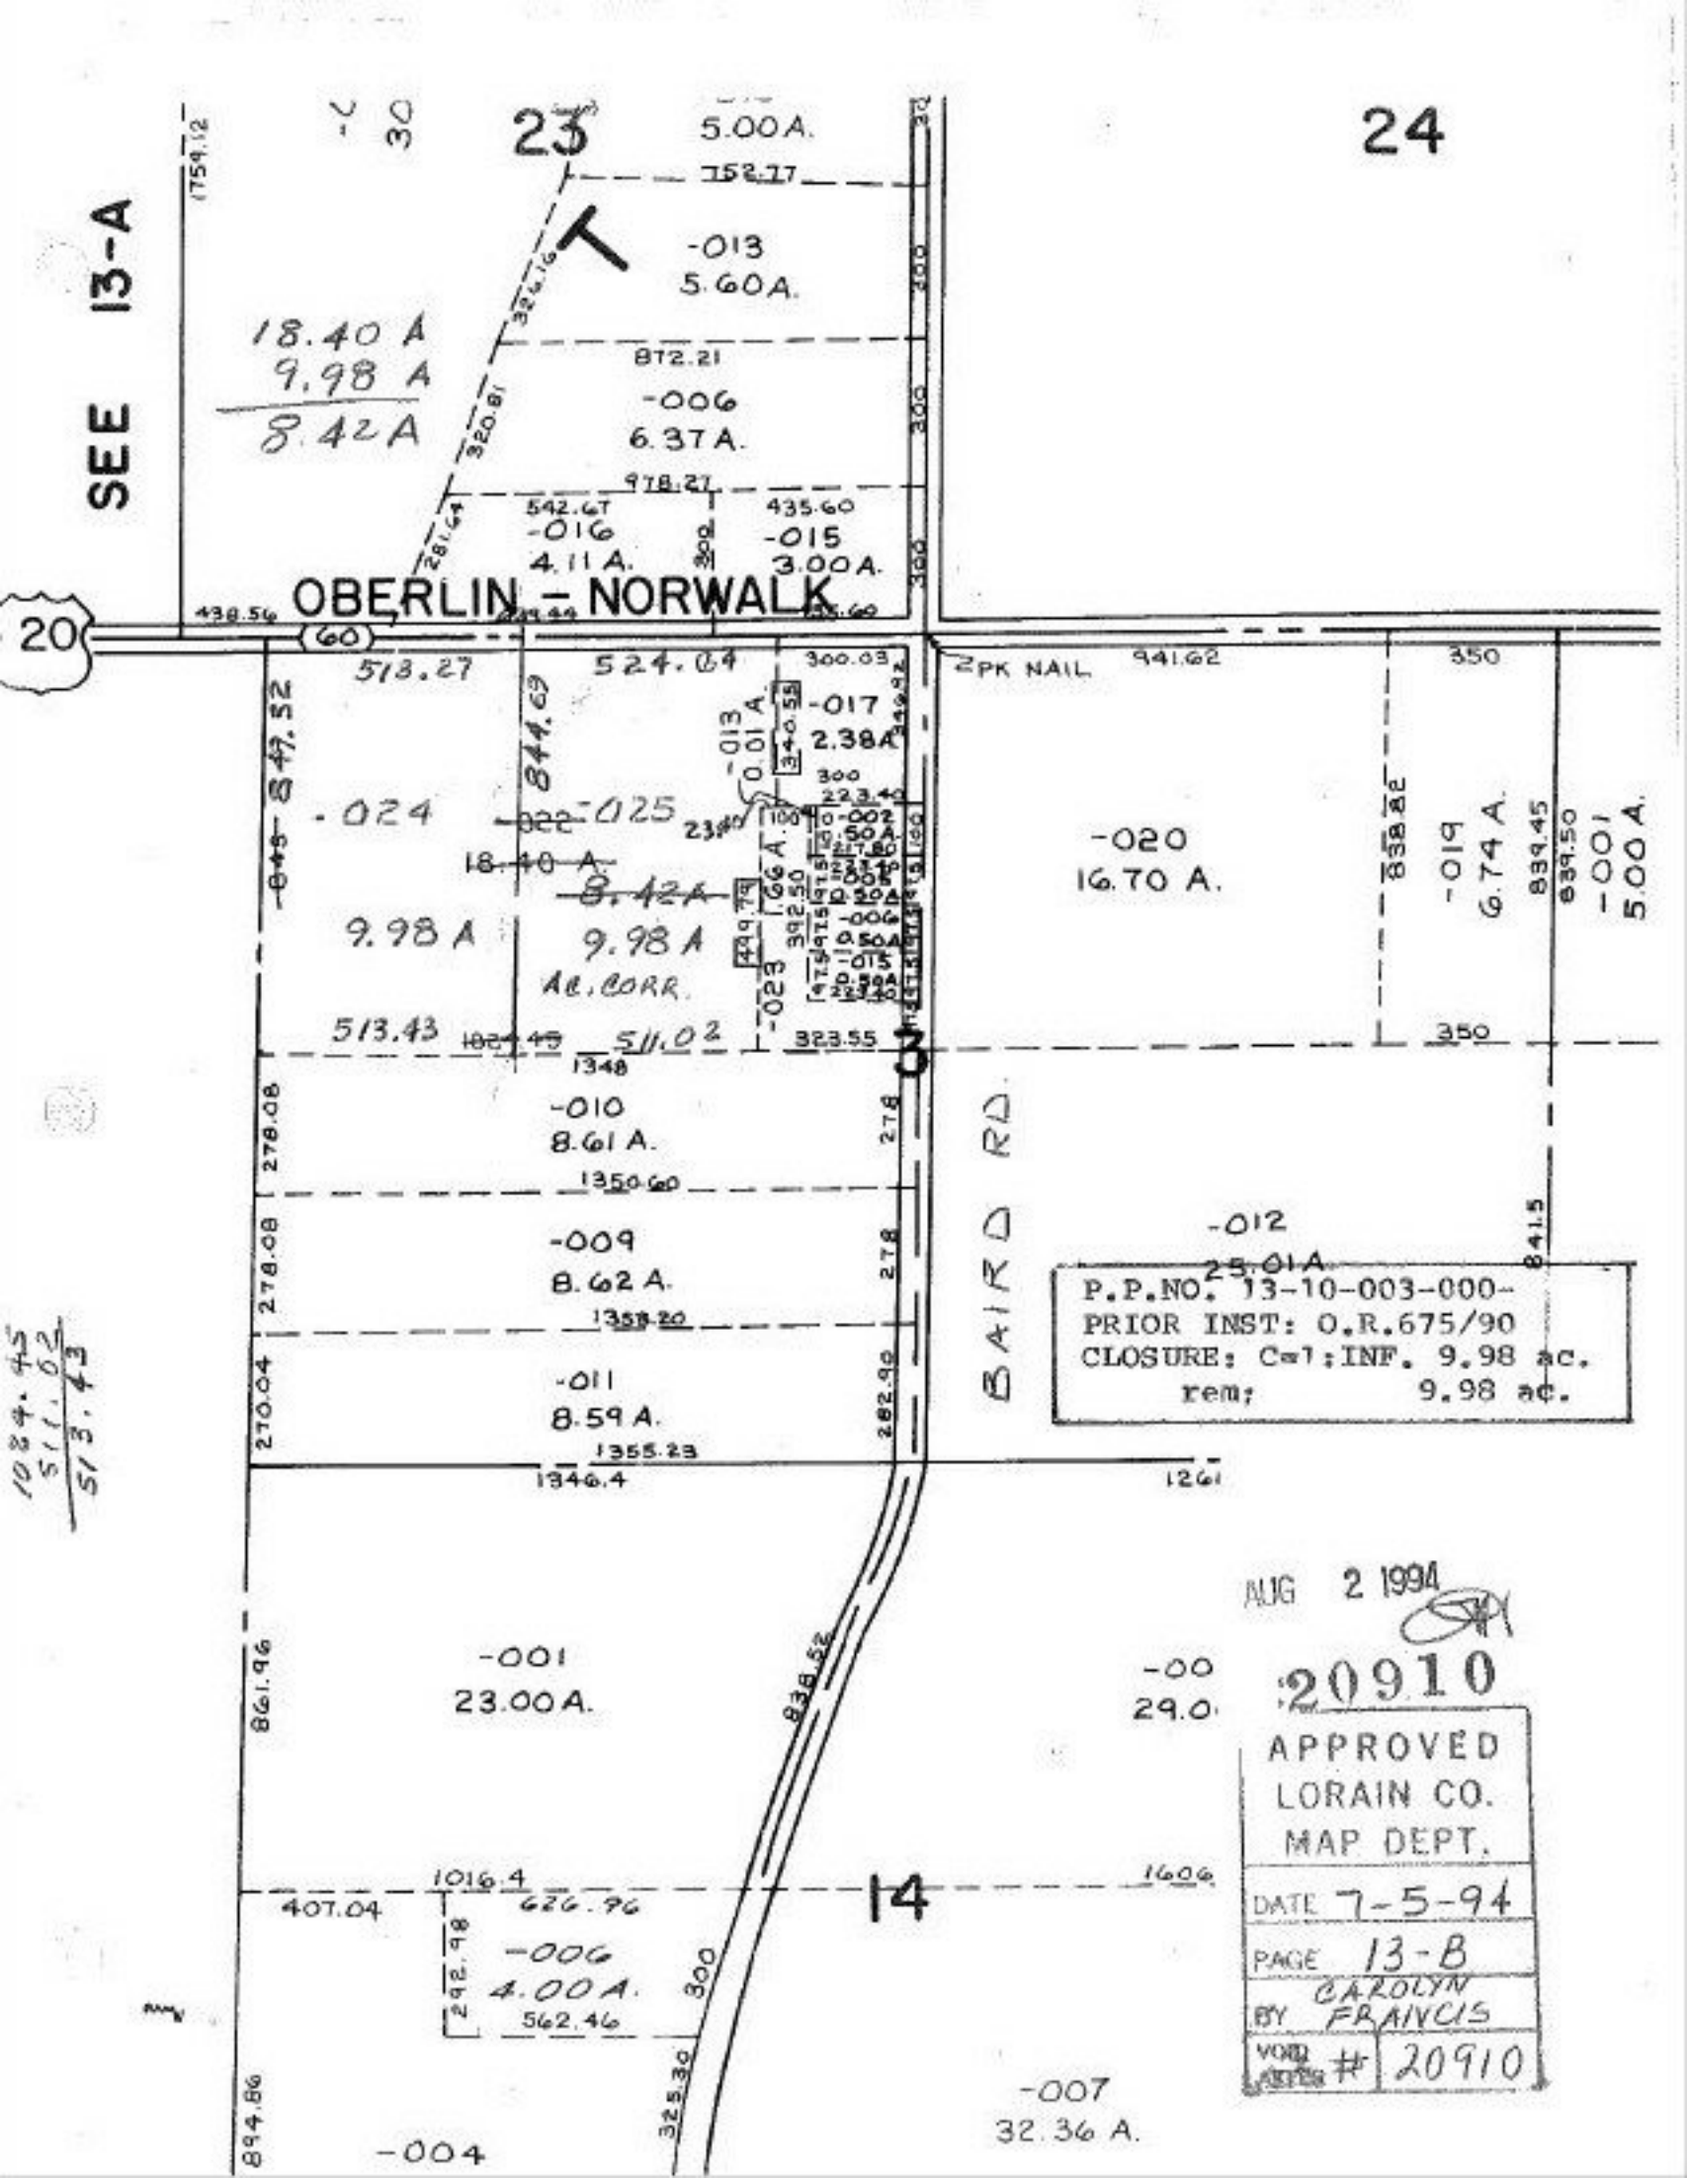
SEE 13-A
23
24
5.00A.
-013
5.60A.
18.40 A
9.98 A
8.42A
-006
6.37A.
-016
4.11A.
-015
3.00A.
OBERLIN - NORWALK
20
60
-017
2.38A
-024
-025
-020
16.70 A.
-019
6.74 A.
-001
5.00A.
9.98 A
9.98 A
AC. CORR.
-010
8.61 A.
-009
8.62 A.
-011
8.59 A.
-012
25.01A
BAIRD RD.
P.P.NO. 13-10-003-000-
PRIOR INST: O.R.675/90
CLOSURE: C=1:INF. 9.98 ac.
rem: 9.98 ac.
-001
23.00A.
-006
4.00A.
-007
32.36 A.
-004
14
AUG 2 1994
20910
APPROVED
LORAIN CO.
MAP DEPT.
DATE 7-5-94
PAGE 13-B
BY CAROLYN FRANCIS
VOID AFFIX # 20910