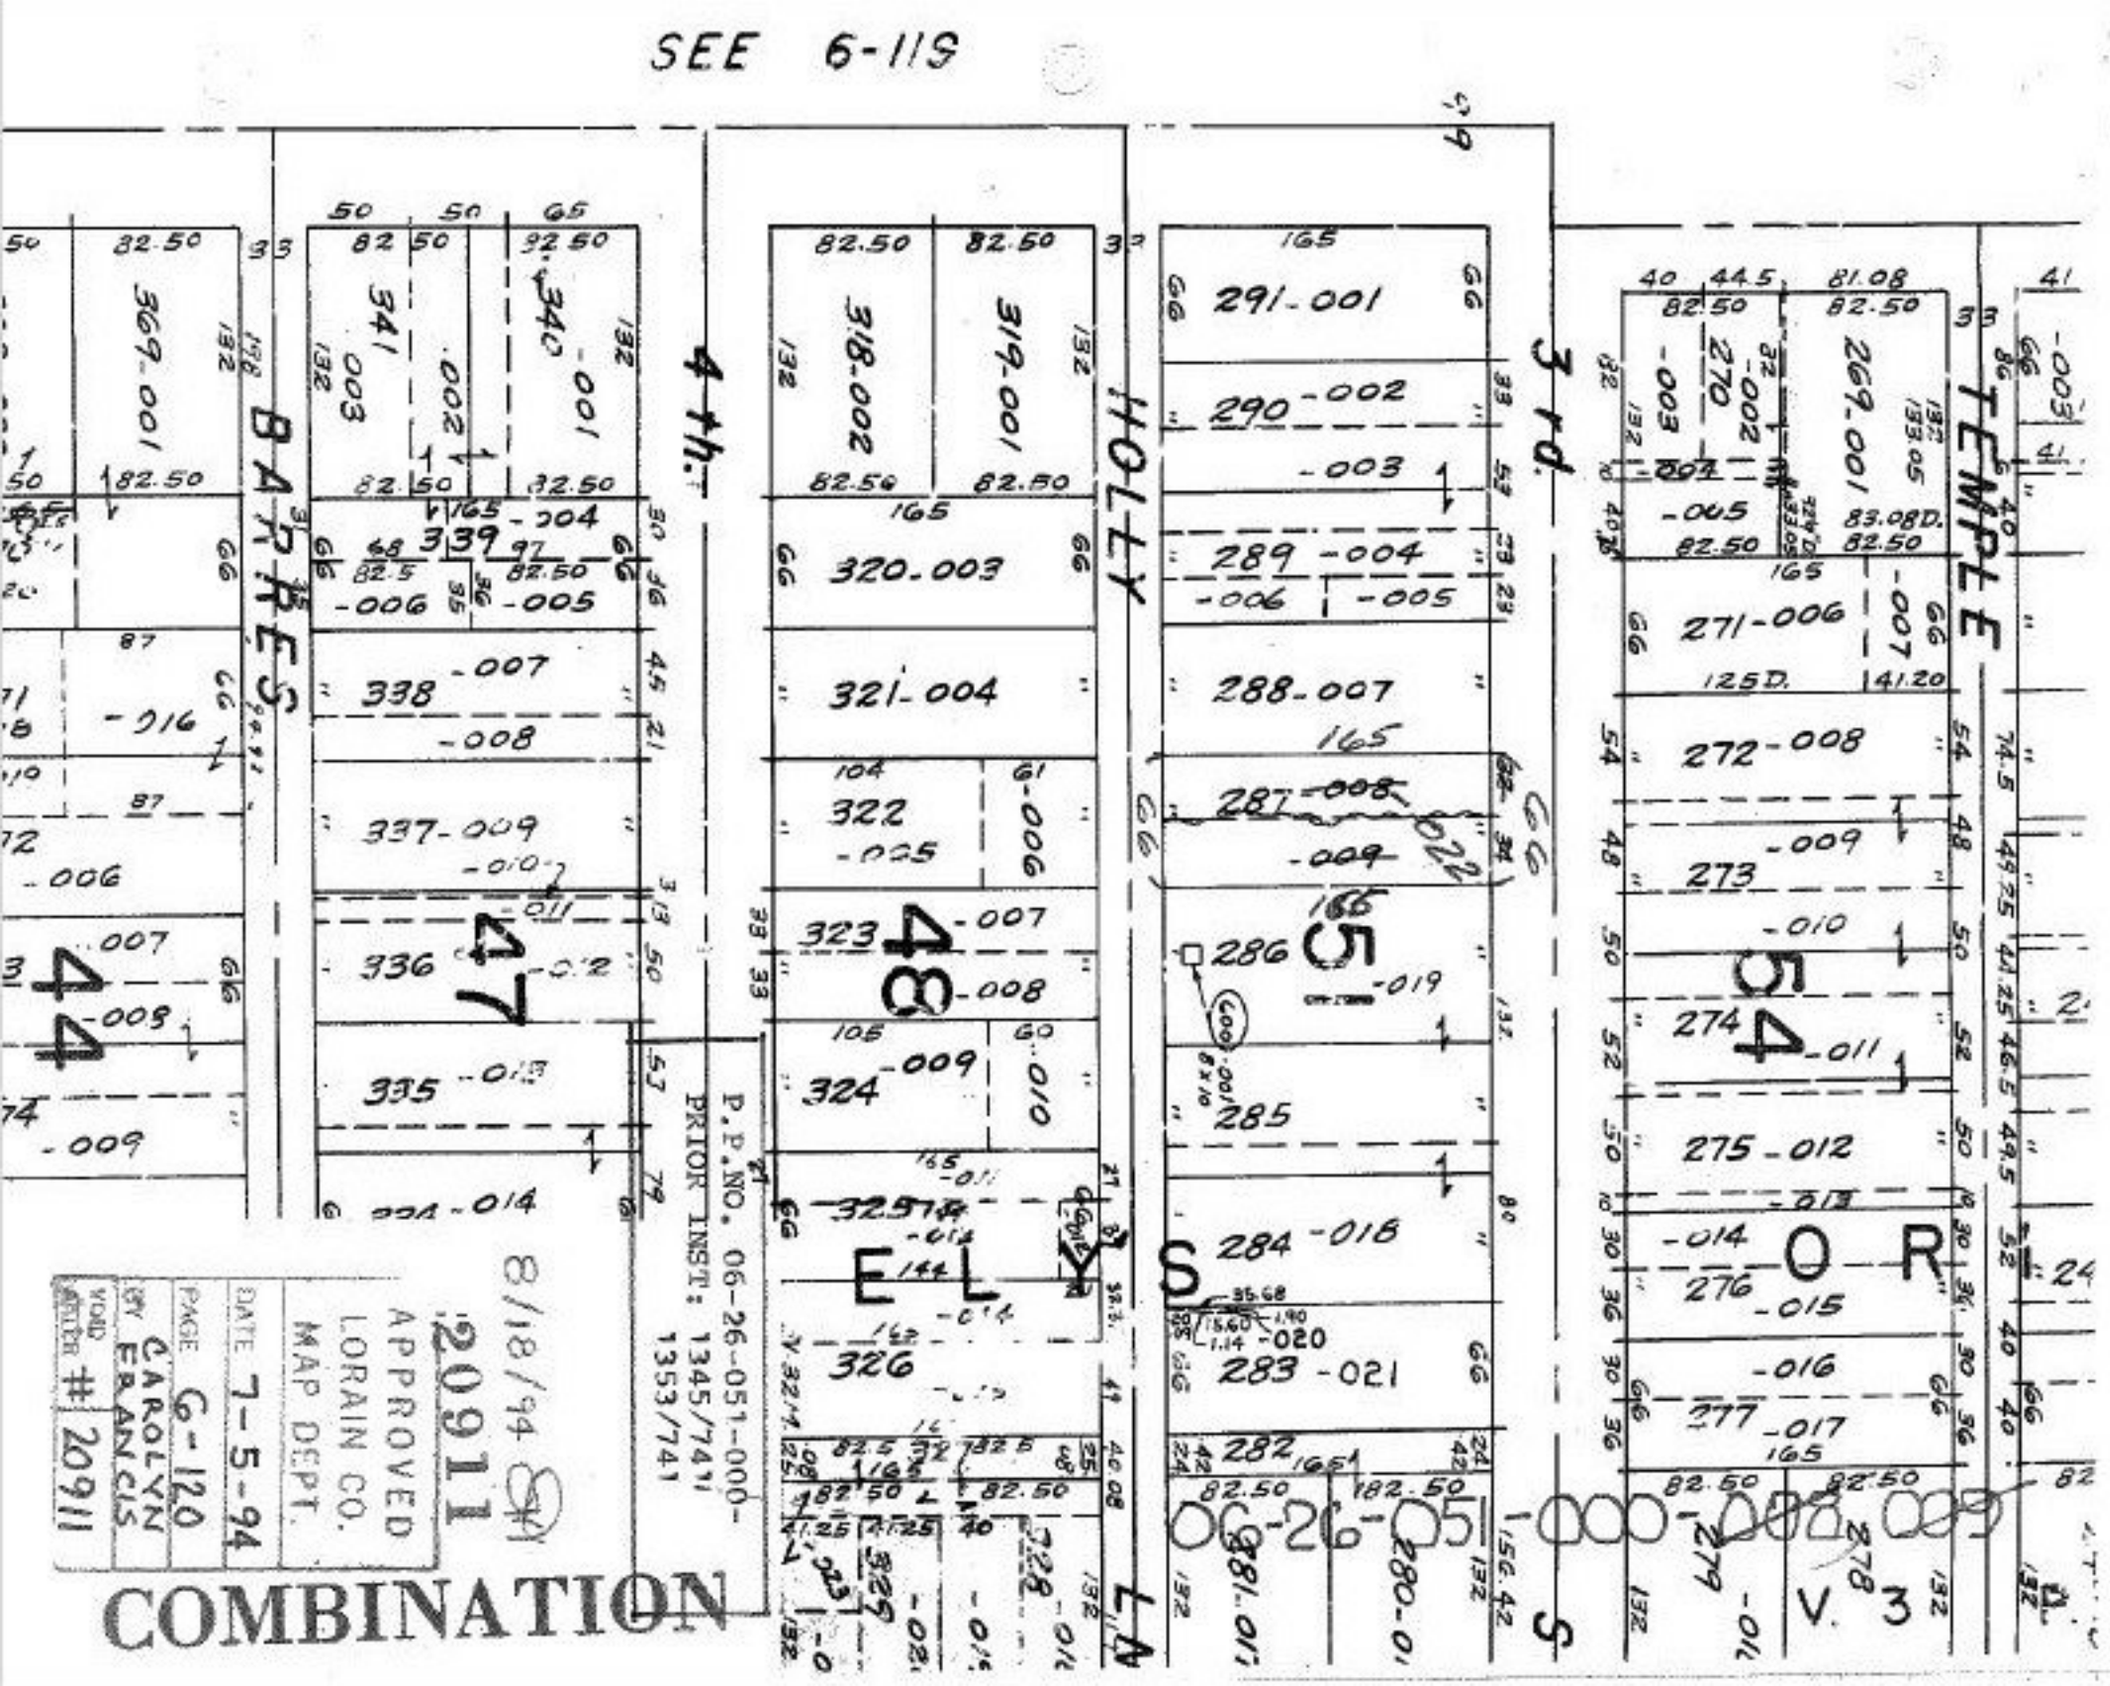
SEE 6-11S
BARNES
4th.
HOLLY
3rd.
TEMPLE
LA
369-001
341
340
-001
-002
-003
339
-004
-005
-006
338
-007
-008
337-009
-010
-011
336
-012
335
-013
-014
-016
-009
318-002
319-001
320.003
321-004
322
-005
-006
323
-007
-008
324
-009
-010
325
-011
-012
326
-013
-014
291-001
290
-002
-003
289
-004
-005
-006
288-007
287
-008
-009
286
-019
285
284
-018
283
-021
282
-020
-022
281-011
280-01
279
-012
278
269-001
270
-002
-003
-004
-005
271-006
-007
272-008
-009
273
-010
274
-011
275-012
-013
-014
276
-015
-016
277
-017
-018
P.P.NO. 06-26-051-000-
PRIOR INST: 1345/741
1353/741
8/18/94
20911
APPROVED
LORAIN CO.
MAP DEPT.
DATE 7-5-94
PAGE G-120
BY CAROLYN FRANCIS
VOID
ENTER # 20911
COMBINATION
06-26-051-000-
20911