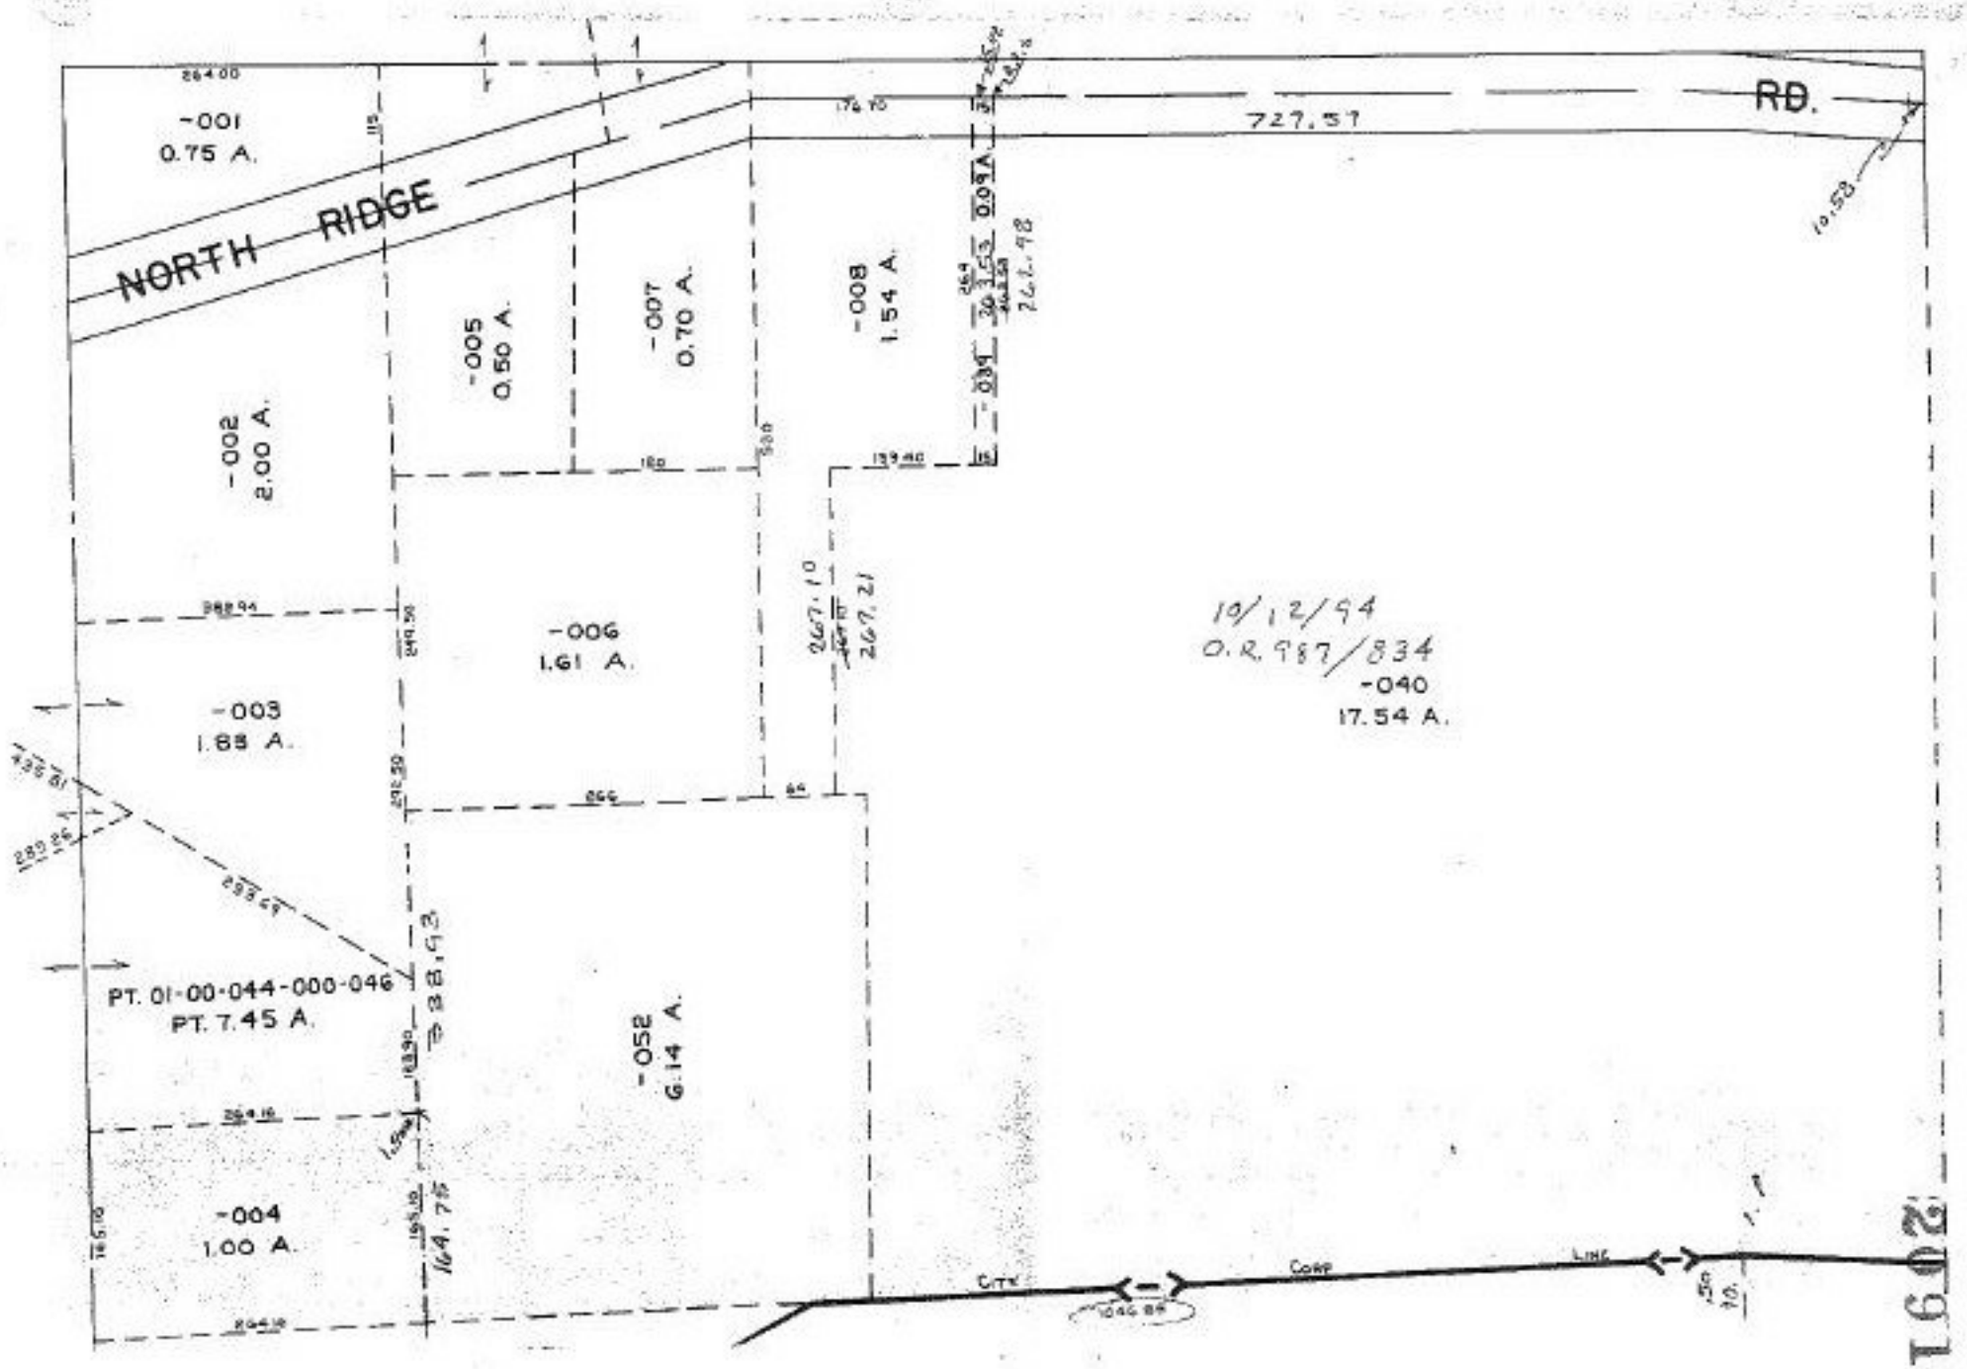
NORTH RIDGE
RD.
727.57
-001
0.75 A.
-002
2.00 A.
-003
1.88 A.
-004
1.00 A.
-005
0.50 A.
-006
1.61 A.
-007
0.70 A.
-008
1.54 A.
-052
6.14 A.
-040
17.54 A.
10/12/94
O.R. 987/834
PT. 01-00-044-000-046
PT. 7.45 A.
CTR
Comp
Line