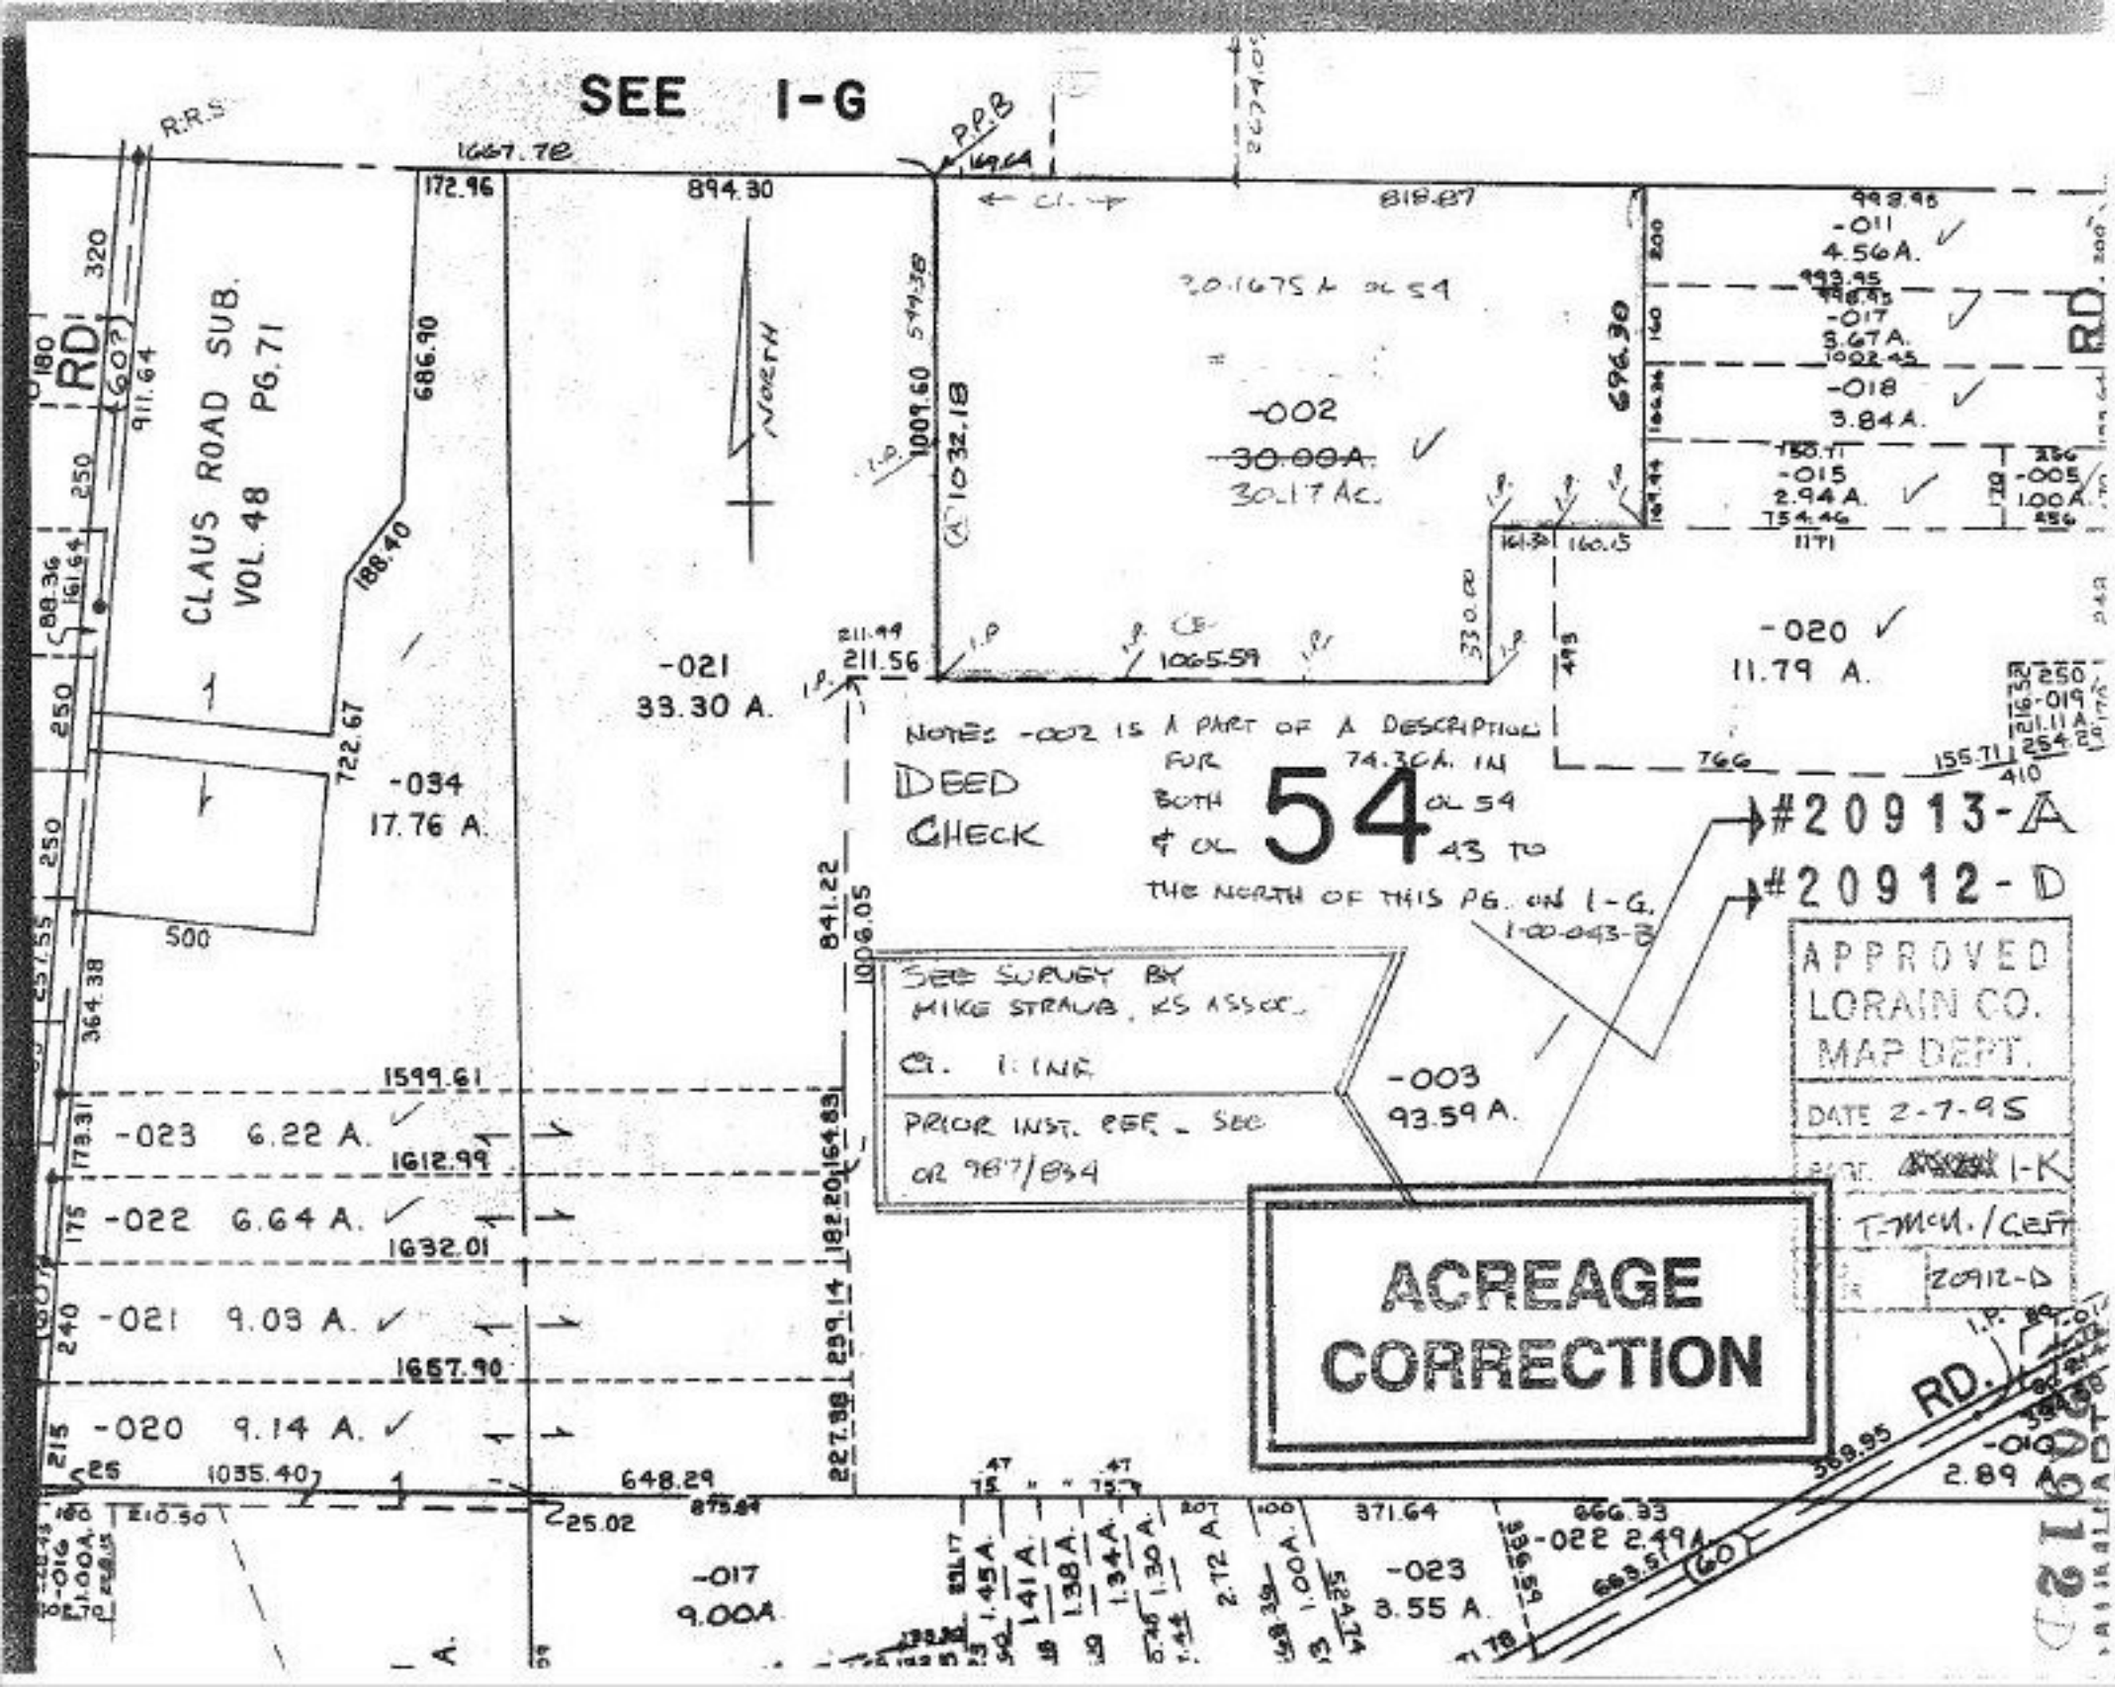
SEE I-G
R.R.S
CLAUS ROAD SUB.
VOL. 48 PG. 71
RD
NORTH
-002
30.00A.
30.17 Ac.
-011
4.56A.
-017
3.67A.
-018
3.84A.
-015
2.94A.
-005
1.00A.
-020
11.79 A.
-021
33.30 A.
-034
17.76 A.
NOTE: -002 IS A PART OF A DESCRIPTION FOR 74.30A. IN BOTH OL 54 & OL 43 TO THE NORTH OF THIS PG. ON I-G.
DEED CHECK
54
#20913-A
#20912-D
SEE SURVEY BY MIKE STRAUB, KS ASSOC.
Cl. 1:1NF
PRIOR INST. REF. - SEE OR 987/834
-003
93.59 A.
-023 6.22 A.
-022 6.64 A.
-021 9.03 A.
-020 9.14 A.
-017
9.00A.
-023
3.55 A.
-022 2.49A.
-010
2.89 A.
APPROVED
LORAIN CO.
MAP DEPT.
DATE 2-7-95
PAGE 1-K
T-MCN./CEFT
20912-D
ACREAGE
CORRECTION
20913A
20912D