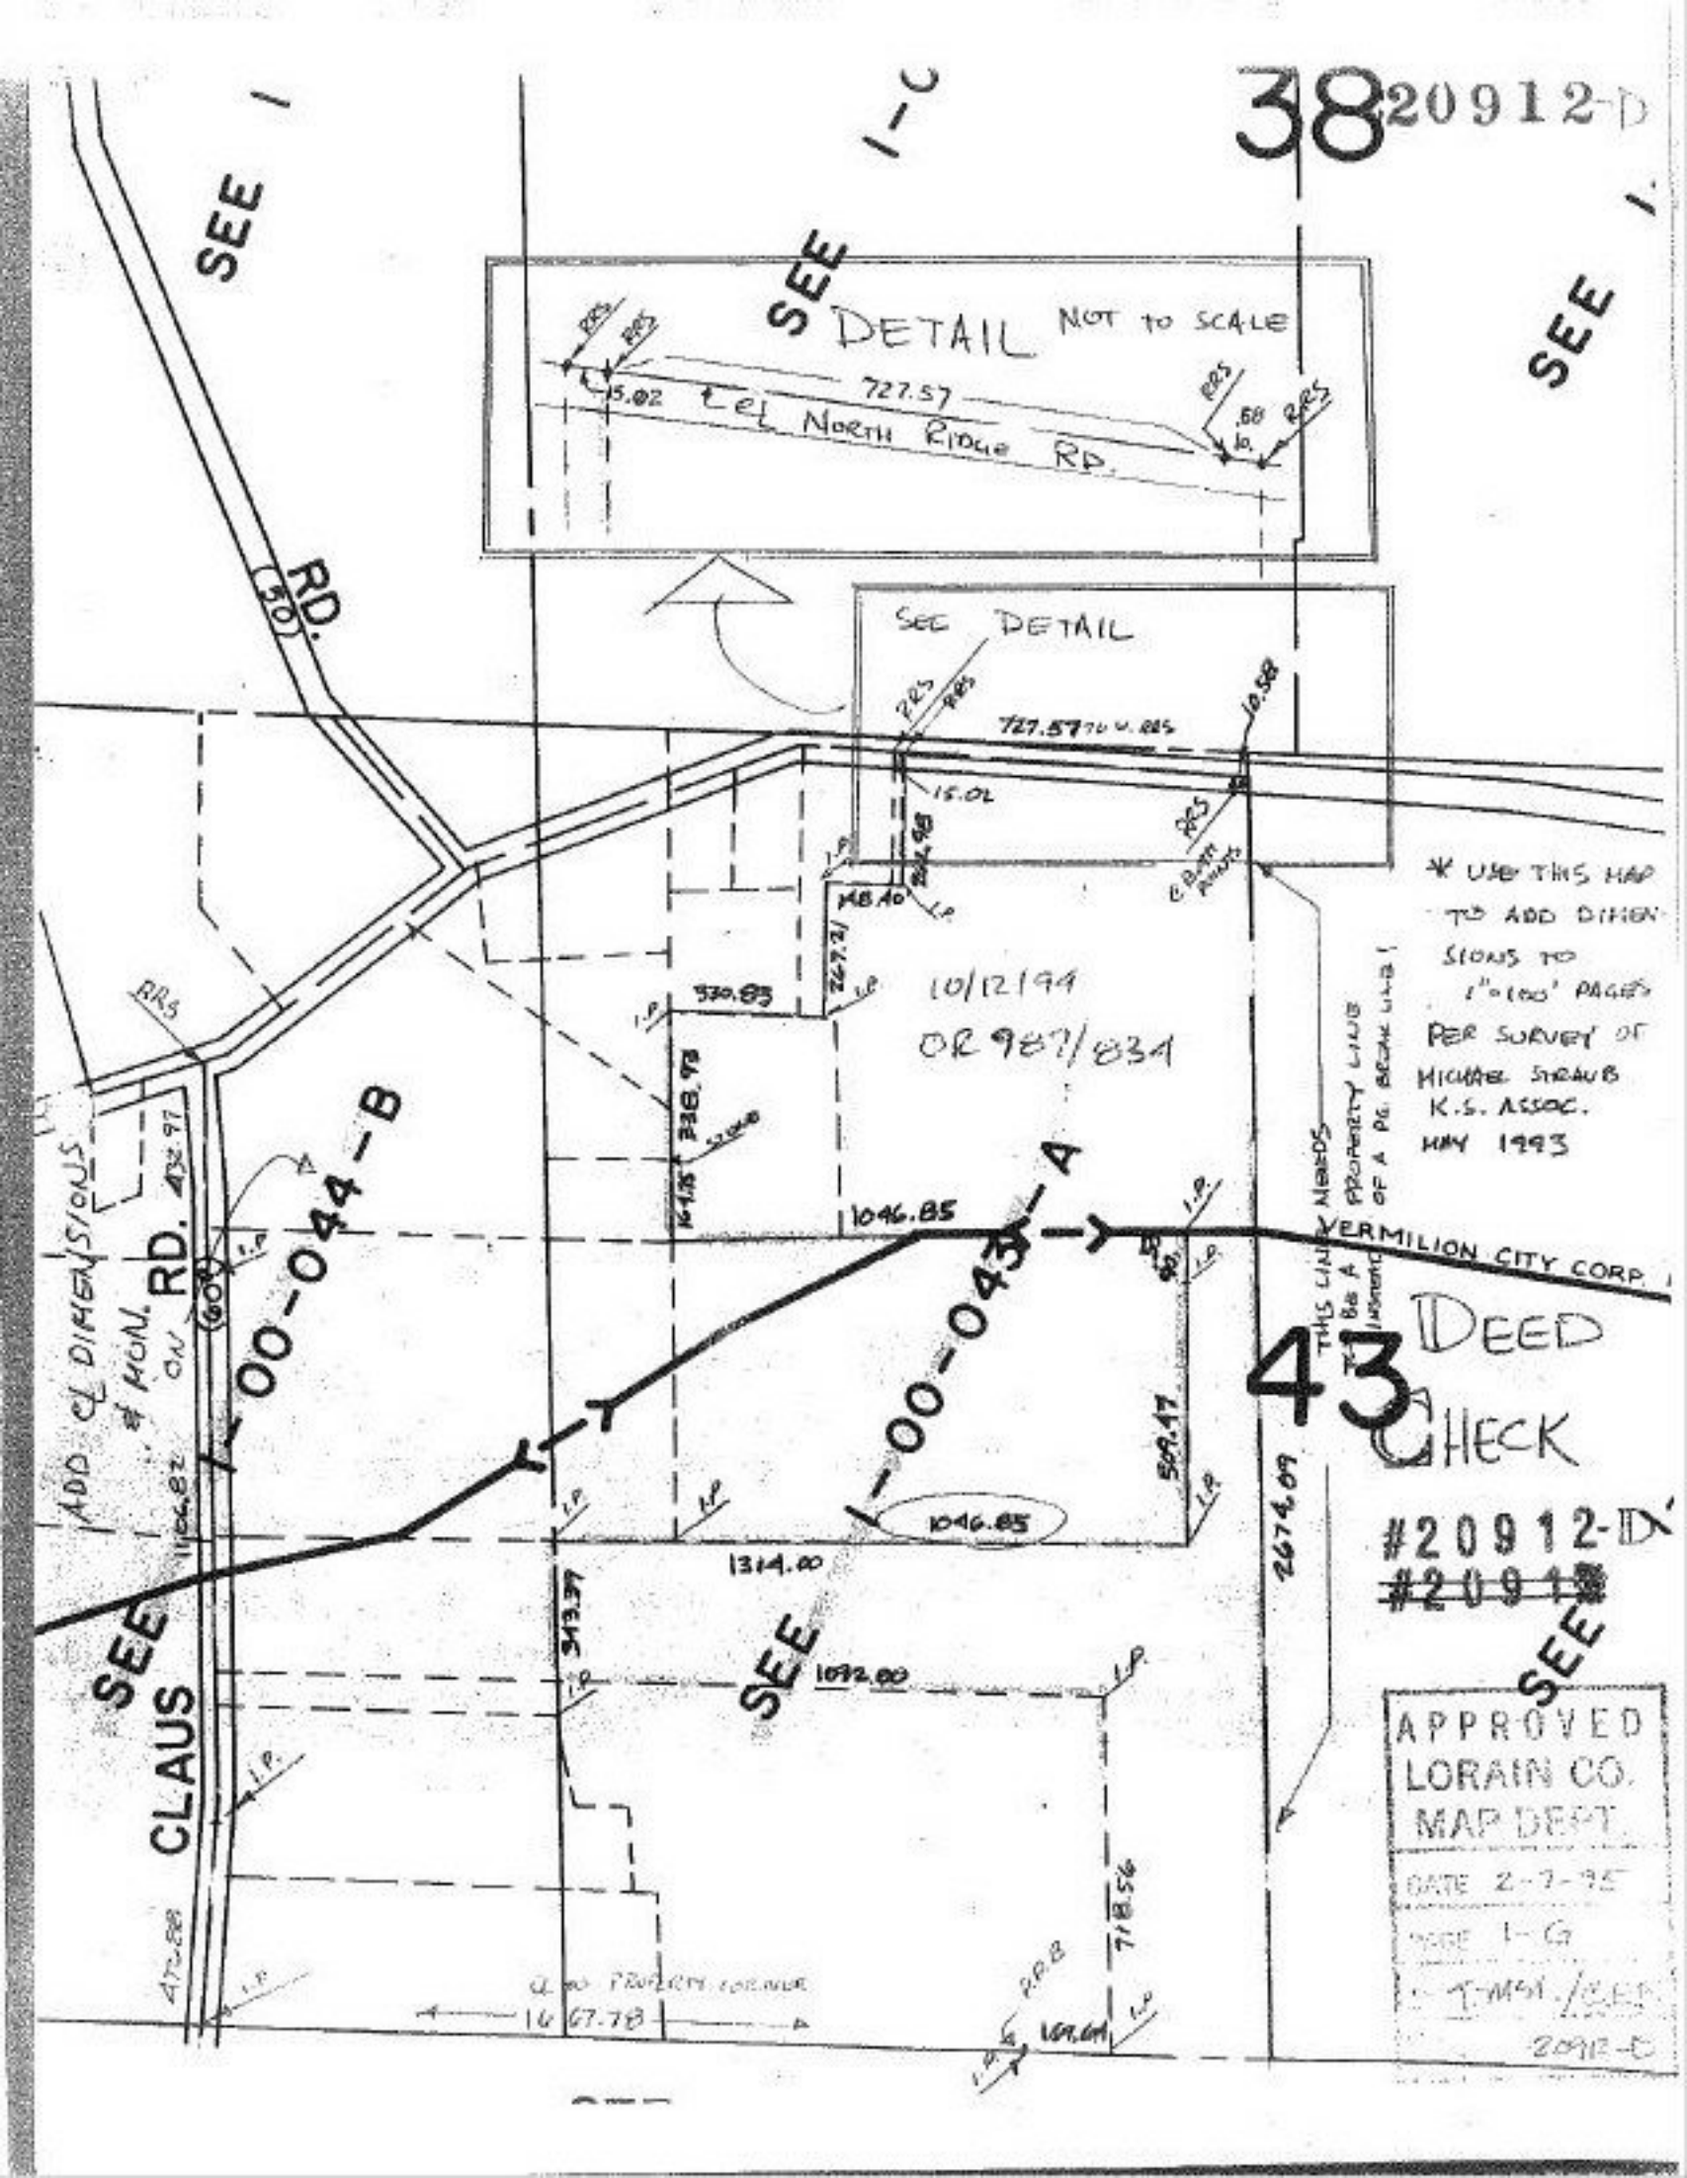
38
20912-D
SEE 1
SEE 1-C
SEE 1
DETAIL NOT TO SCALE
727.57
15.02
Tel. North Ridge Rd.
.58 to
RRS
SEE DETAIL
727.57 TO V. RDS
10.58
15.02
RRS
C.B.M.P.
1.P.
524.98
48.10
267.21
530.85
338.78
10/12/94
OR 987/831
RRS
1046.85
VERMILION CITY CORP.
THIS LINE NEEDS TO BE A PROPERTY LINE OF A PG. BRKM LINE
* USE THIS MAP TO ADD DIVISIONS TO 1"=100' PAGES PER SURVEY OF MICHAEL STRAUB K.S. ASSOC. MAY 1993
ADD CL DIMENSIONS
MON.
CW
RD.
60'
1166.82
43.97
00-044-B
00-043-A
43
DEED CHECK
#20912-D
#20918
509.17
1046.85
1314.00
2674.09
SEE
CLAUS
343.37
1092.00
718.56
47.88
CL TO PROPERTY CORNER
16 67.78
P.O.B.
169.64
APPROVED
LORAIN CO.
MAP DEPT.
DATE 2-7-95
PAGE 1-G
T-MAP
20912-D