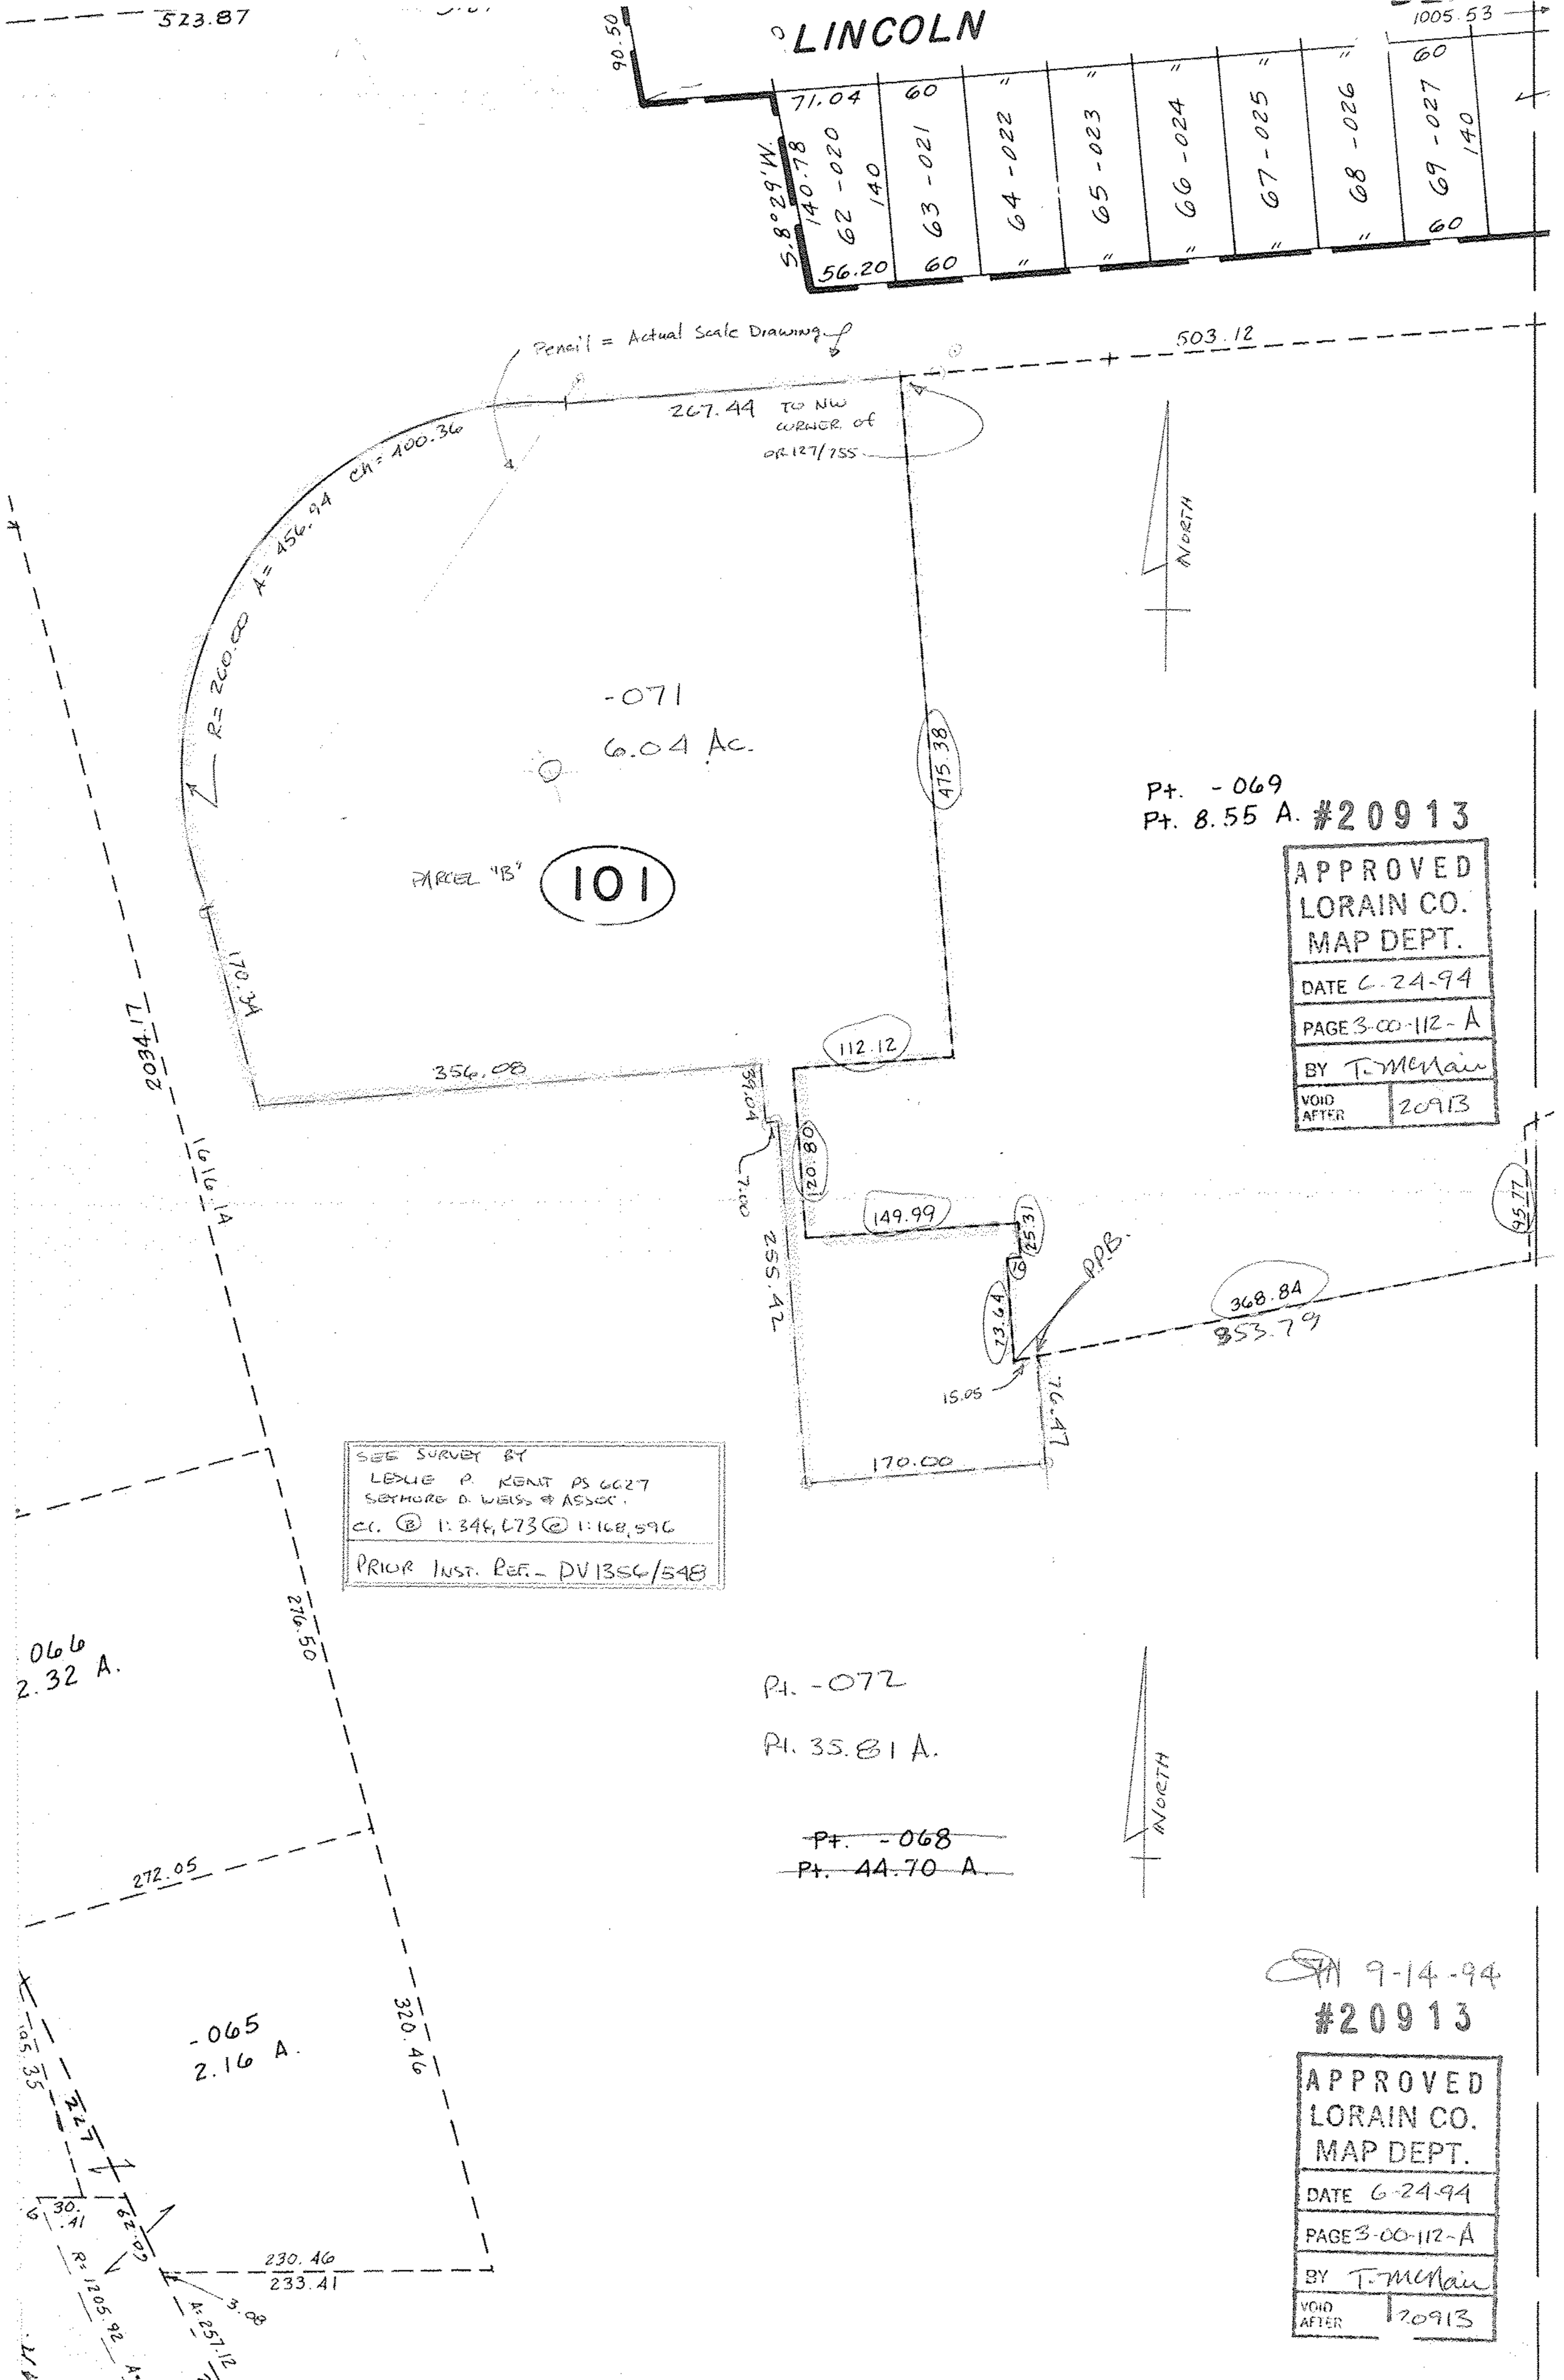
LINCOLN
523.87
1005.53
90.50
71.04
60
140.78
140
56.20
S.8°29'W.
62 -020
63 -021
64 -022
65 -023
66 -024
67 -025
68 -026
69 -027
Pencil = Actual Scale Drawing
503.12
267.44 TO NW CORNER of OR 127/755
R= 260.00 A= 456.94 CH= 400.36
NORTH
-071
6.04 Ac.
475.38
PARCEL "B" 101
170.34
356.08
112.12
2034.17
616.14
120.80
149.99
255.42
25.31
23.64
15.05
26.47
170.00
368.84
353.79
95.77
PPB.
Pt. -069
Pt. 8.55 A. #20913
APPROVED LORAIN CO. MAP DEPT.
DATE 6-24-94
PAGE 3-00-112-A
BY T. McMain
VOID AFTER 20913
SEE SURVEY BY
LESLIE P. KENT PS 6627
SEYMORE D. WEISS & ASSOC.
CL. (B) 1:346,673 (C) 1:168,596
PRIOR INST. REF. - DV 1356/548
066
2.32 A.
276.50
272.05
Pt. -072
Pt. 35.81 A.
~~Pt. -068~~
~~Pt. 44.70 A.~~
NORTH
-065
2.16 A.
320.46
105.35
30.41
62.02
230.46
233.41
3.08
R= 1205.92
A= 257.12
9-14-94
#20913
APPROVED LORAIN CO. MAP DEPT.
DATE 6-24-94
PAGE 3-00-112-A
BY T. McMain
VOID AFTER 20913