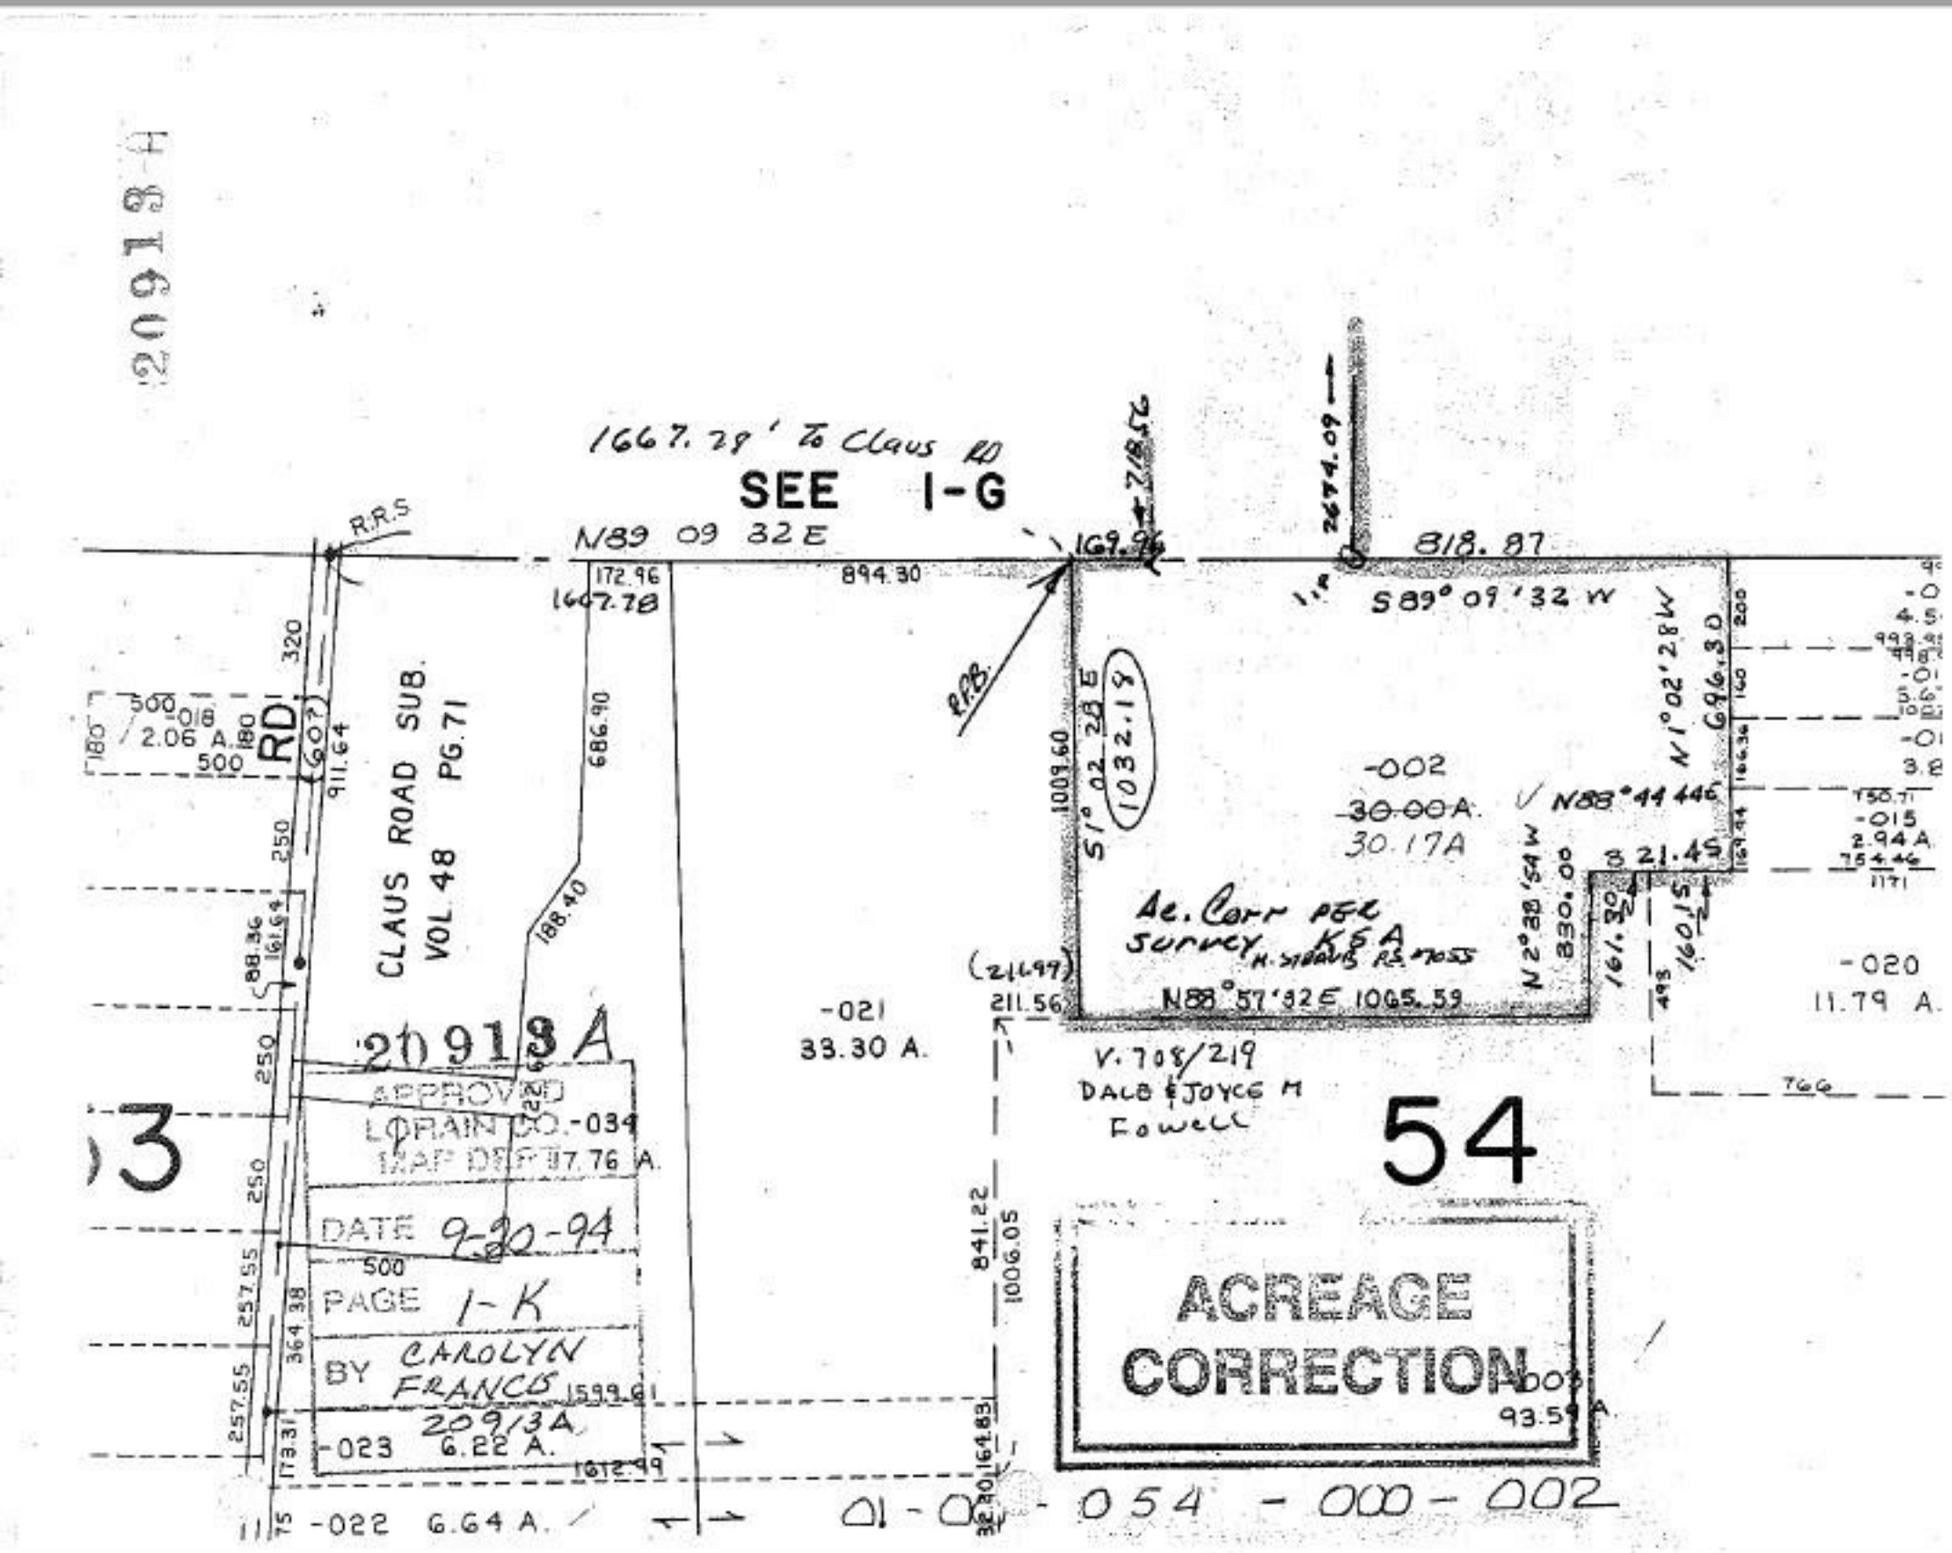

20913 A
1667.28' To Claus RD
SEE 1-G
N89 09 32 E
R.R.S
172.96
1667.78
894.30
169.96
718.56
2674.09
818.87
S89° 09' 32 W
CLAUS ROAD SUB.
VOL 48 PG.71
RD
2.06 A.
911.64
686.90
188.40
1009.60
S1° 02' 28 E
1032.18
-002
30.00 A.
30.17A
N88° 44 44E
N1° 02' 28 W
696.30
-015
2.94 A.
Ac. Corr PER
Survey K&A
N88° 57' 32 E 1065.59
N2° 38' 54 W
330.00
161.30
160.15
-020
11.79 A.
-021
33.30 A.
211.56
V. 708/219
DALE & JOYCE M
Fowell
54
20913 A
APPROVED
LORAIN CO.
MAP DEPT
DATE 9-20-94
PAGE 1-K
BY CAROLYN FRANCIS
20913A
-034
17.76 A.
-023
6.22 A.
1599.61
1612.99
-022 6.64 A.
841.22
1006.05
ACREAGE
CORRECTION
93.59 A.
01-00-054-000-002