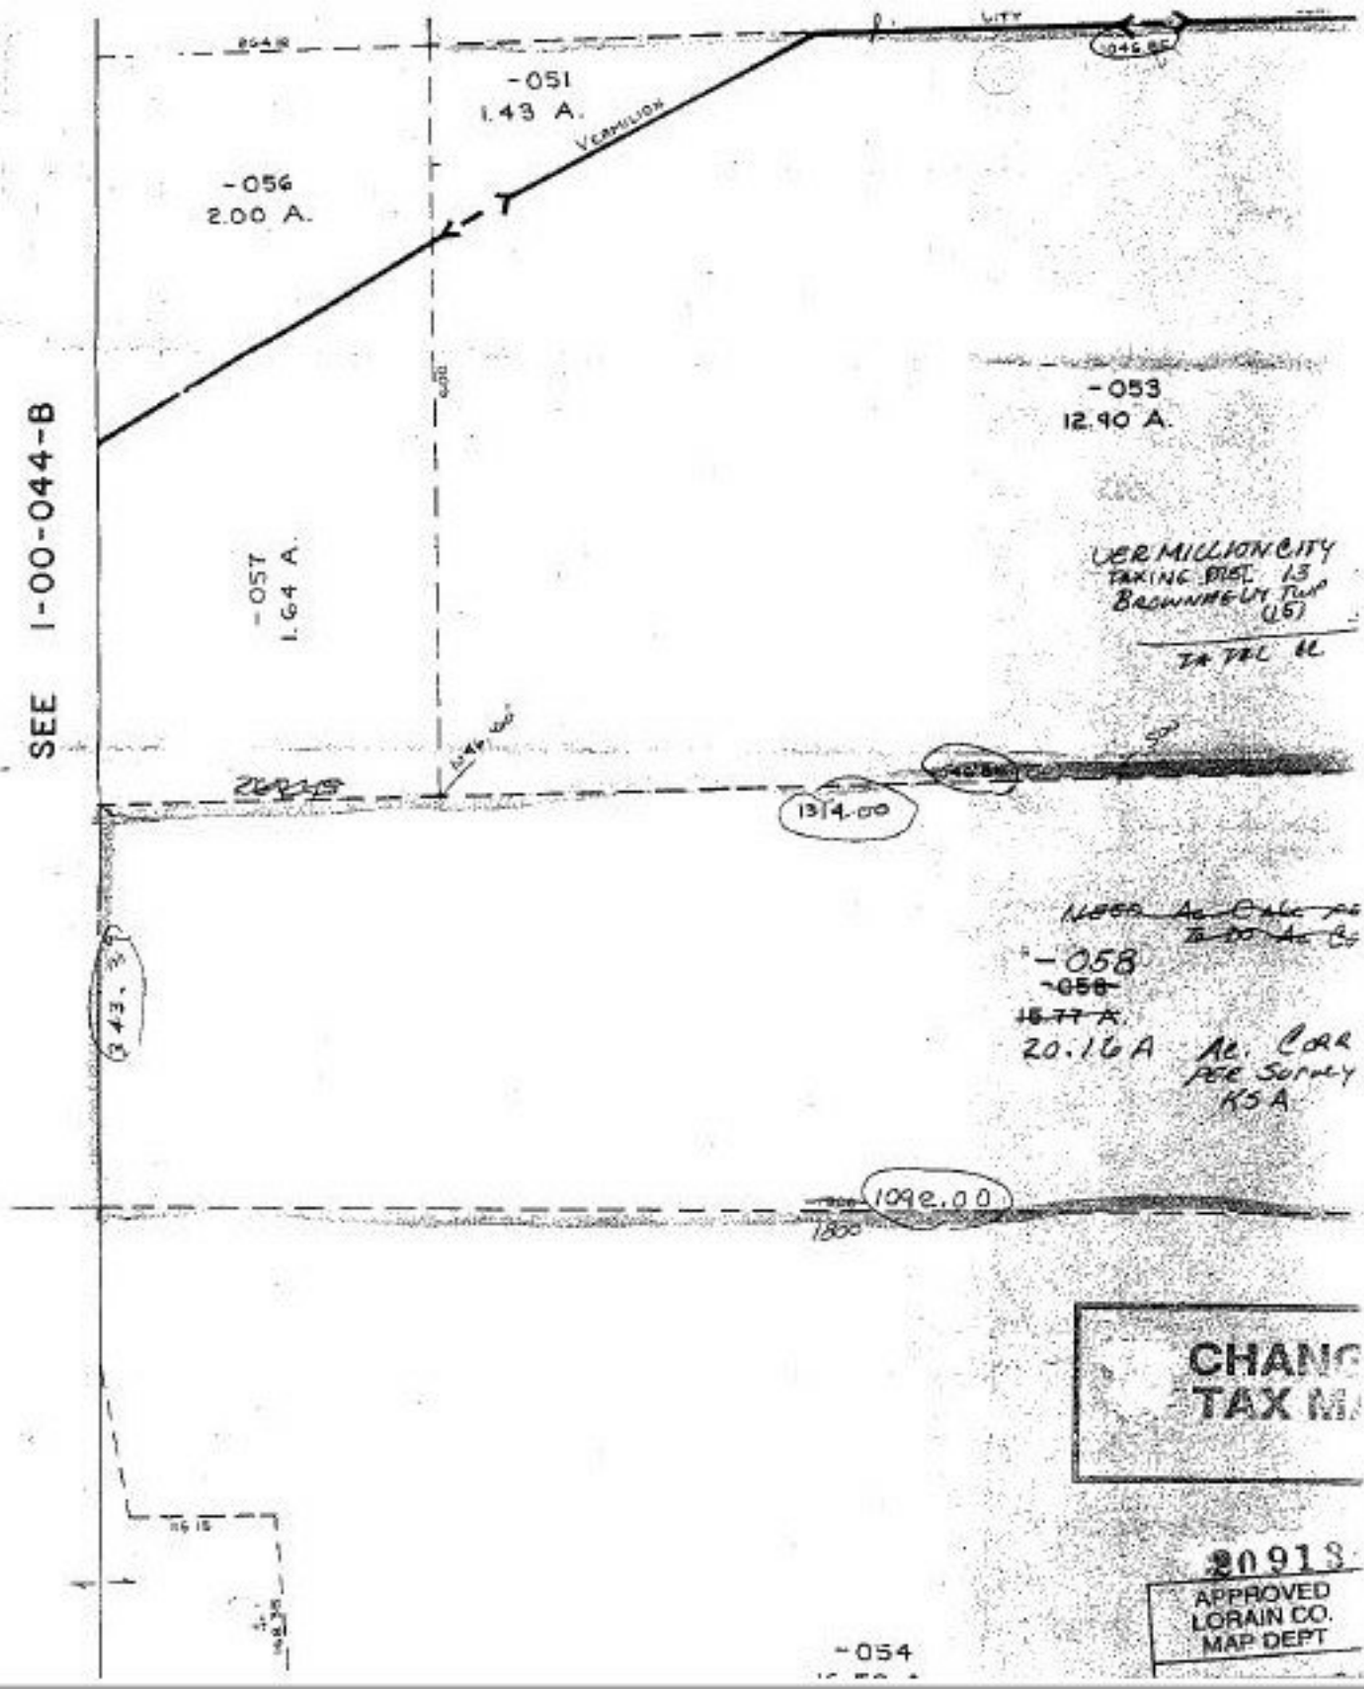

044-18-A
20913