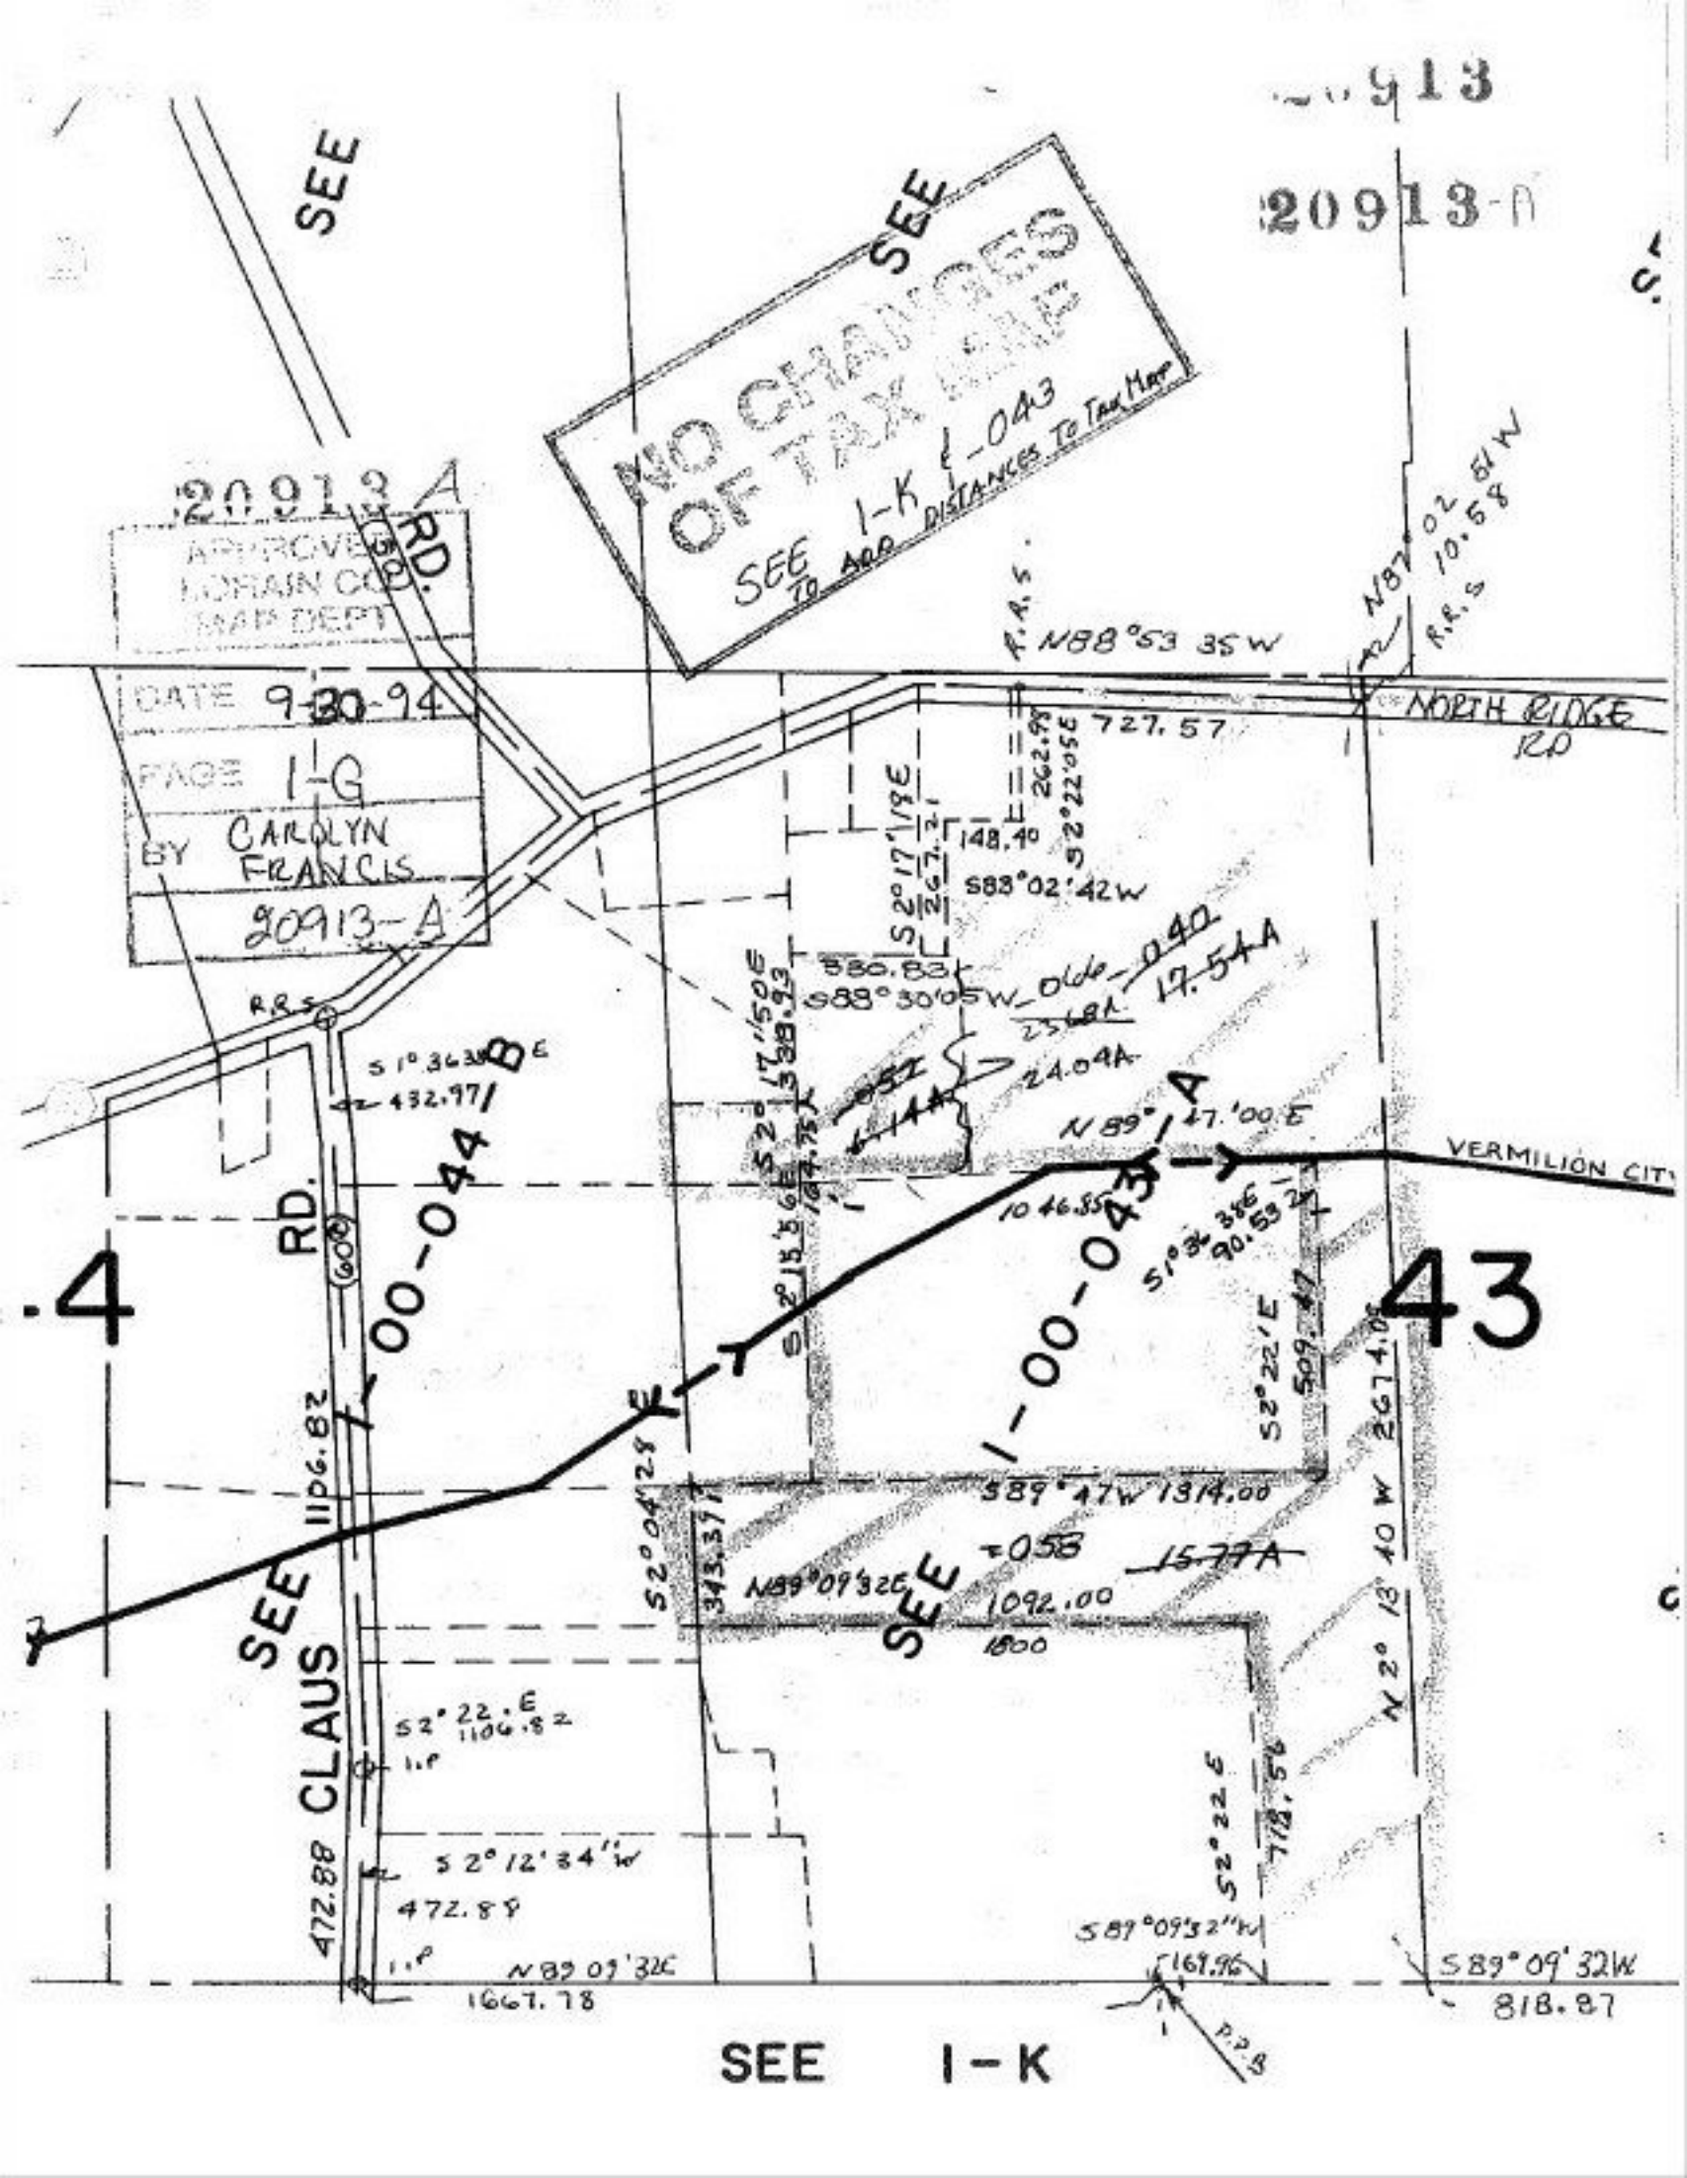
20913
20913-A
SEE
NO CHANGES OF TAX MAP
SEE 1-K
TO ADD DISTANCES TO TAX MAP
20913-A
APPROVED
MORAIN CO.
MAP DEPT.
DATE 9-30-94
PAGE 1-G
BY CAROLYN FRANCIS
20913-A
CLAUS RD. (50)
CLAUS RD. (60)
NORTH RIDGE RD
VERMILION CITY
R.R.S.
P.A.S.
N88°53 35W
N87°02 61W
10.58
727.57
S88°02'42W
148.40
262.95
S2°22'05E
S2°17'19E
580.83
S88°30'05W
0.40
17.54A
24.04A
0.57
6.44A
N89°47.00E
S1°36'38E
432.97
S2°15'06E
S1°36'38E
90.53
S2°22'1E
509.47
2674.06
N2°18'40W
S89°47W 1314.00
0.58
15.77A
N89°09'32E
1092.00
1800
S2°04'28E
343.37
1106.82
S2°22'1E
1106.82
1.P.
S2°12'34"W
472.88
1.P.
N89°09'32E
1667.78
718.56
S2°22'E
S89°09'32"W
169.96
S89°09'32W
818.87
SEE I-K
4
43