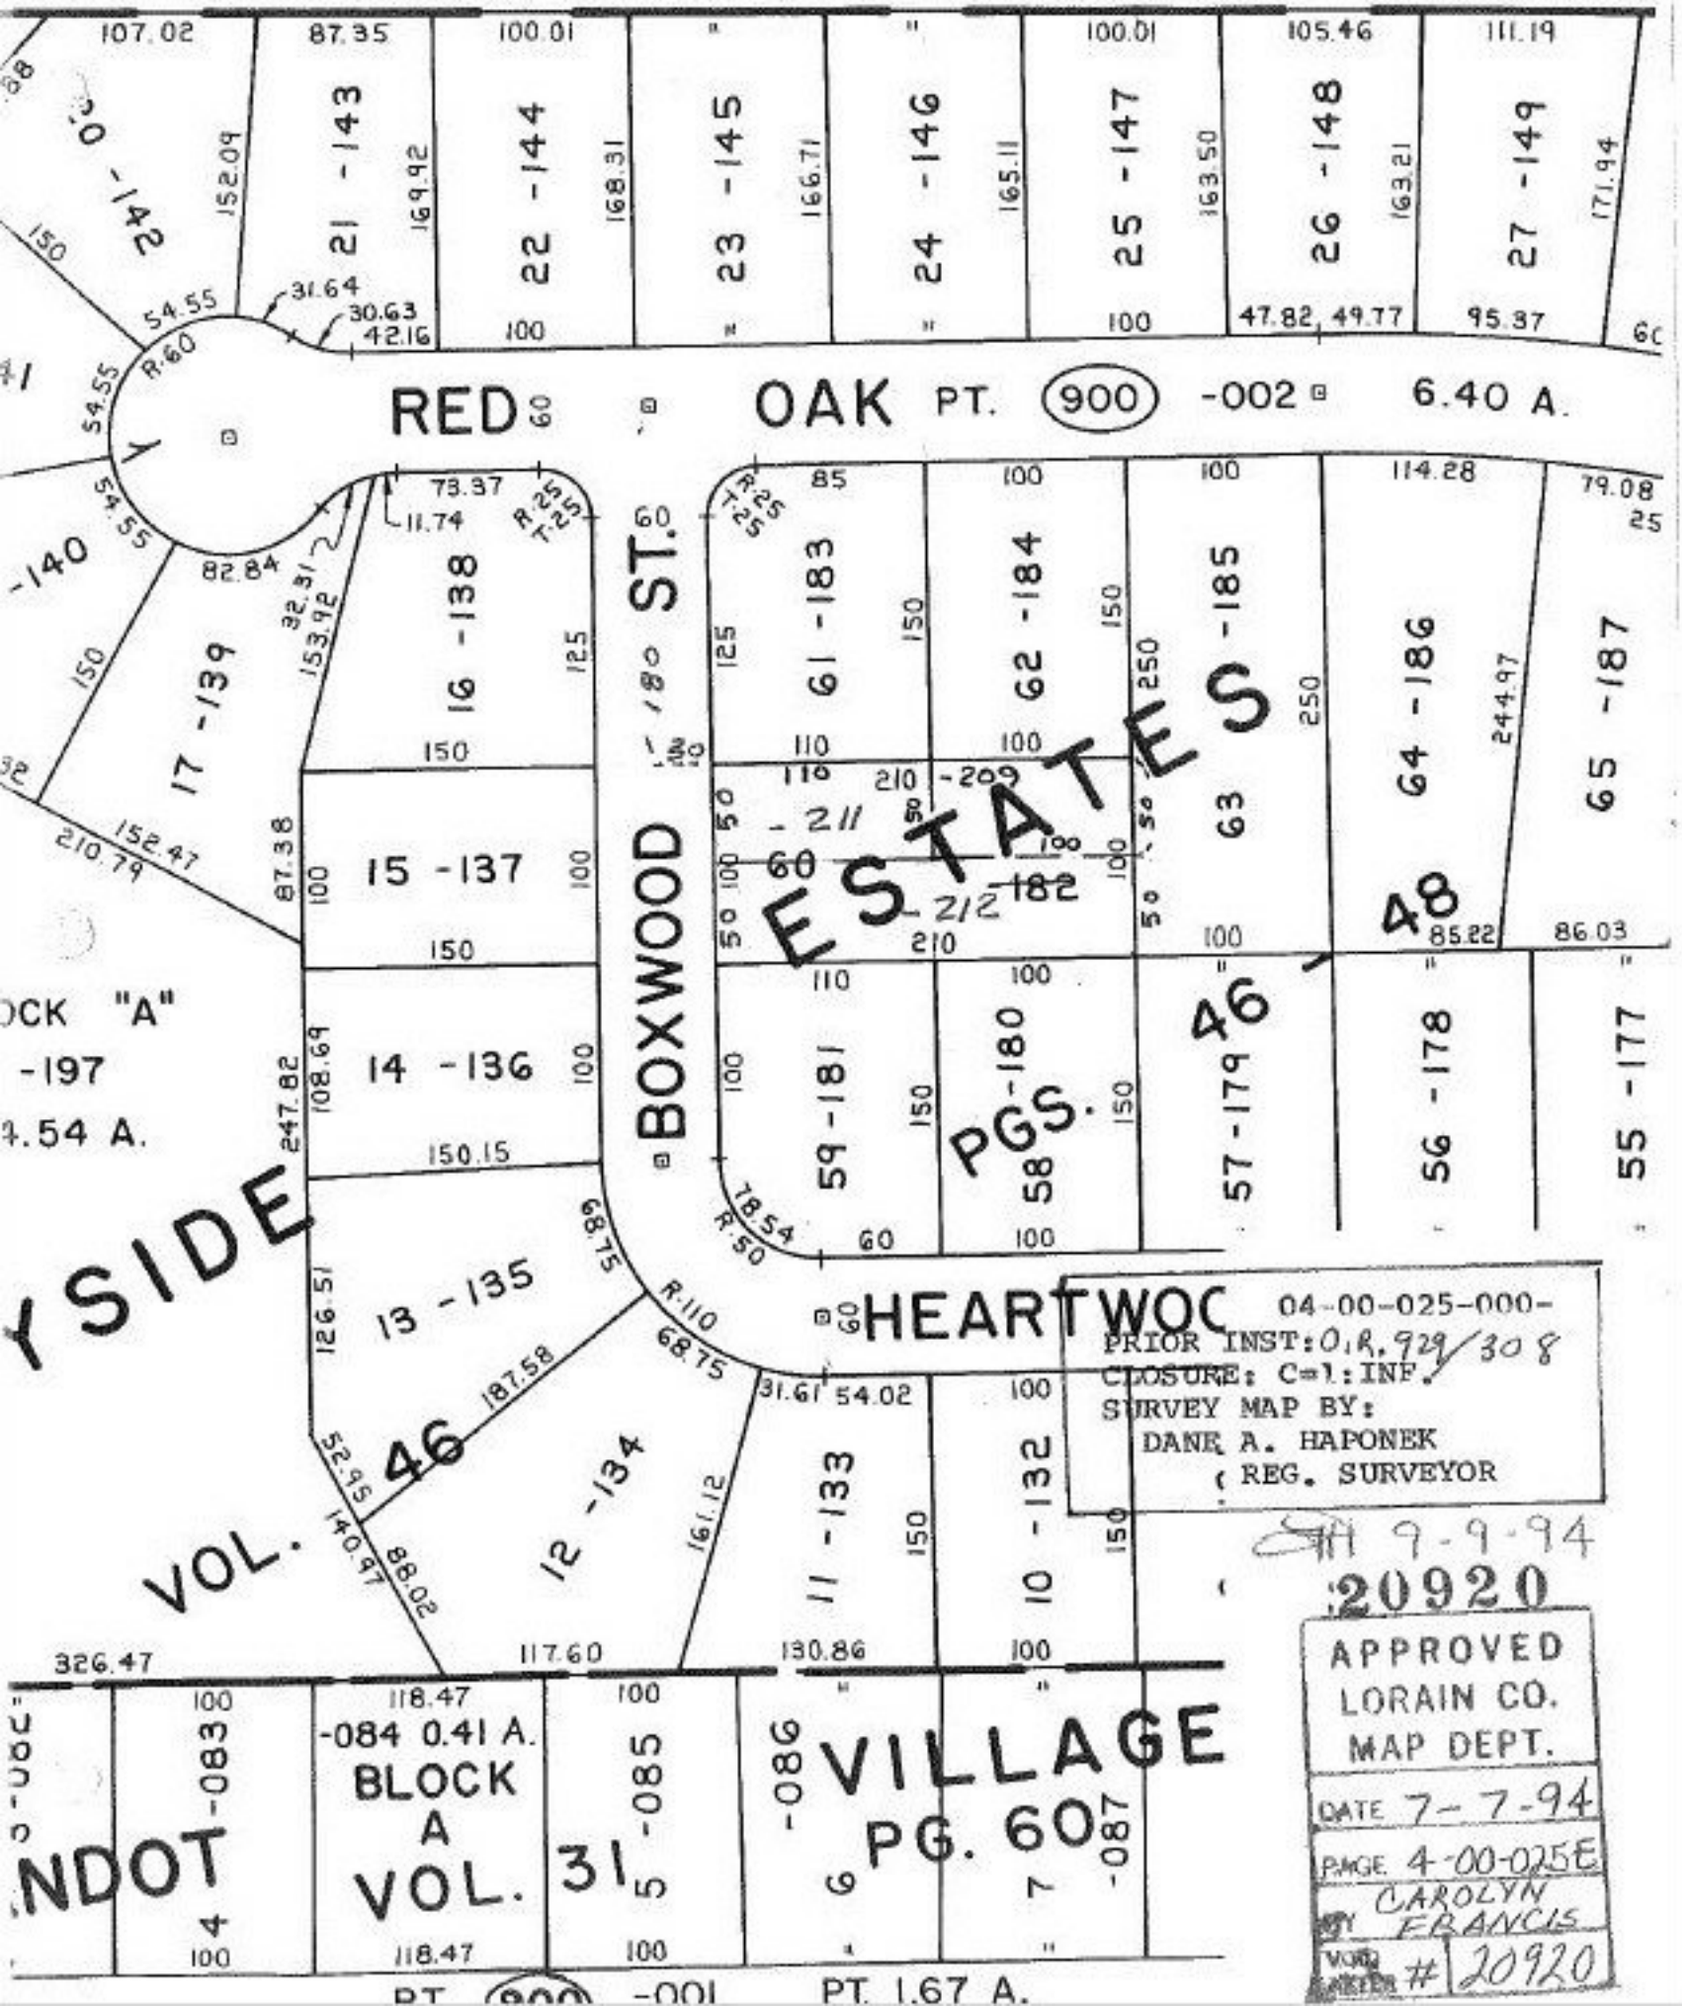
RED OAK PT. 900 -002 6.40 A.
BOXWOOD ST.
ESTATES
PGS. 180
HEARTWOC
VOL. 46
VILLAGE
VOL. 31 PG. 60
PT. 900 -001 PT. 1.67 A.
04-00-025-000-
PRIOR INST: O.R. 929/308
CLOSURE: Cpl: INF.
SURVEY MAP BY:
DANE A. HAPONEK
REG. SURVEYOR
9-9-94
20920
APPROVED
LORAIN CO.
MAP DEPT.
DATE 7-7-94
PAGE 4-00-025E
BY CAROLYN FRANCIS
VOID # 20920