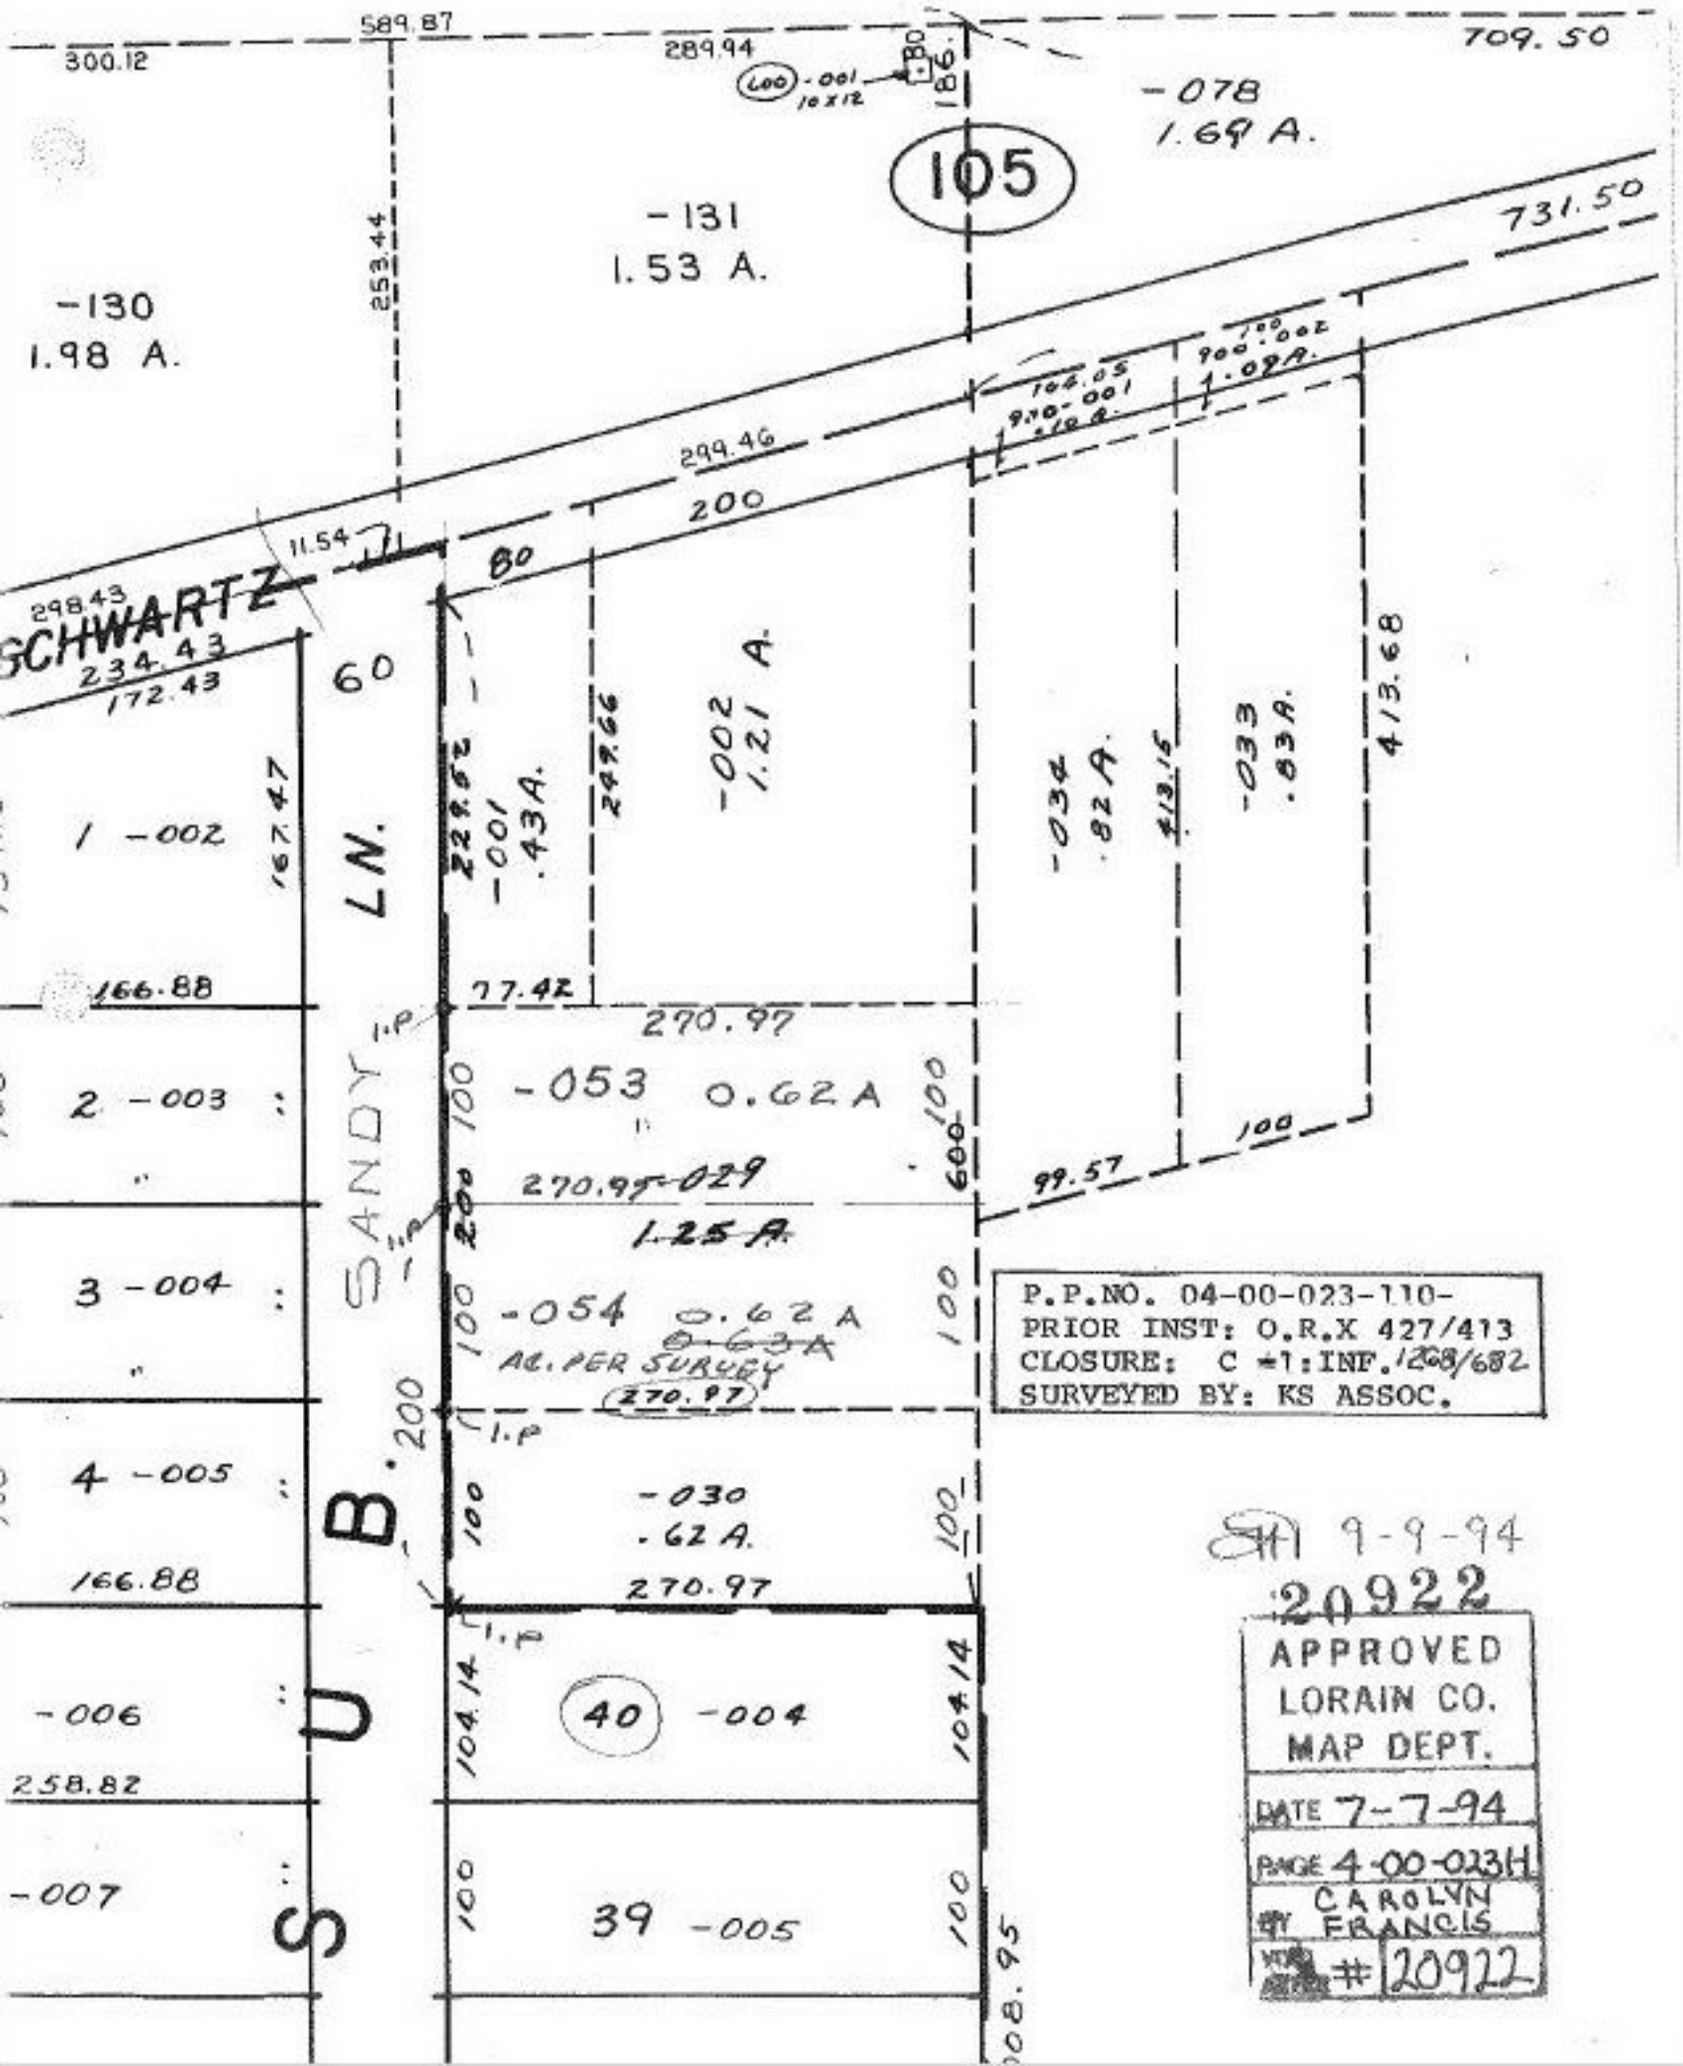
589.87
300.12
289.94
709.50
-078
1.69 A.
105
-131
1.53 A.
-130
1.98 A.
253.44
731.50
299.46
200
11.54
80
298.43
SCHWARTZ
234.43
172.43
60
SANDY LN.
S U B.
-001
.43A.
-002
1.21 A.
-034
.82A.
-033
.83A.
413.68
247.66
167.47
166.88
77.42
270.97
-053 0.62A
270.97
-029
1.25A.
-054 0.62A
0.63A
AC. PER SURVEY
270.97
-030
.62A.
270.97
104.14
40 -004
39 -005
258.82
-006
-007
P.P.NO. 04-00-023-110-
PRIOR INST: O.R.X 427/413
CLOSURE: C #1: INF. 268/682
SURVEYED BY: KS ASSOC.
9-9-94
20922
APPROVED
LORAIN CO.
MAP DEPT.
DATE 7-7-94
PAGE 4-00-023H
BY CAROLYN FRANCIS
20922