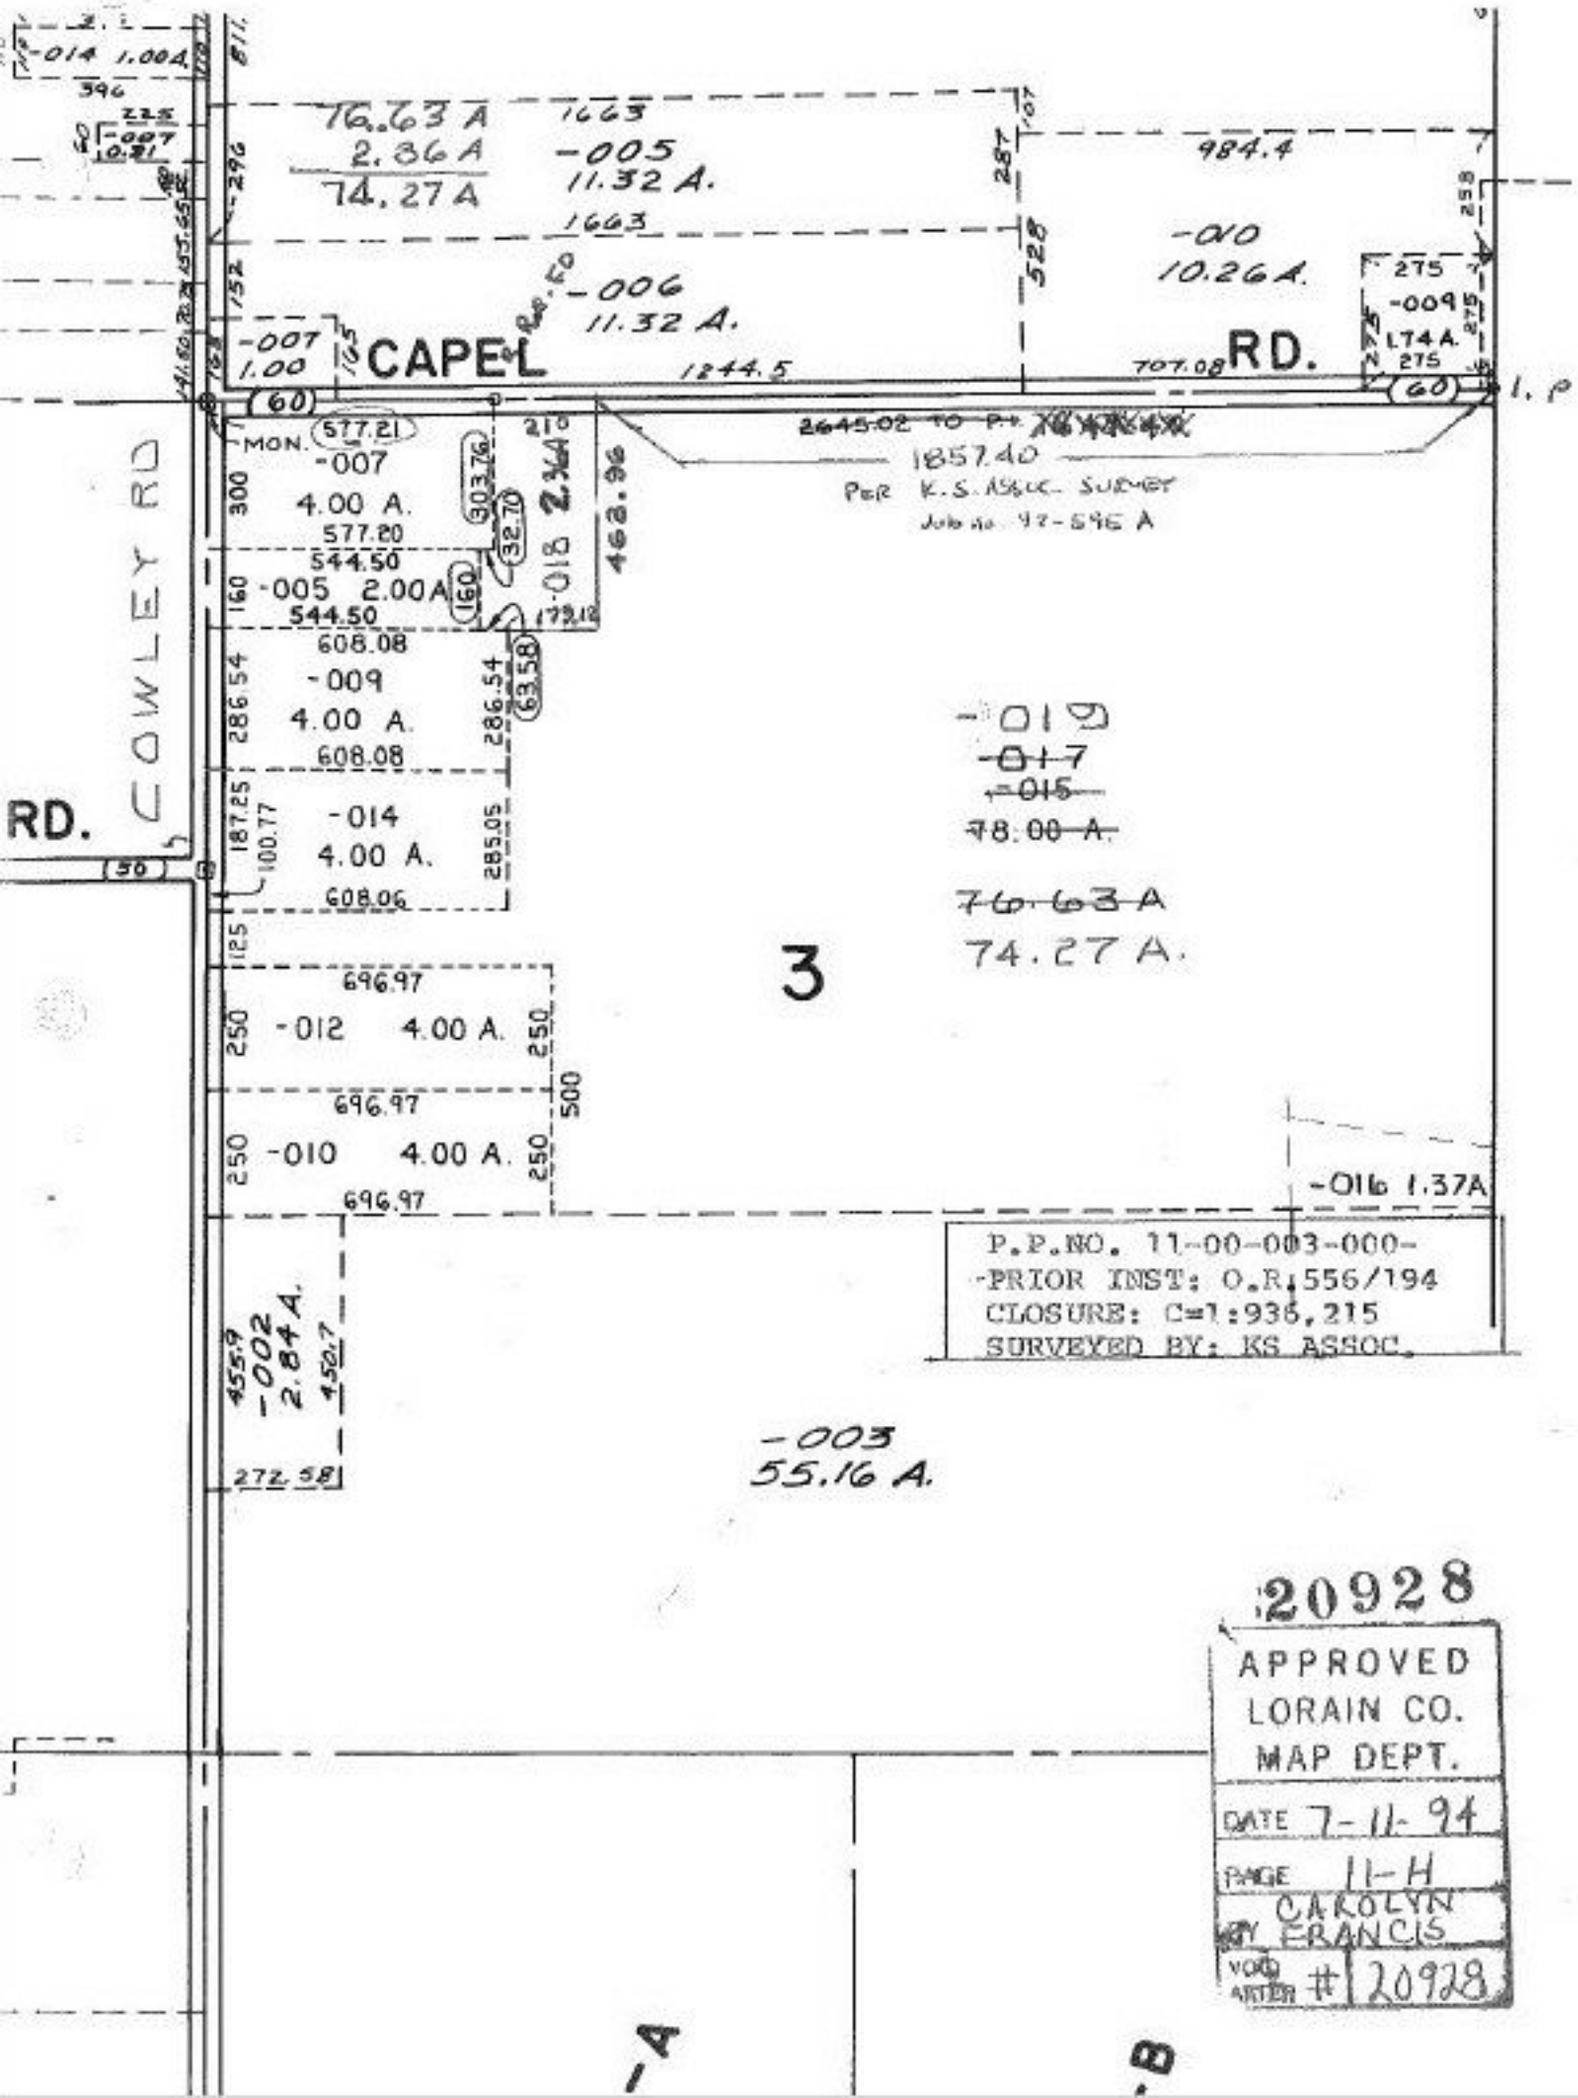
-014 1.00A.
396
-007
10.21
16.63 A
2.86 A
74.27 A
1663
-005
11.32 A.
1663
-006
11.32 A.
984.4
-010
10.26 A.
-007
1.00
CAPEL
RD.
1244.5
707.08
60
577.21
MON.
-007
4.00 A.
577.20
544.50
-005 2.00A
544.50
608.08
-009
4.00 A.
608.08
-014
4.00 A.
608.06
COWLEY RD
RD.
50
-018 2.36A
462.96
303.76
32.70
160
179.12
286.54
63.58
285.05
187.25
100.77
300
160
125
696.97
-012 4.00 A.
696.97
-010 4.00 A.
696.97
250
500
2645.02 TO P.T.
1857.40
PER K.S. ASSOC. SURVEY
Job No. 97-596 A
-019
-017
-015
78.00 A.
76.63 A
74.27 A.
3
-016 1.37A
P.P.NO. 11-00-003-000-
PRIOR INST: O.R. 556/194
CLOSURE: C=1:936,215
SURVEYED BY: KS ASSOC.
-002
2.84 A.
455.9
450.7
272.58
-003
55.16 A.
20928
APPROVED
LORAIN CO.
MAP DEPT.
DATE 7-11-94
PAGE 11-H
BY CAROLYN FRANCIS
VOID AFTER # 20928