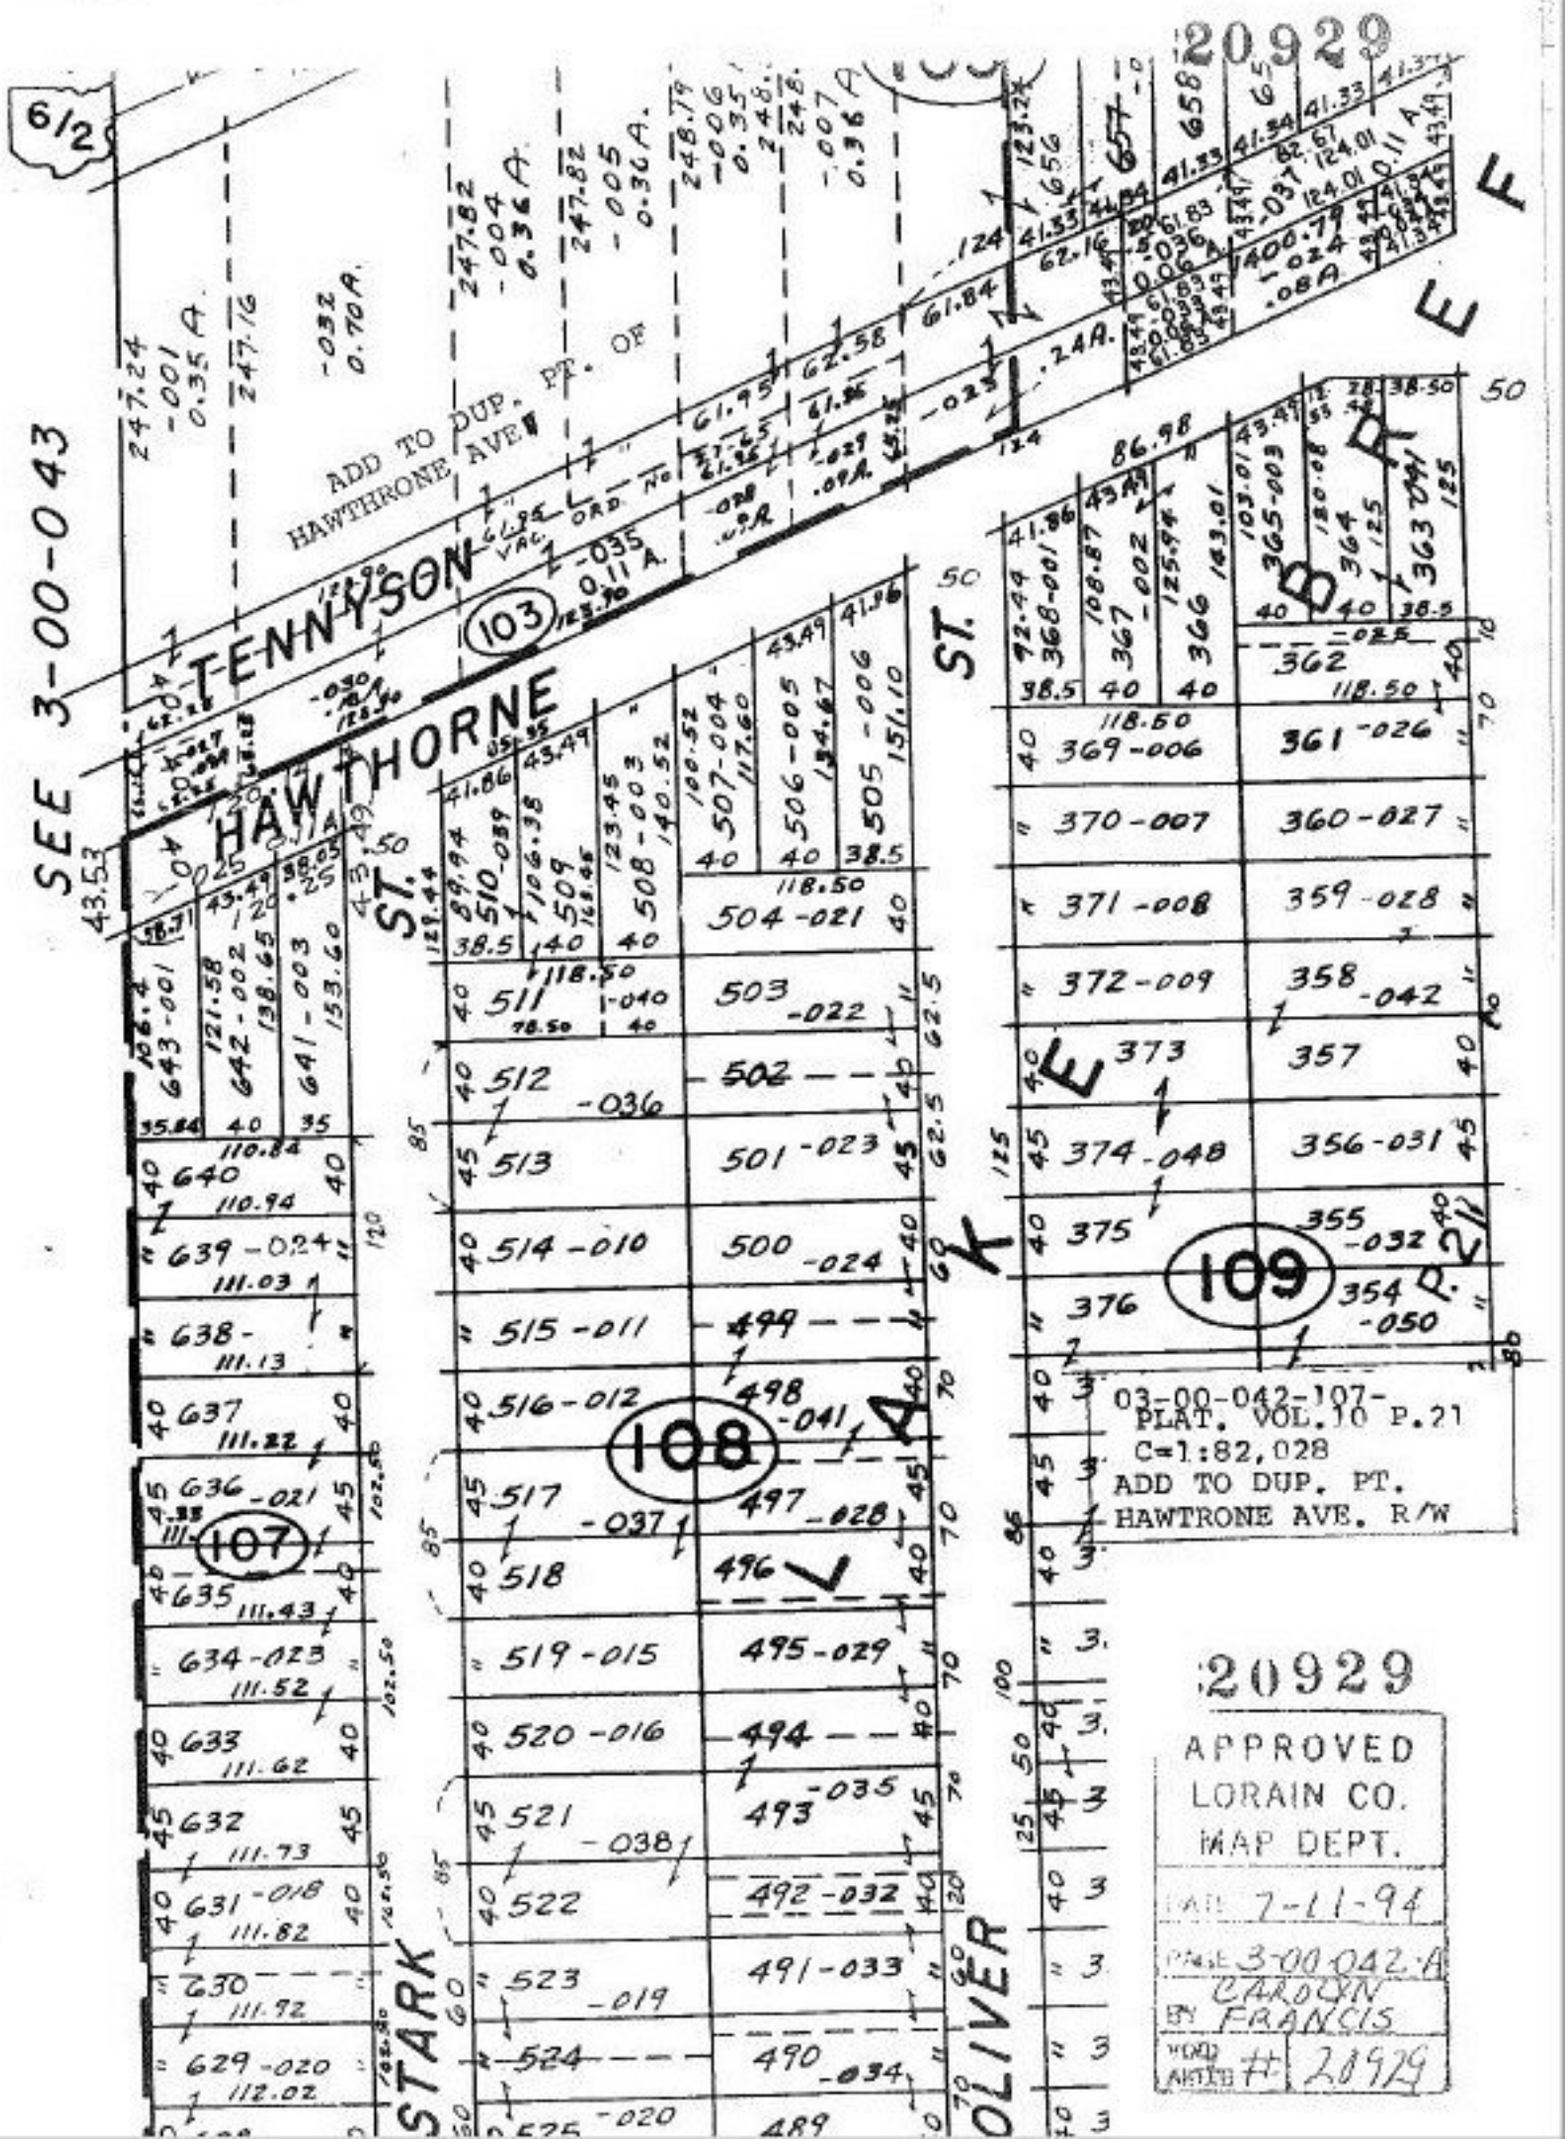
20929
SEE 3-00-043
TENNYSON
HAWTHORNE
ST.
ADD TO DUP. PT. OF HAWTHRONE AVE.
103
108
107
109
03-00-042-107-
PLAT. VOL. 10 P. 21
C=1:82,028
ADD TO DUP. PT.
HAWTRONE AVE. R/W
20929
APPROVED
LORAIN CO.
MAP DEPT.
DATE 7-11-94
PAGE 3-00-042-A
BY CAROLYN FRANCIS
WORD INDEX # 20929