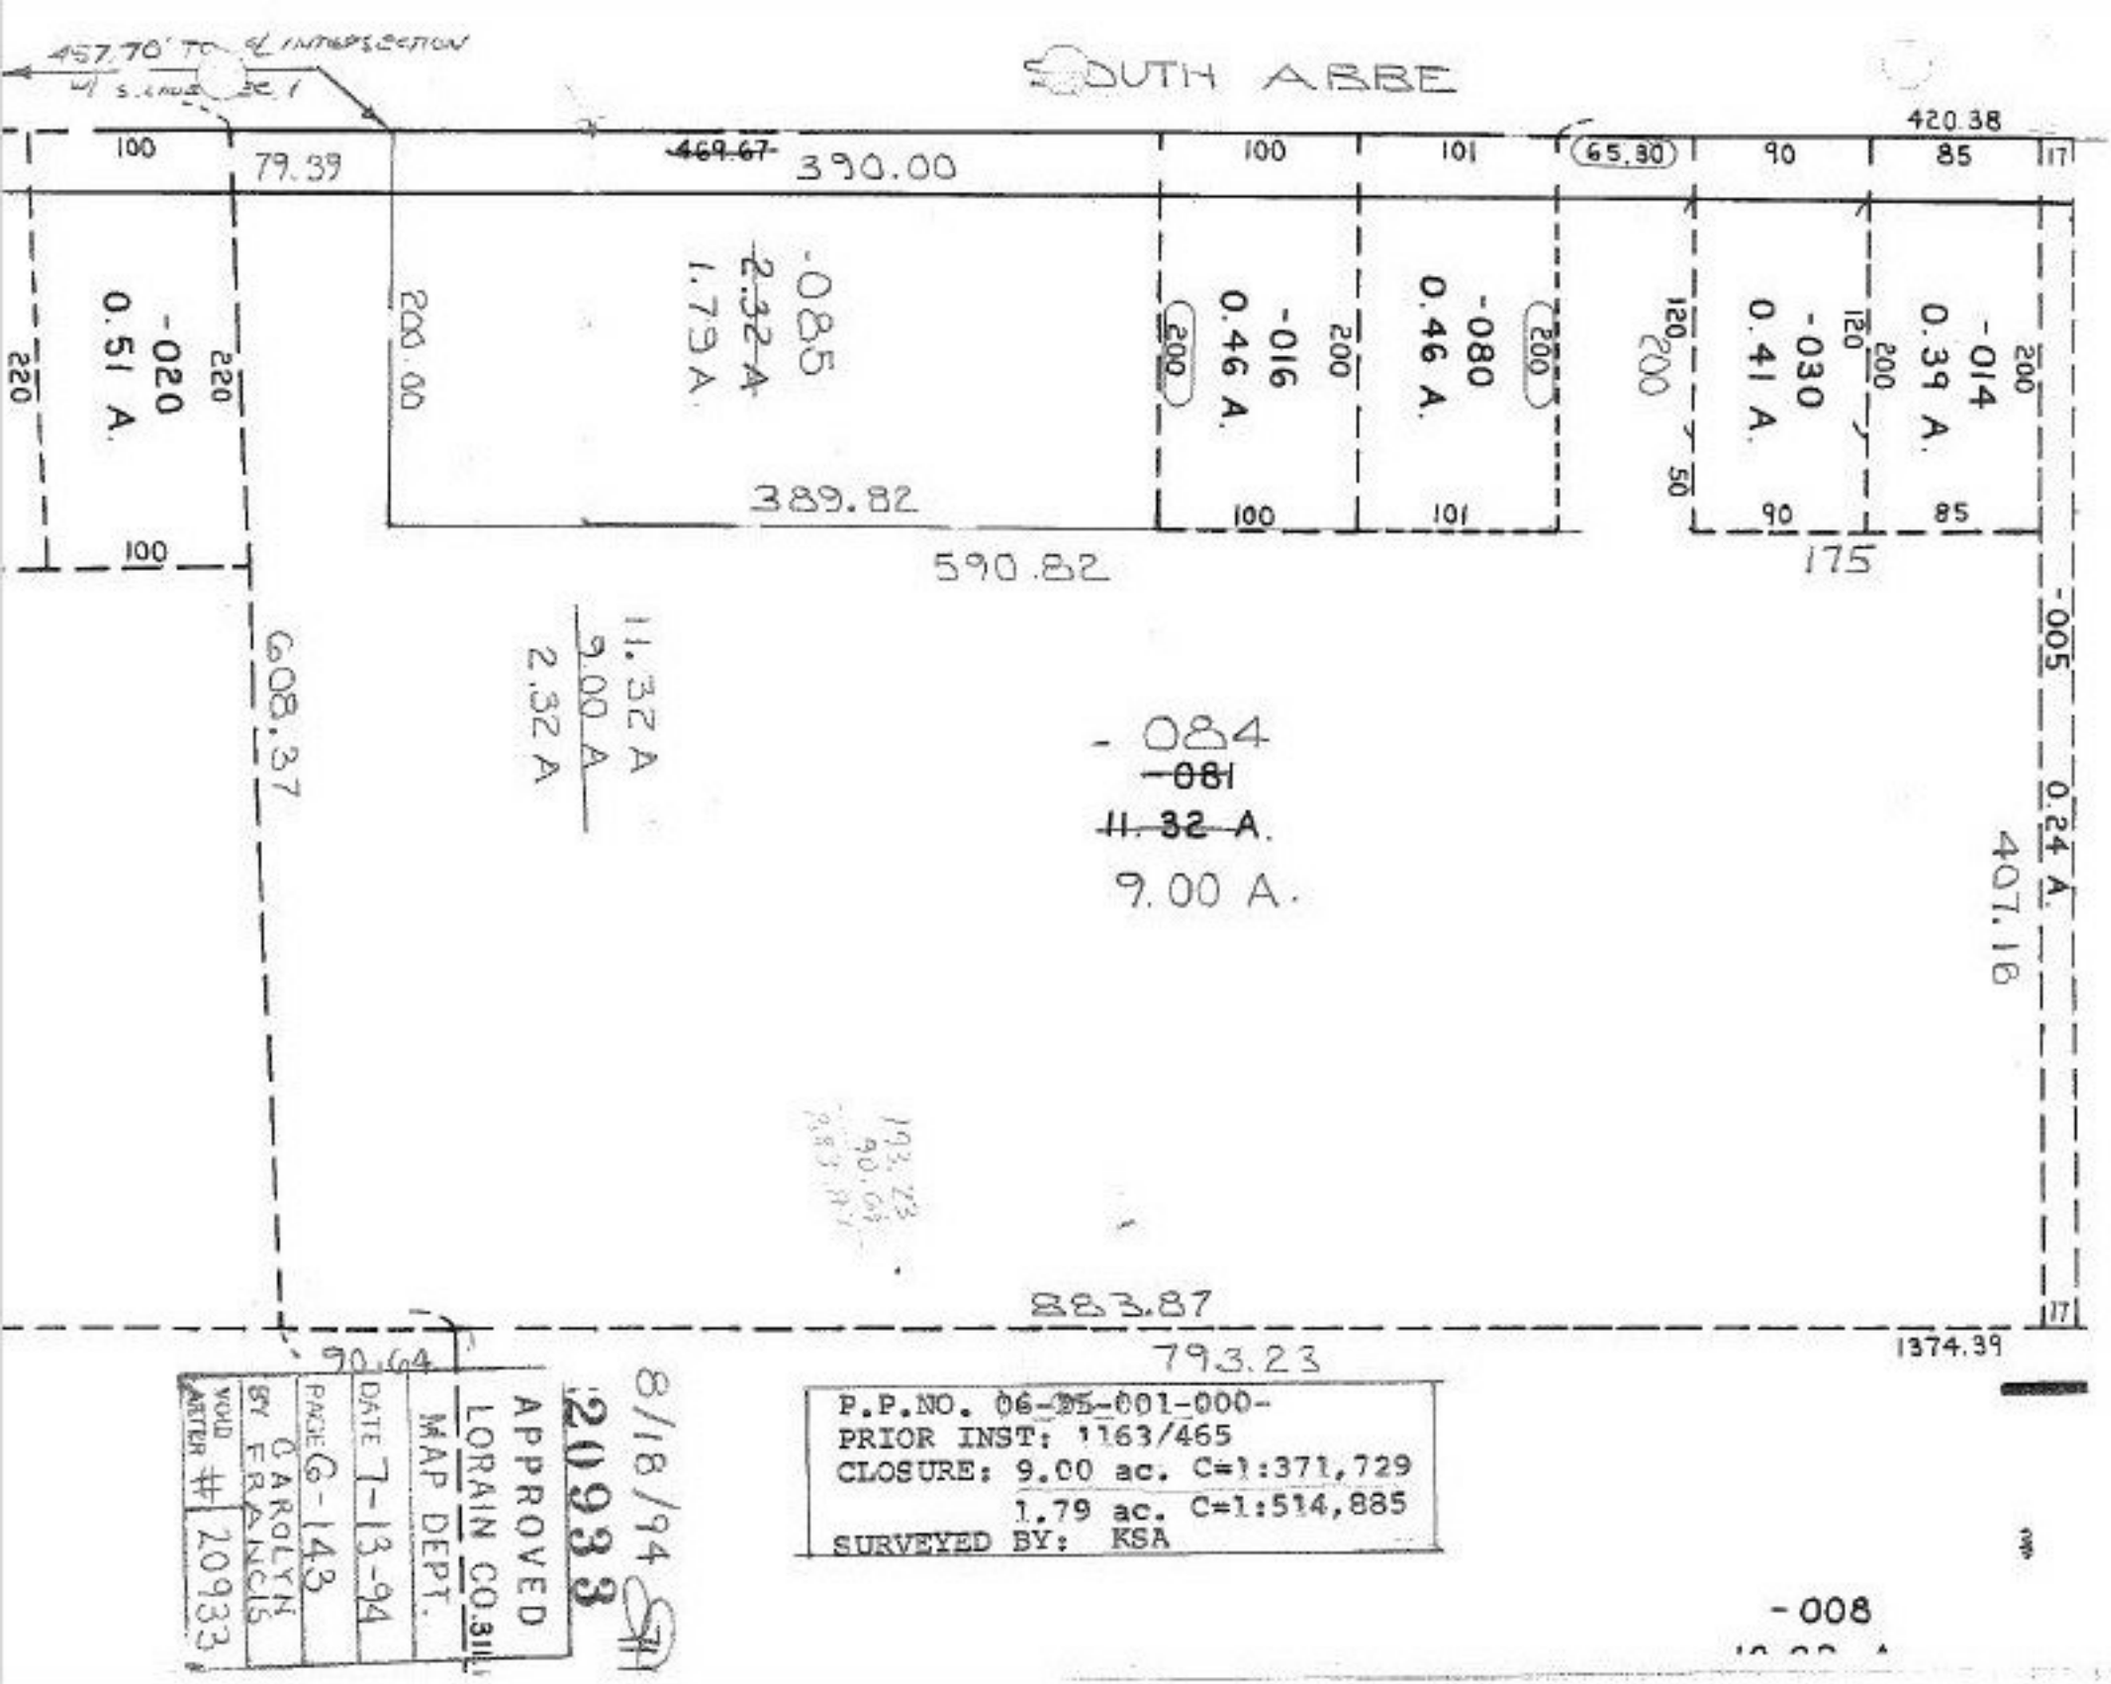
457.70' TO ℄ INTERSECTION
℄ SOUTH ABBE
420.38
100
79.39
469.67
390.00
100
101
65.30
90
85
17
-085
2.32 A
1.79 A.
-016
0.46 A.
-080
0.46 A.
-014
0.39 A.
-030
0.41 A.
-020
0.51 A.
200.00
389.82
590.82
175
608.37
11.32 A
9.00 A
2.32 A
-084
-081
11.32 A.
9.00 A.
-005
0.24 A.
407.16
883.87
793.23
1374.39
P.P.NO. 06-25-001-000-
PRIOR INST: 1163/465
CLOSURE: 9.00 ac. C=1:371,729
1.79 ac. C=1:514,885
SURVEYED BY: KSA
APPROVED
LORAIN CO.
MAP DEPT.
DATE 7-13-94
PAGE 6-143
BY CAROLYN FRANCIS
VOID AFTER #20933
8/18/94
20933
-008