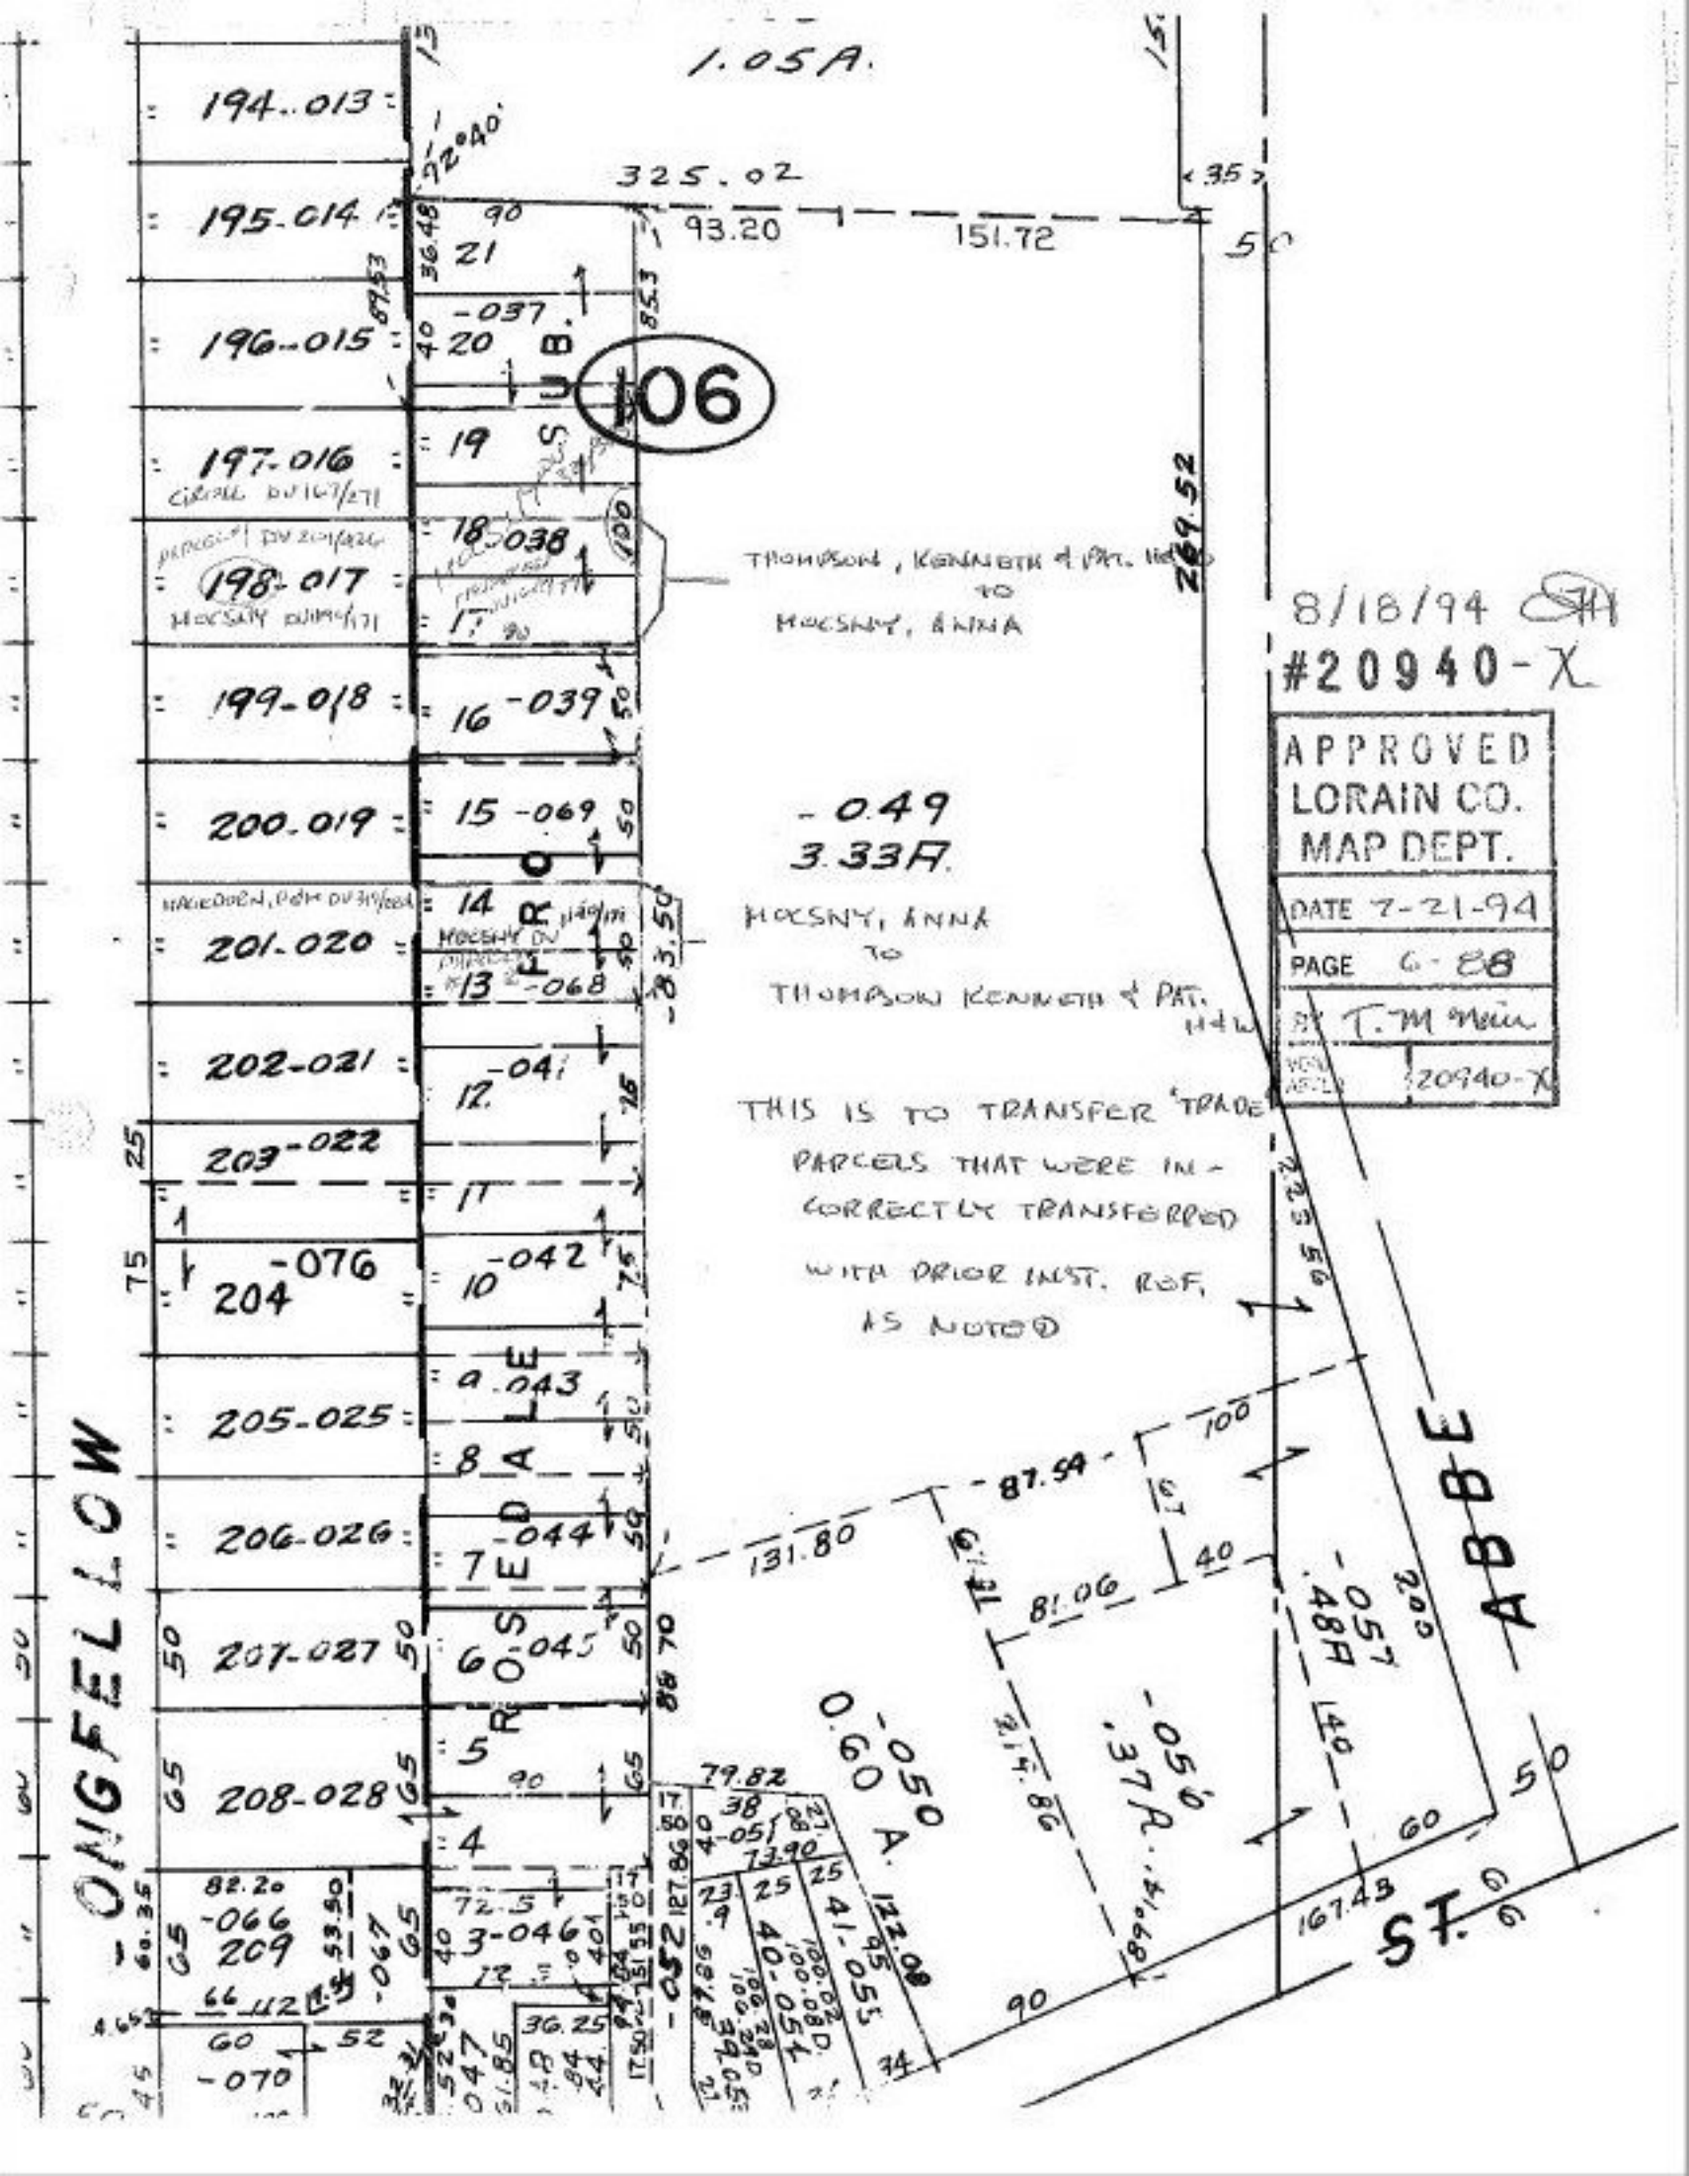
1.05A.
325.02
93.20
151.72
269.52
SUB.
06
194-013
195-014
196-015
197-016
198-017
199-018
200-019
201-020
202-021
203-022
204-076
205-025
206-026
207-027
208-028
209-066
209-067
209-070
209-052
209-047
21
20-037
19
18-038
17
16-039
15-069
14
13-068
12-041
11
10-042
9-043
8
7-044
6-045
5
4
3-046
-049
3.33A.
THOMPSON, KENNETH & PAT. H&W
TO
MOCSNY, ANNA
MOCSNY, ANNA
TO
THOMPSON KENNETH & PAT. H&W
THIS IS TO TRANSFER 'TRADE' PARCELS THAT WERE IN-CORRECTLY TRANSFERRED WITH PRIOR INST. REF. AS NOTED
8/18/94
#20940-X
APPROVED
LORAIN CO.
MAP DEPT.
DATE 7-21-94
PAGE 6-88
BY T.M Neu
WOR ASSIGN 20940-X
ONIGFELLOW
ABBE
ST.
-050
0.60 A.
-056
.37A.
-057
.48A.
-052
0.47
87.54
131.80
81.06
214.86
167.43
79.82
72.90
122.08
88.70
127.86
82.20
53.90
36.25
51.85