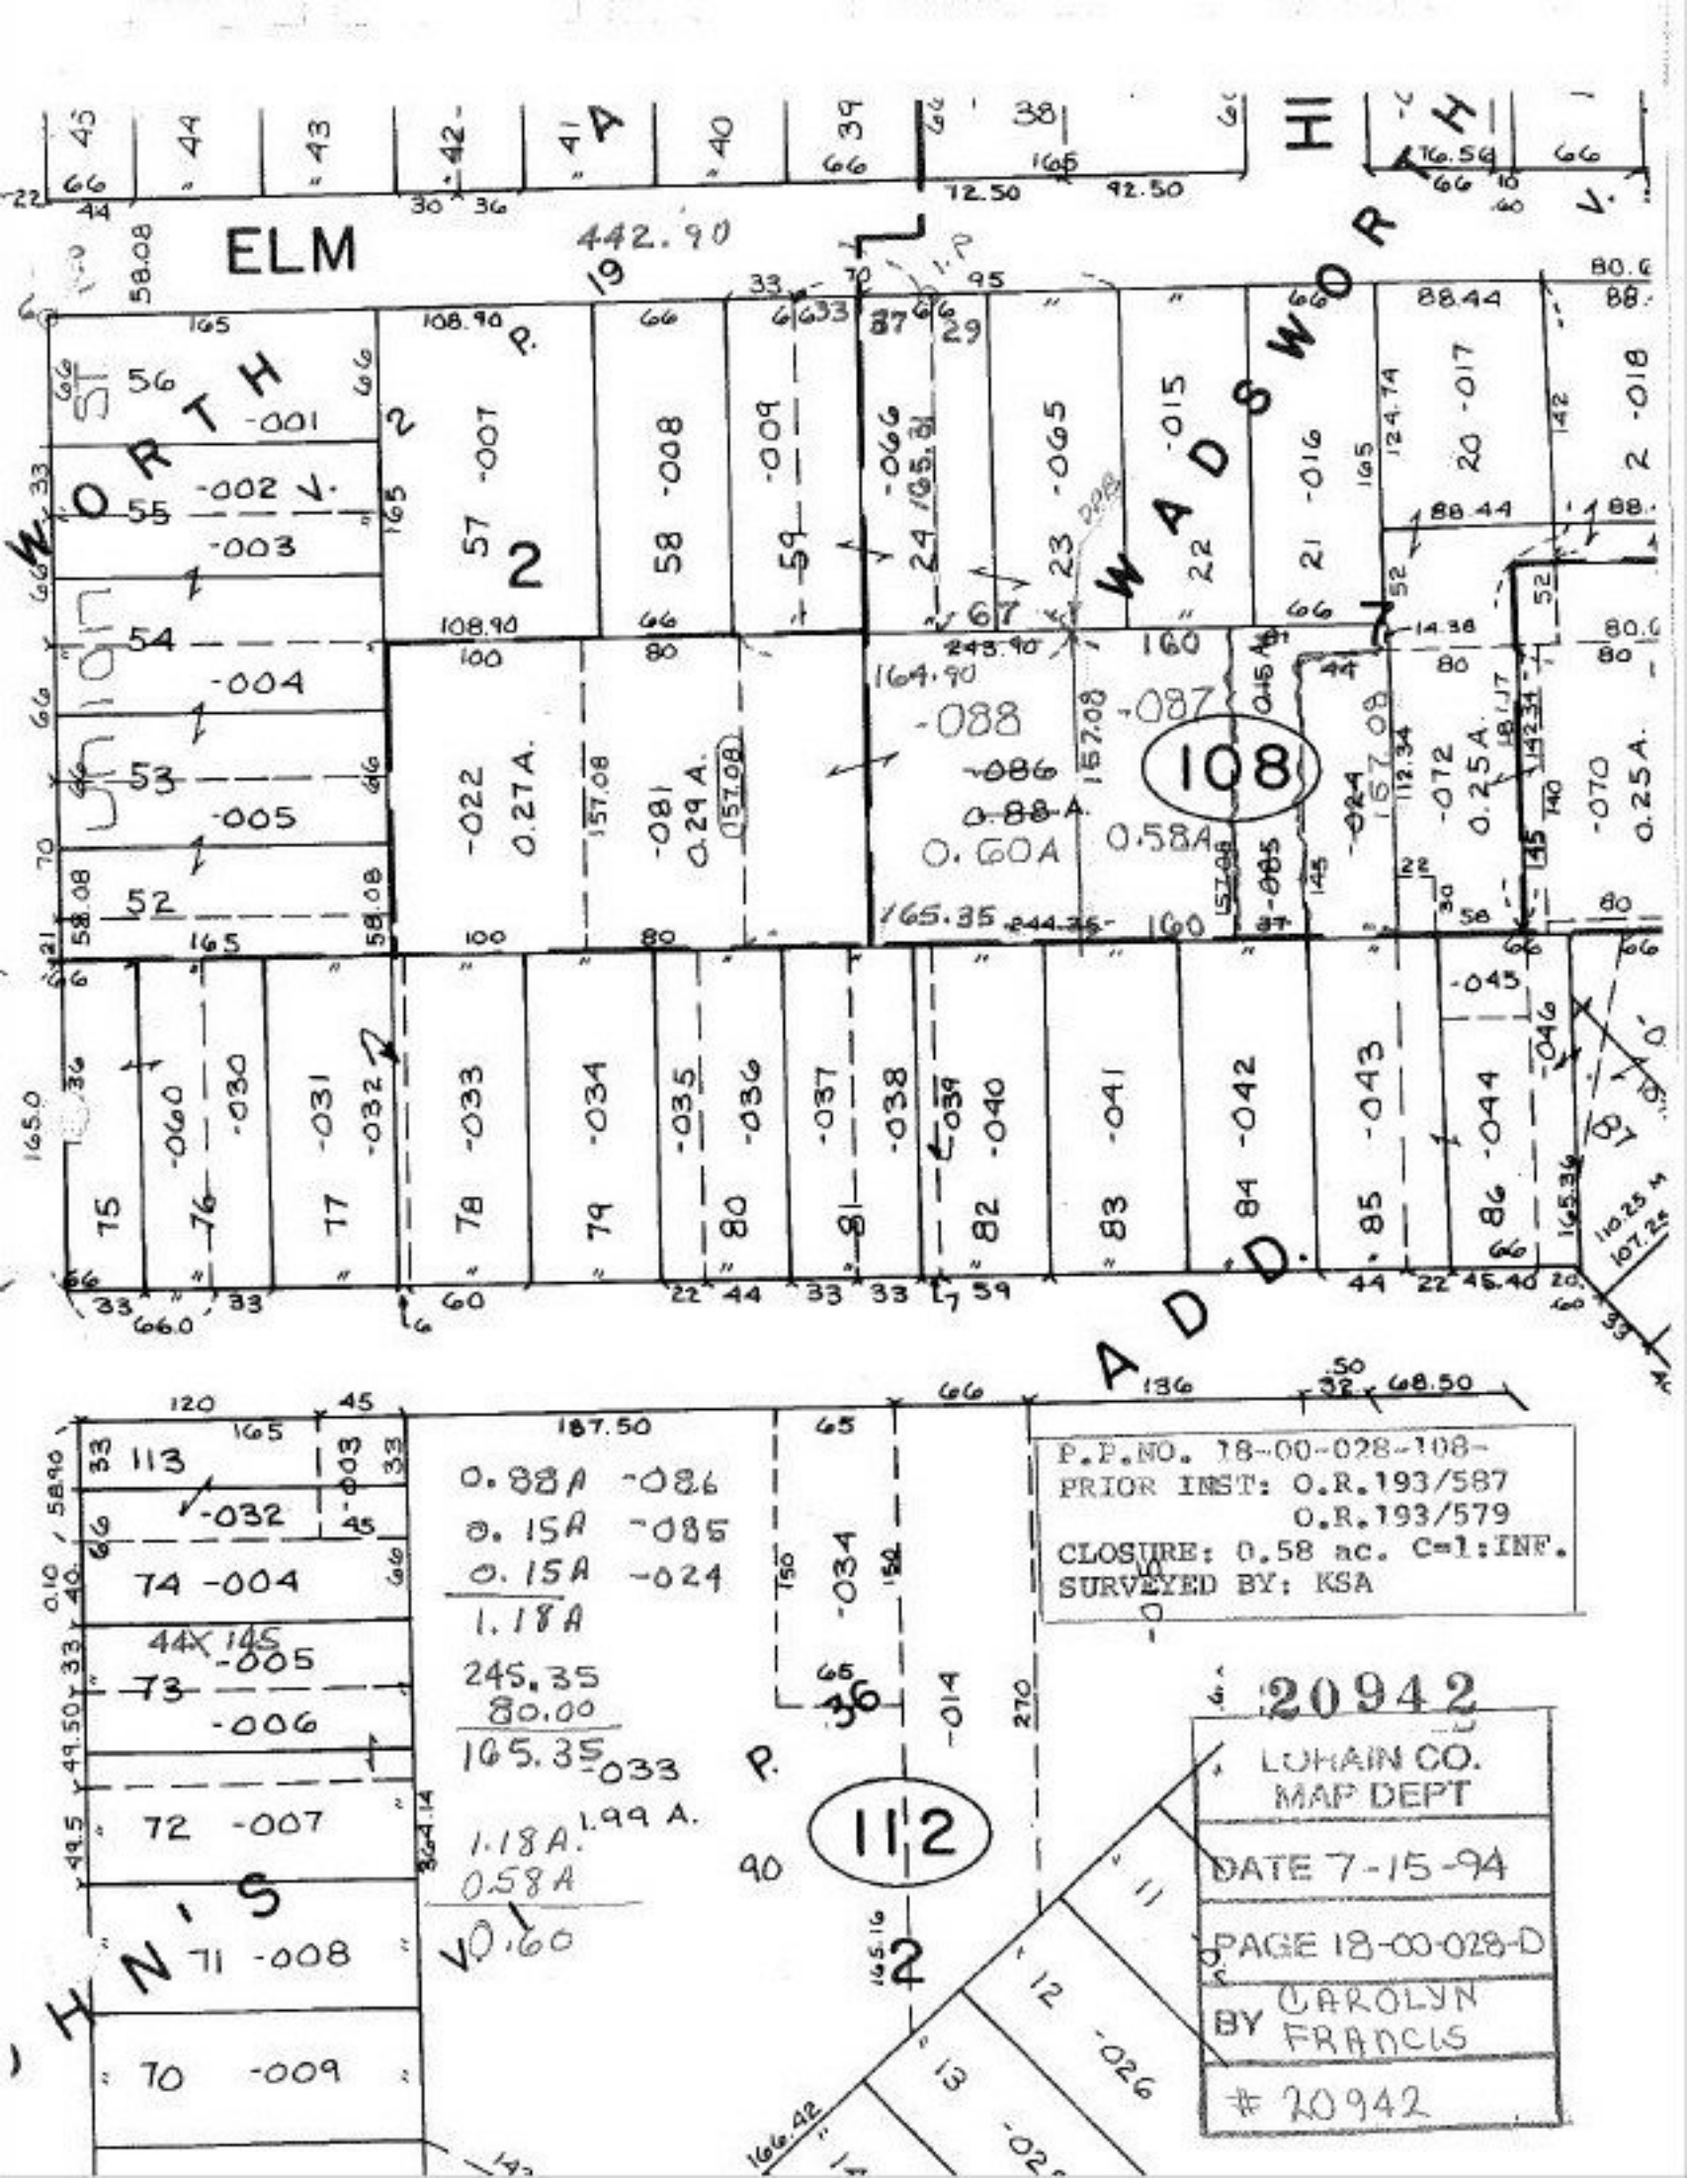
ELM
WADSWORTH
108
112
P.P.NO. 18-00-028-108-
PRIOR INST: O.R.193/587
O.R.193/579
CLOSURE: 0.58 ac. C=1:INF.
SURVEYED BY: KSA
20942
LORAIN CO.
MAP DEPT
DATE 7-15-94
PAGE 18-00-028-D
BY CAROLYN FRANCIS
20942