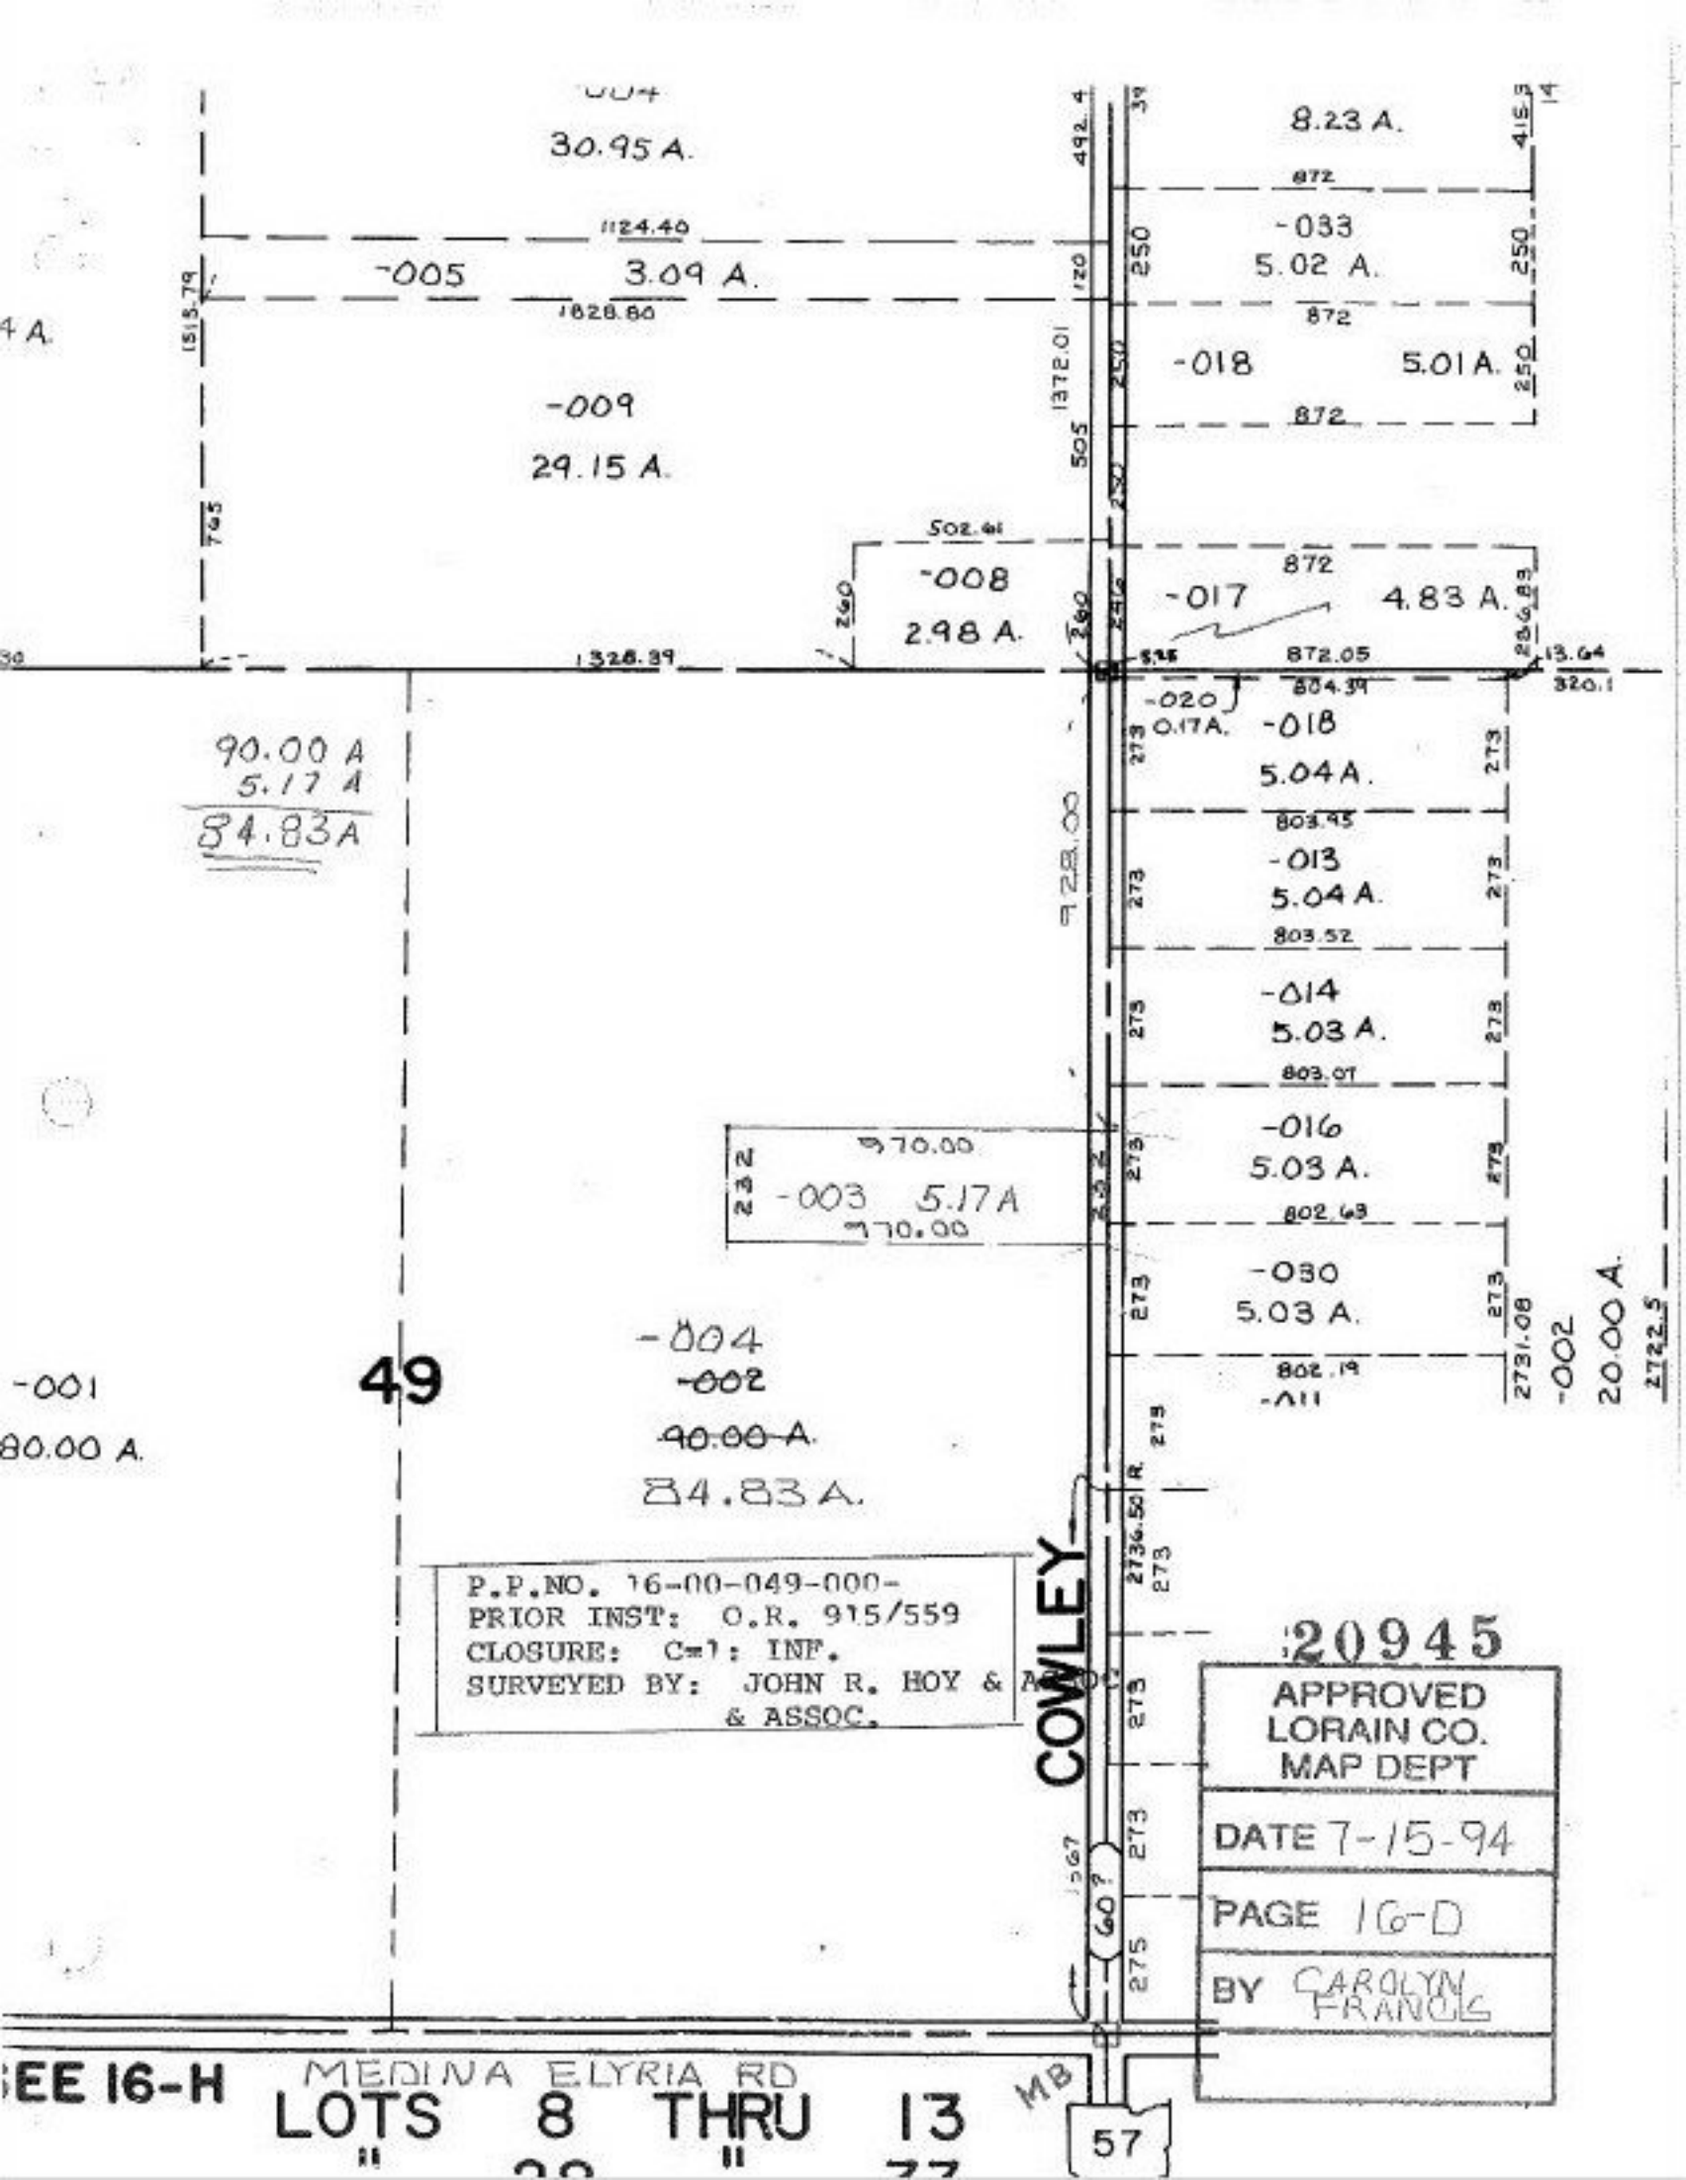

30.95 A.
8.23 A.
-033
5.02 A.
-005
3.09 A.
-018
5.01 A.
-009
29.15 A.
-008
2.98 A.
-017
4.83 A.
-020
0.17A.
-018
5.04 A.
-013
5.04 A.
-014
5.03 A.
-016
5.03 A.
-030
5.03 A.
-011
-002
20.00 A.
90.00 A
5.17 A
84.83A
-003 5.17A
-004
-002
90.00 A.
84.83 A.
-001
80.00 A.
49
COWLEY
P.P.NO. 16-00-049-000-
PRIOR INST: O.R. 915/559
CLOSURE: C=1: INF.
SURVEYED BY: JOHN R. HOY & ASSOC.
& ASSOC.
20945
APPROVED
LORAIN CO.
MAP DEPT
DATE 7-15-94
PAGE 16-D
BY CAROLYN FRANCIS
SEE 16-H
MEDINA ELYRIA RD
LOTS 8 THRU 13
57