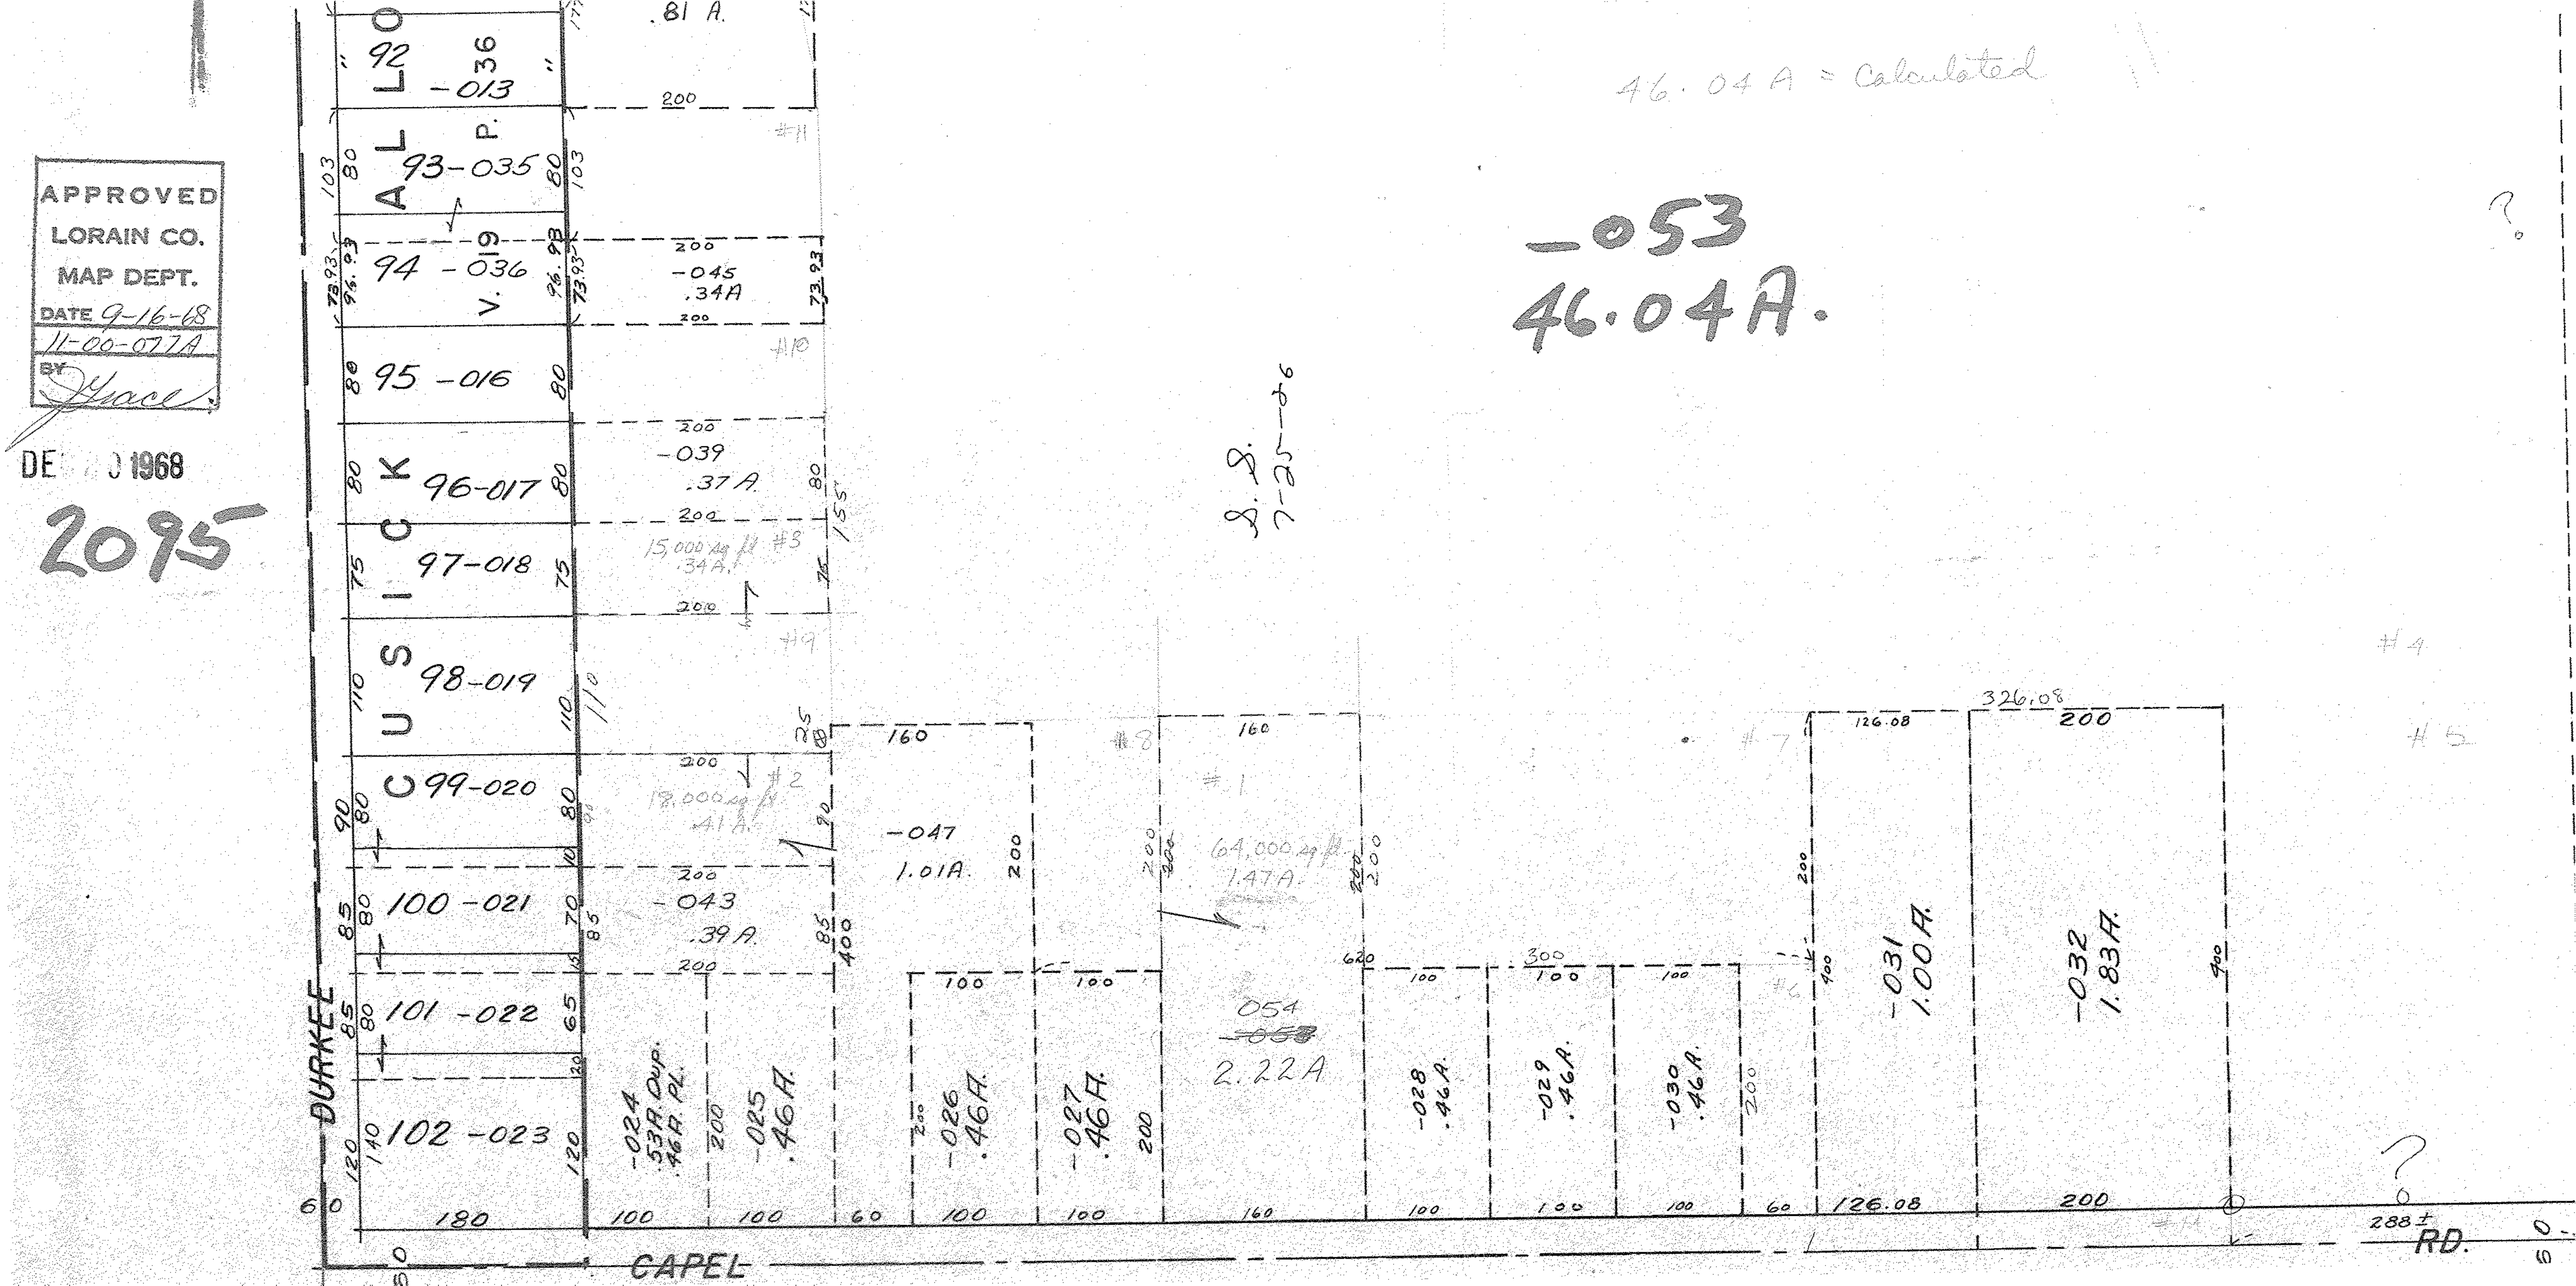
APPROVED
LORAIN CO.
MAP DEPT.
DATE 9-16-68
11-00-077A
BY
DE 0 1968
2095
46.04 A = Calculated
-053
46.04A.
L.S.
7-25-96
.81 A.
92 -013
93-035
94 -036
-045
.34A
95 -016
96-017
-039
.37A
97-018
15,000 sq ft
.34A.
98-019
99-020
18,000 sq ft
.41 A.
100 -021
-043
.39A
101 -022
102 -023
-024 Dup.
.53A Pcl.
.46A.
-025
.46A.
-026
.46A.
-027
.46A.
-047
1.01A.
64,000 sq ft.
1.47A.
054
2.22A
-028
.46A.
-029
.46A.
-030
.46A.
-031
1.00A.
-032
1.83A.
DURKEE
CAPEL
RD.
288±