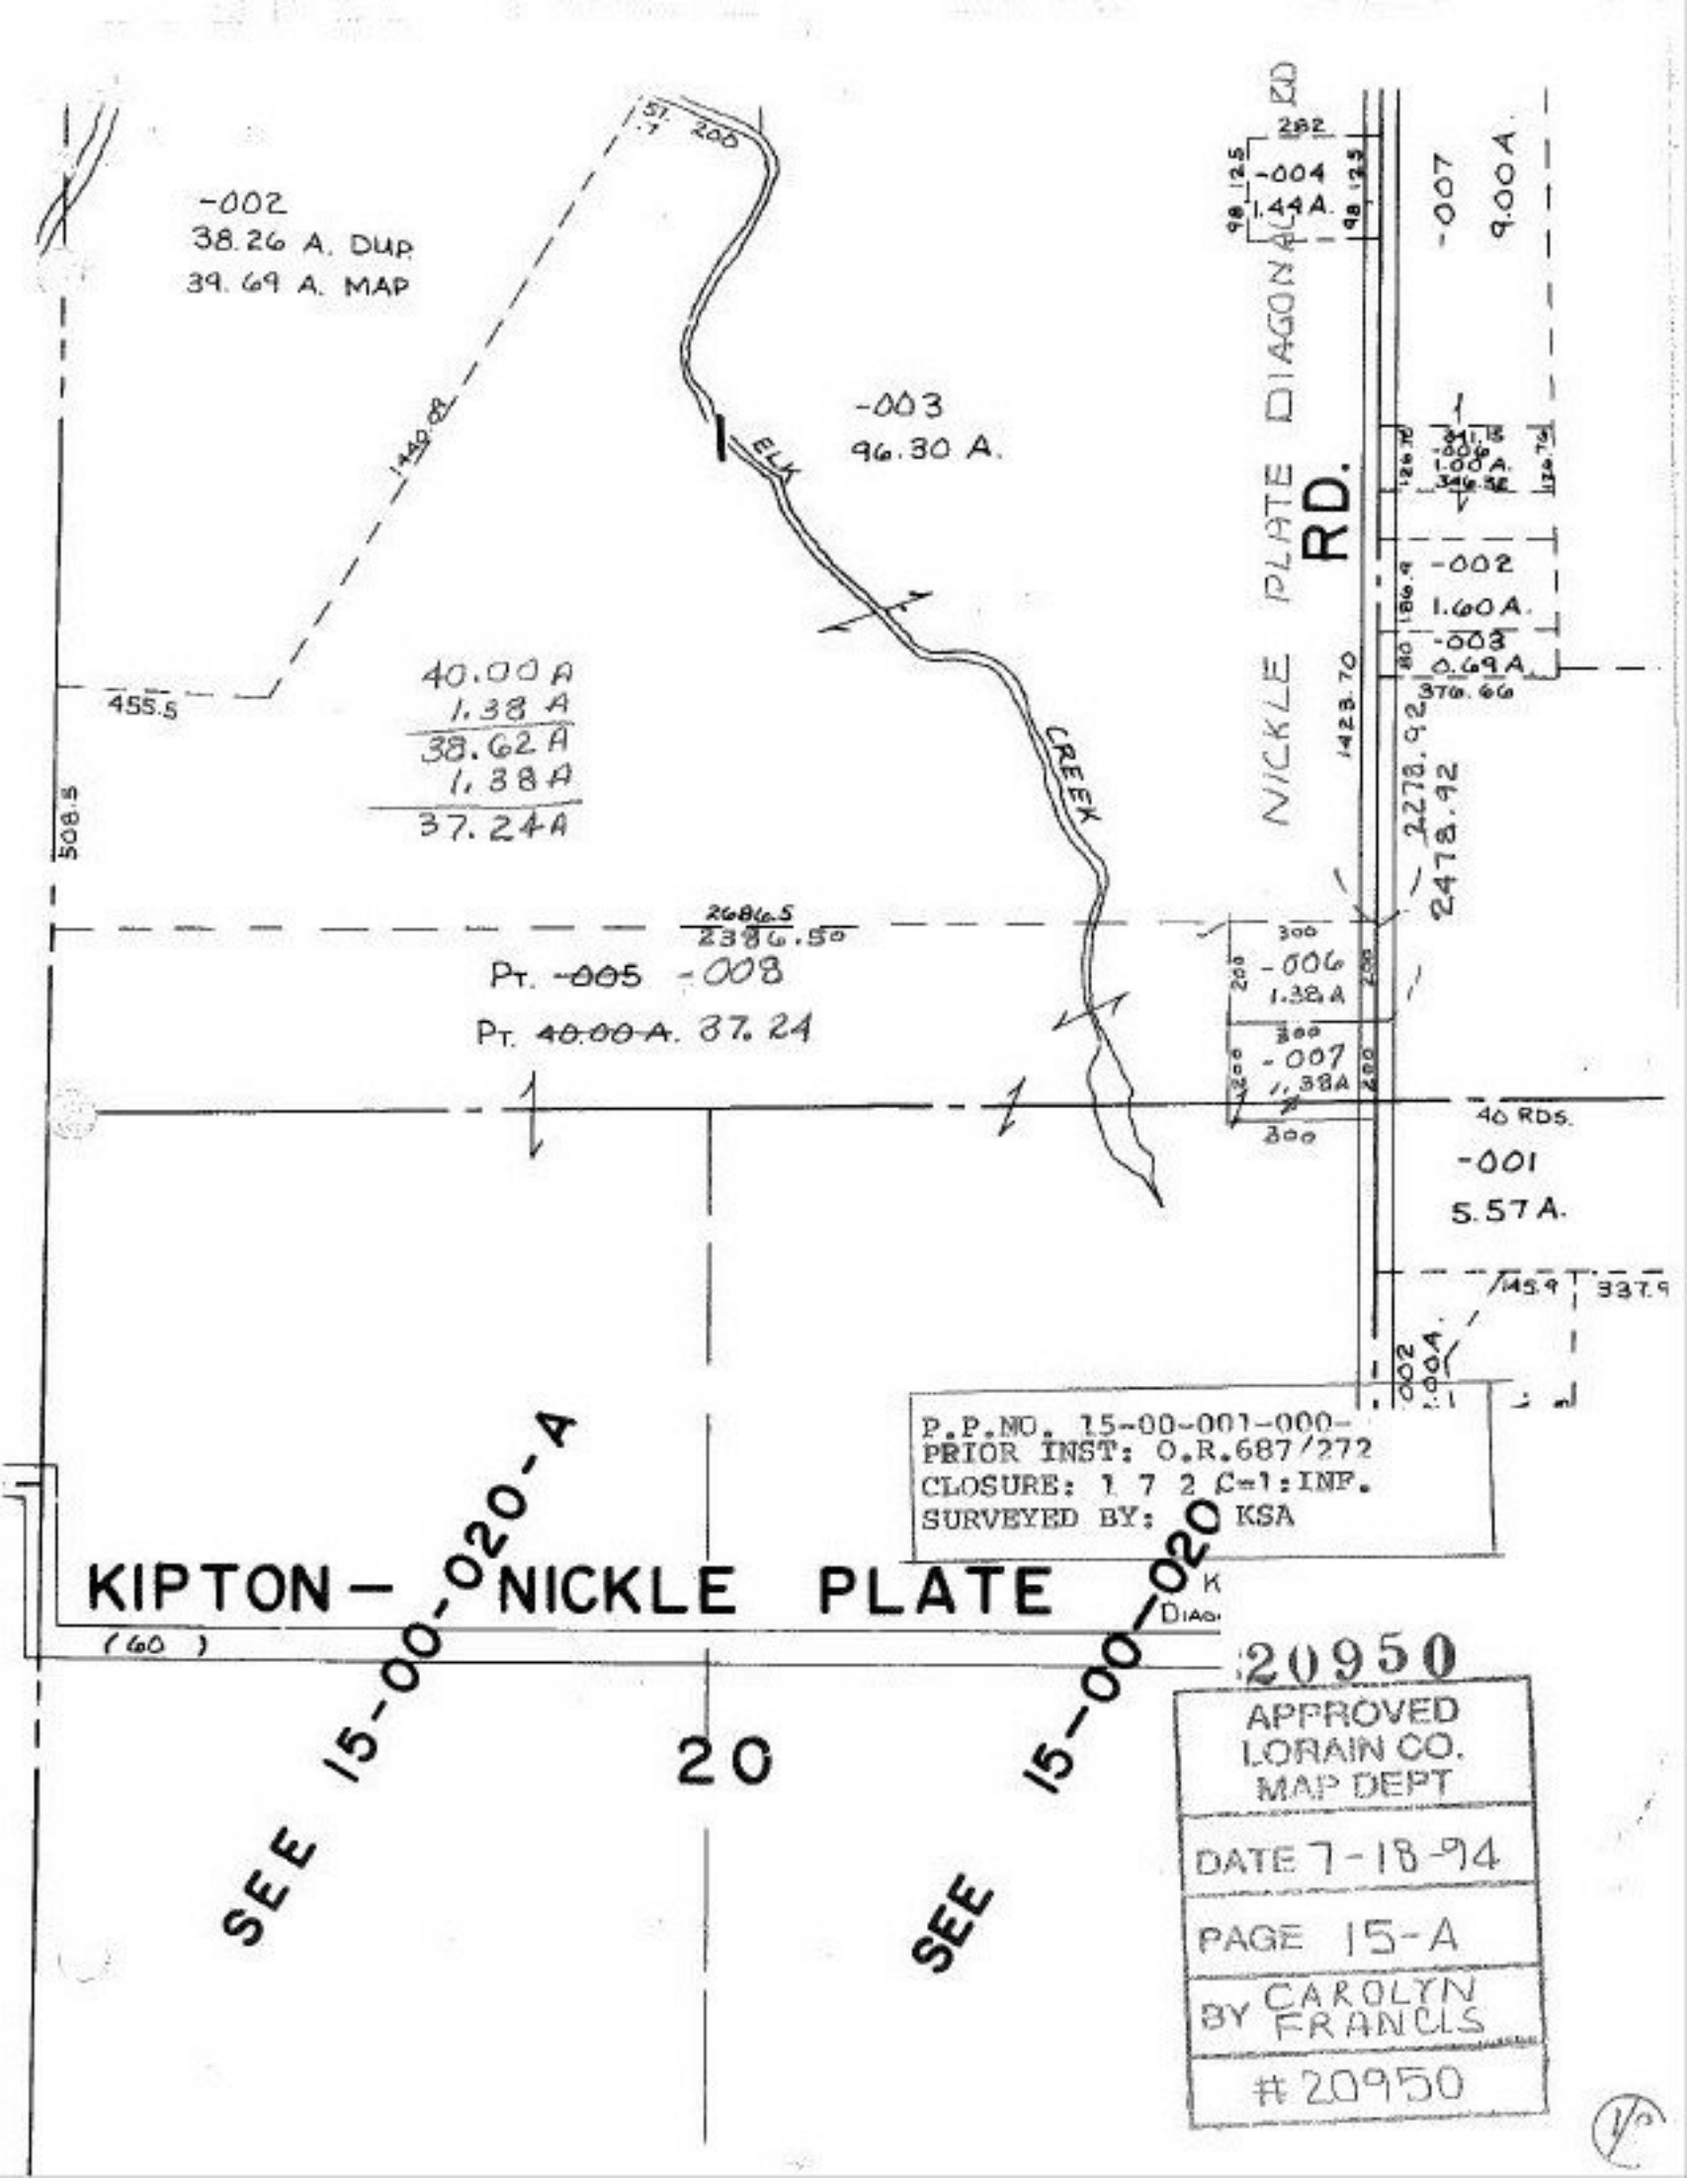
-002
38.26 A. DUP.
39.69 A. MAP
1449.68
455.5
508.5
40.00 A
1.38 A
38.62 A
1.38 A
37.24 A
-003
96.30 A.
ELK
CREEK
NICKLE PLATE DIAGONAL RD
RD.
-004
1.44 A.
-007
9.00 A.
-005
1.00 A.
-002
1.60 A.
-003
0.69 A.
1423.70
2278.92
2478.92
2686.5
2386.50
PT. -005 -008
PT. 40.00 A. 37.24
-006
1.38 A
-007
1.38 A
40 RDS.
-001
5.57 A.
145.9
337.9
-002
1.00 A.
P.P.NO. 15-00-001-000-
PRIOR INST: O.R.687/272
CLOSURE: 1 7 2 C=1:INF.
SURVEYED BY: KSA
KIPTON — NICKLE PLATE
(60)
SEE 15-00-020-A
20
SEE 15-00-020
20950
APPROVED
LORAIN CO.
MAP DEPT
DATE 7-18-94
PAGE 15-A
BY CAROLYN FRANCIS
#20950